


zoning permit # 2542  
 issued Aug 9-73  
*[Signature]*

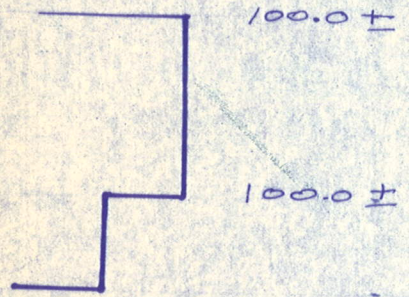


Grading Plan App  
 as shown and/or not  
 THOMAS P. GILLES, P.E.  
 Lake County Engineer

By D.J.L. Date 8/14/73

ASSUM. T.B.M. N/S. 06  
 OF POLE # 582491 EL. 100.00

15' ASPHALT  
 PAVT

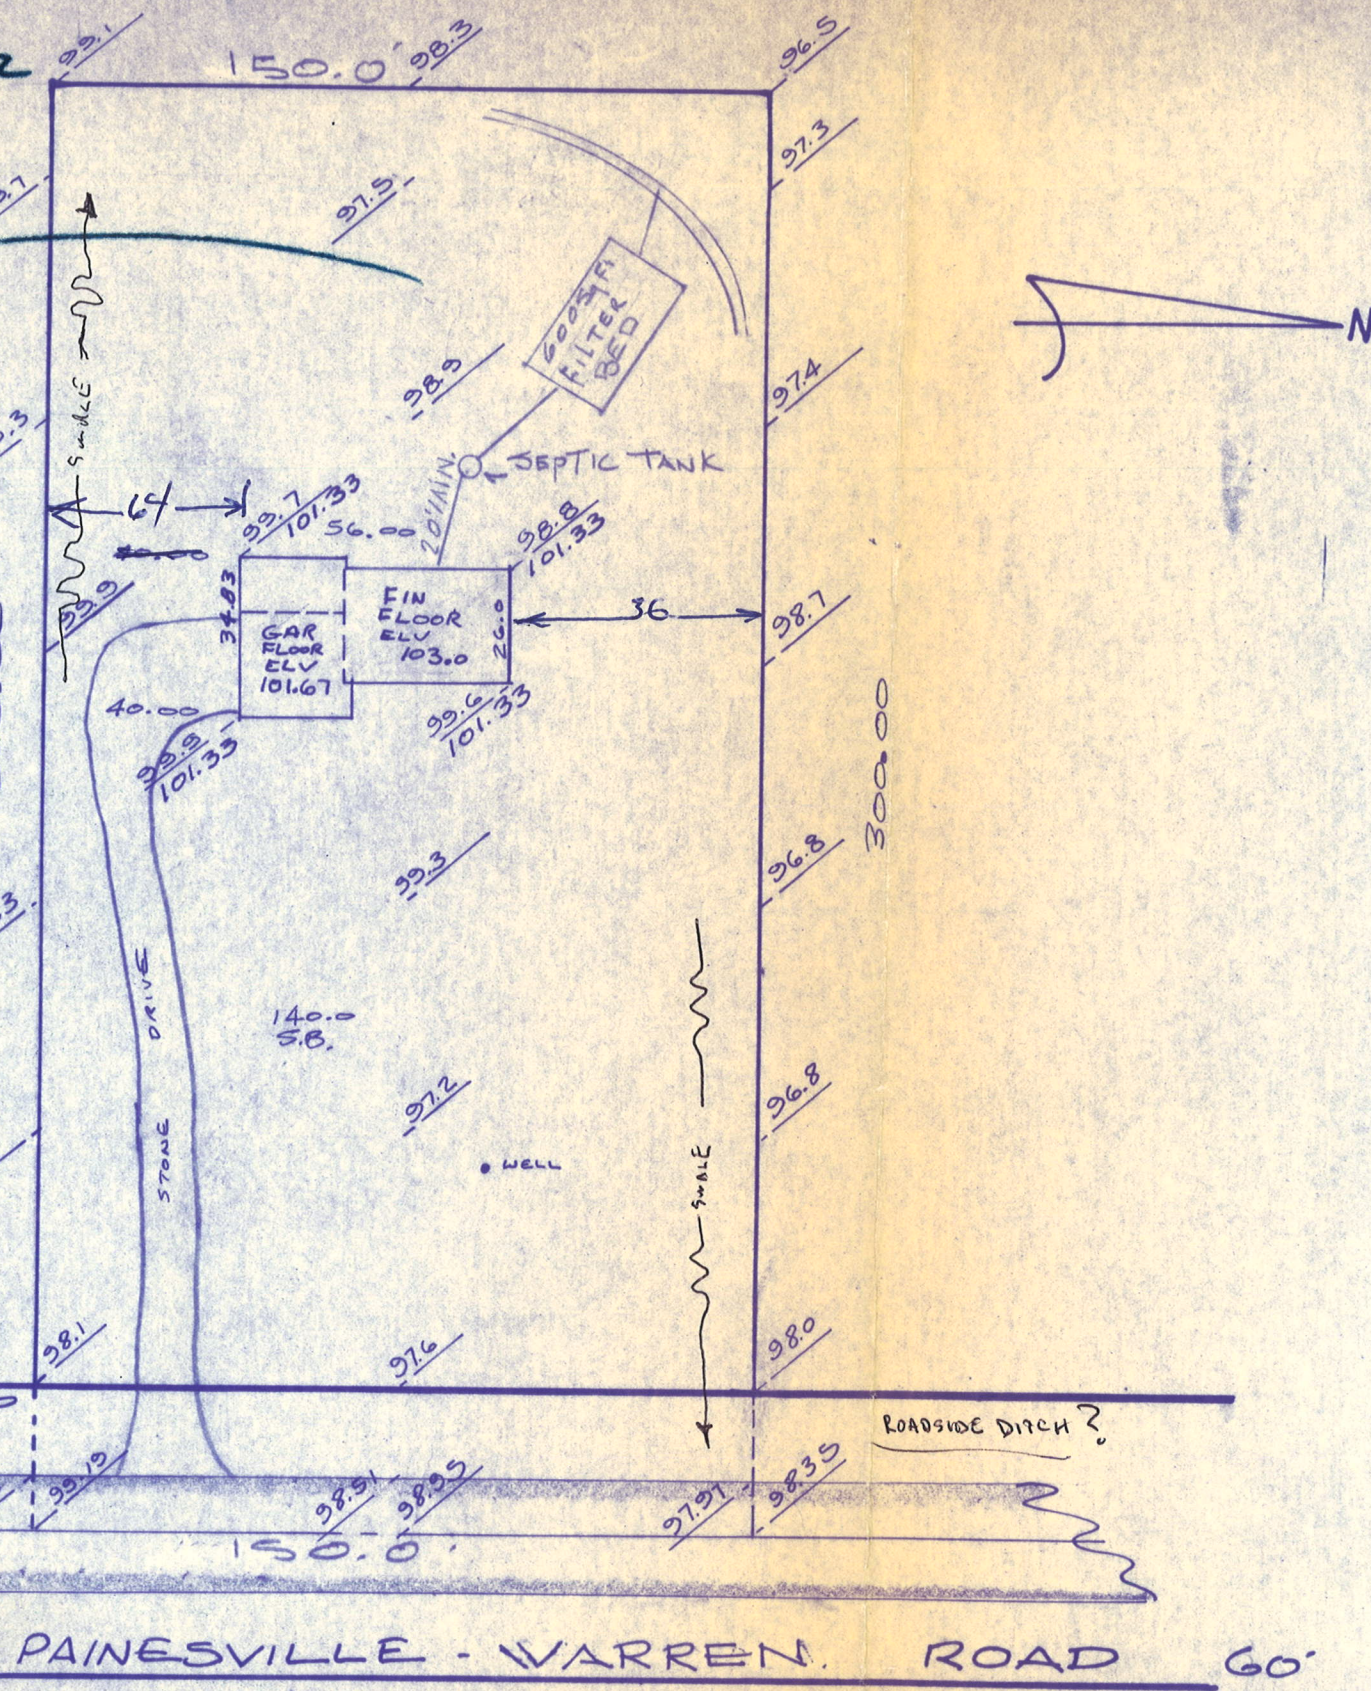

PAINESVILLE - WARREN ROAD 60'

"AS BUILT" CERTIFICATION

I HEREBY CERTIFY THAT THE CIRCLED GRADES ARE EXISTING FINISH GRADES CHECKED IN FIELD ON \_\_\_\_\_ 19\_\_ BY SURVEYING AND ARE CORRECT TO THE BEST OF MY KNOWLEDGE AND BELIEF

REGISTERED SURVEYOR \_\_\_\_\_ NO. \_\_\_\_\_

SITE PLAN

CONCORD TOWNSHIP LAKE COUNTY, OHIO  
 for CARL BYSTROM CLIENT OWNER  
 8868 LAKE OVERLOOK DR., MENTOR ADDRESS STREET CITY ZIP

<del>SUBDIVISION</del>		NO 6 LOT	NO 2 TRACT
<del>VOLUME - PAGE</del>		VOLUME 2 NEW PARCEL	PAGE
<del>SUBLOT NO</del>		FERM. PARCEL #	STREET

LEGEND

- SANITARY MANHOLE
- STORM MANHOLE
- INLET OR CATCH BASIN
- HYDRANT
- EXISTING CONTOUR
- PROPOSED CONTOUR
- EXIST ELEV. 100.0
- PROP. ELEV. 100.0
- WATER VALVE (GAS)
- WATER METER (GAS)
- AS BUILT ELEVATION
- INDICATES DIRECTION OF SURFACE DRAINAGE

REMARKS

ALL BOUNDARY DATA SHOWN WAS OBTAINED FROM (DEEDS RECORDED SUBDIVISION PLAT, OR OTHER PUBLIC RECORDS)

DESIGN CERTIFICATION

THIS PLAT WAS PREPARED BY ME, AND IS CORRECT TO THE BEST OF MY KNOWLEDGE AND BELIEF

*Richard J. Disko* PS#5244  
 NAME SURVEYOR REGISTRATION NO

CHECK LIST

- DIMENSIONS
- BEARINGS
- TIE TO NEAREST STREET
- SUBLOT NO PARCEL NO
- SURROUNDING OWNERS
- BLDG DIMENSIONS FIN GR
- BLDG TIES FLR GRADES
- APRON TYPE WIDTH THICKNESS
- SI EWALK TYPE WILTH THICKNESS
- CULVERT TYPE DIA LENGTH
- WATER MAIN SIZE LOCATION
- SAN SEWER SIZE % GR LOC
- SAN MH CAST ELEV INV ELEV
- SAN CONN SIZE LOC DEPTH
- ST RM SEWER SIZE % GR LOC
- ST RM MH CAST ELEV INV ELEV
- PAVT TYPE GRADE
- GAS LINE
- SEPT TANK SIZE
- WE LOCAT N

REVISIONS		
NO	DATE	BY
1		
2		
3		
4		
5		

PLAN PREPARED BY  
 DEBEVEL SALO & ASSOC., INC.  
 NAME  
 130 E. JACKSON ST. PAINESVILLE, O.  
 ADDRESS

DRAWN BY *[Signature]* SCALE 1"=40'  
 CHK *[Signature]* DATE Jun 4, 1973 DRAWING NO  
 CREW CHIEF APP'D 3827-2