
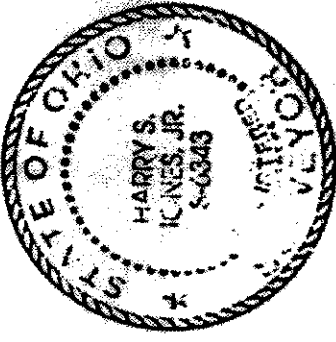
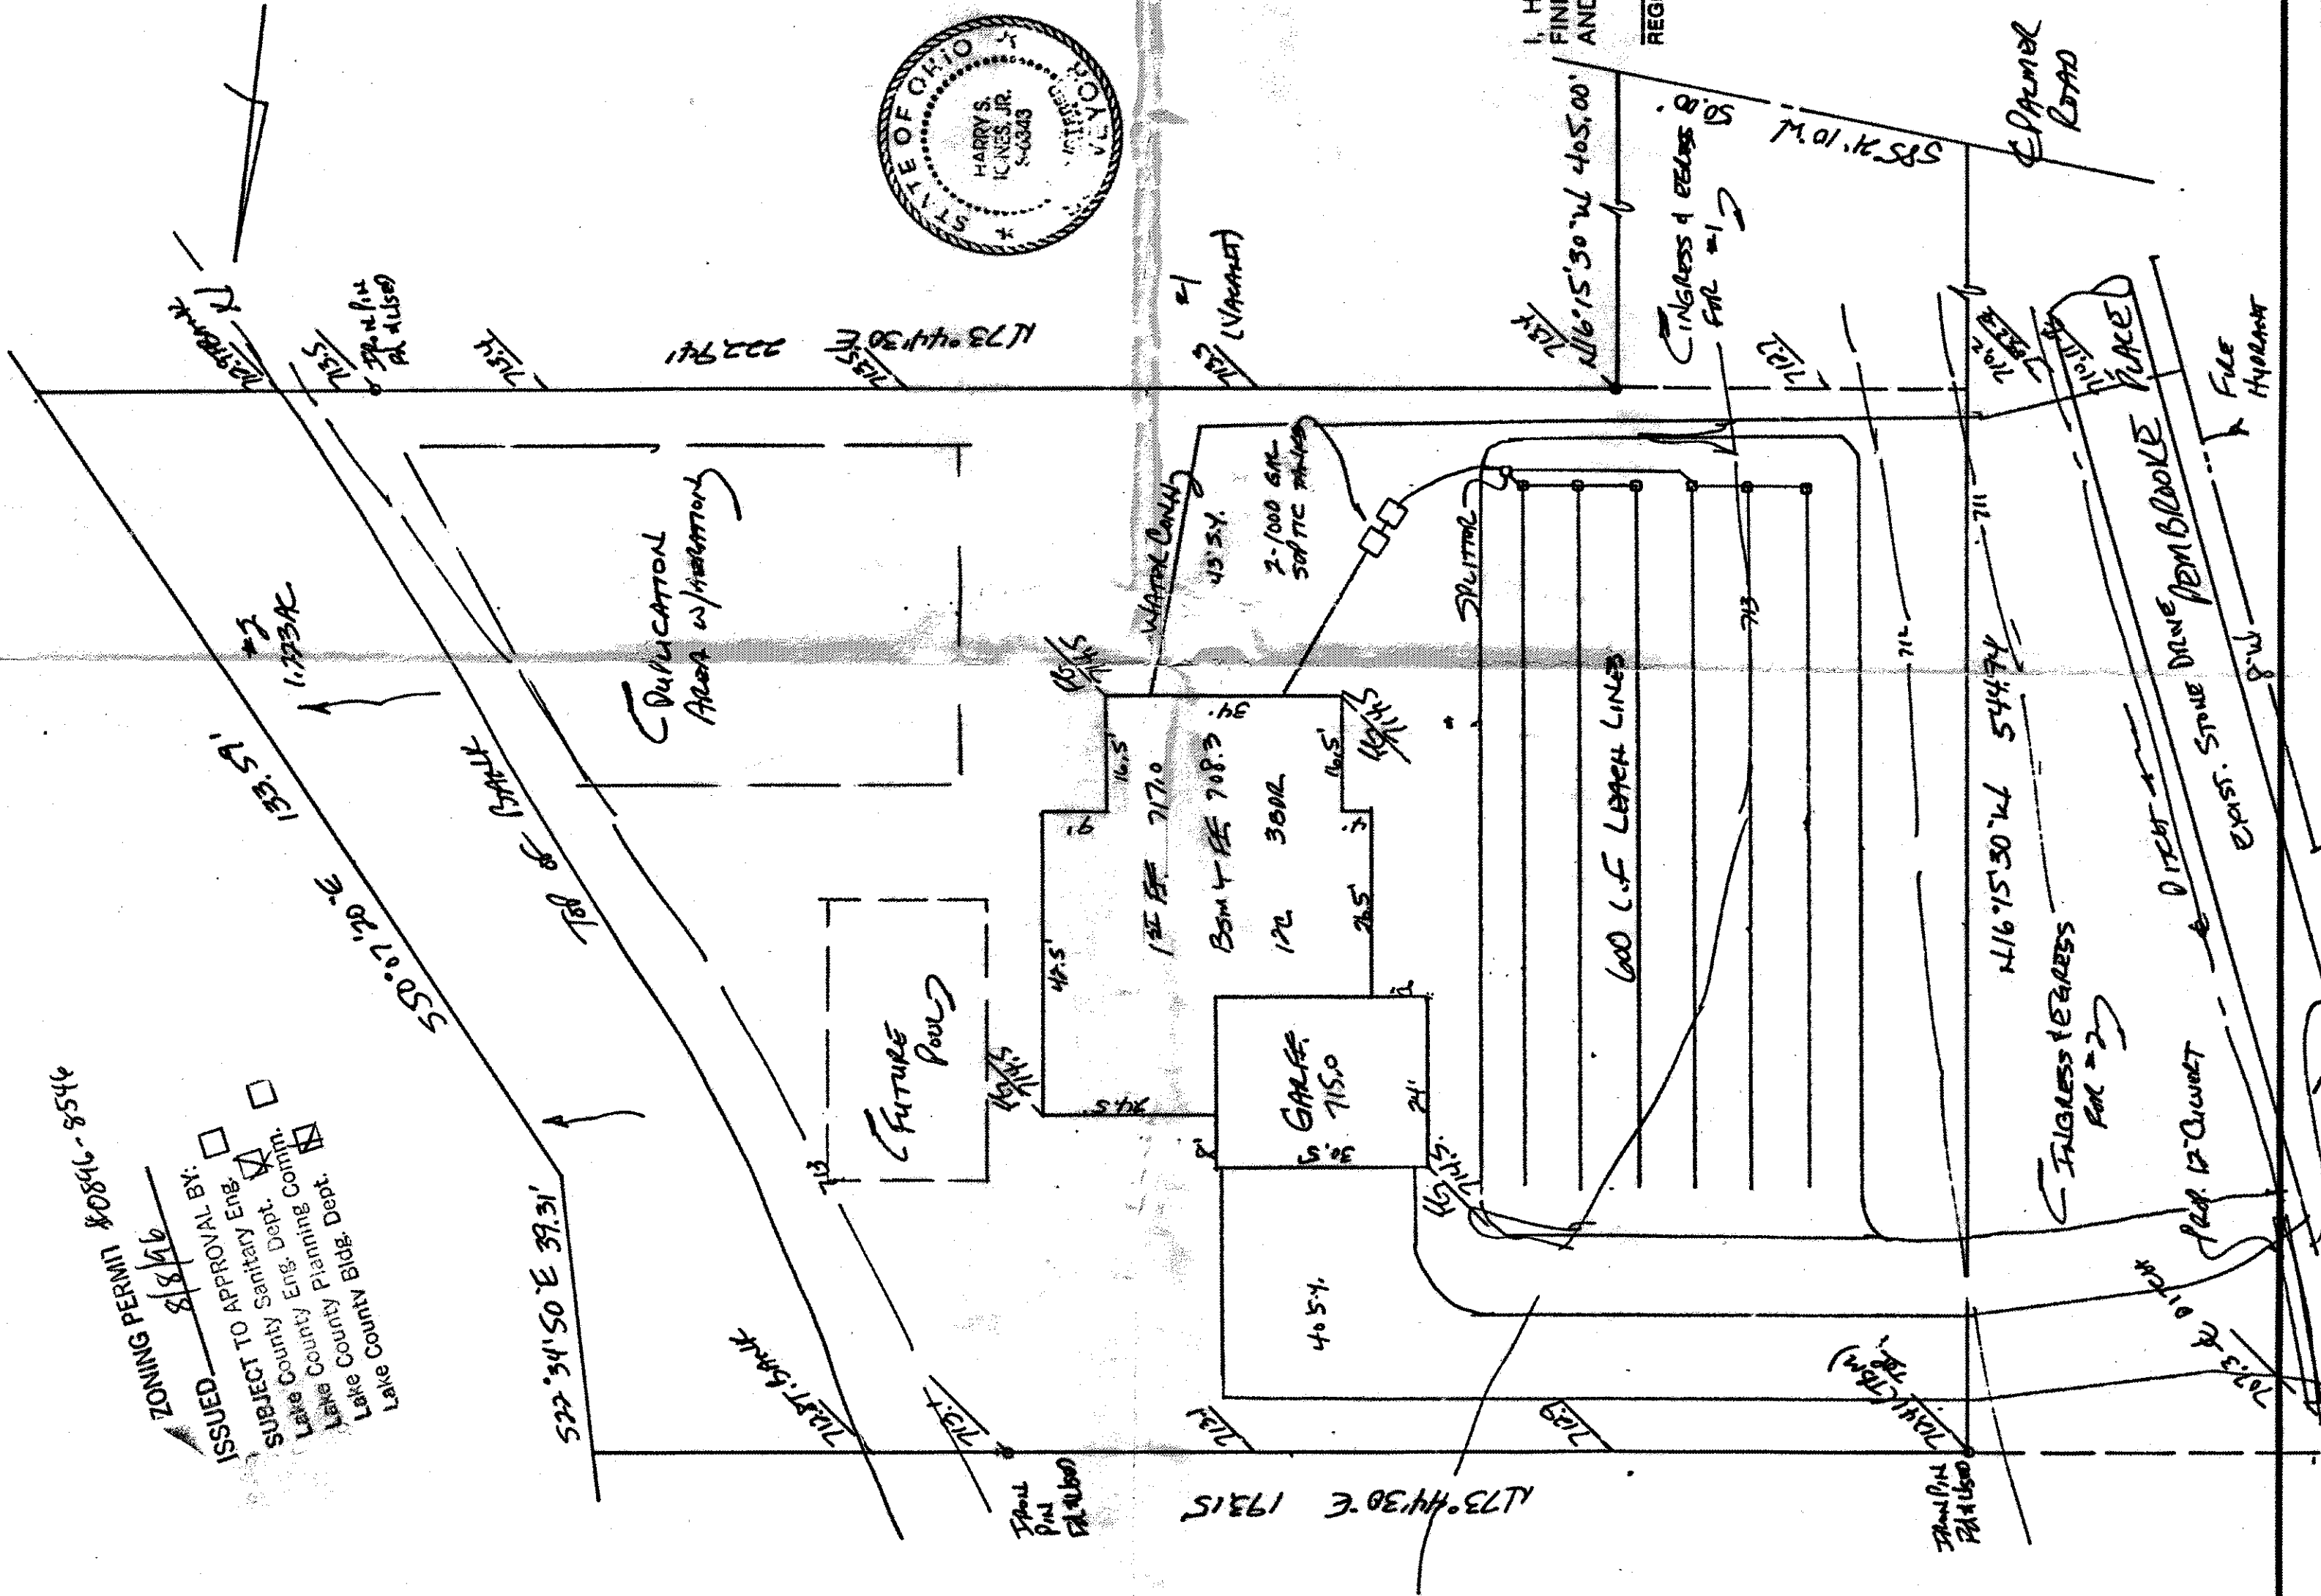
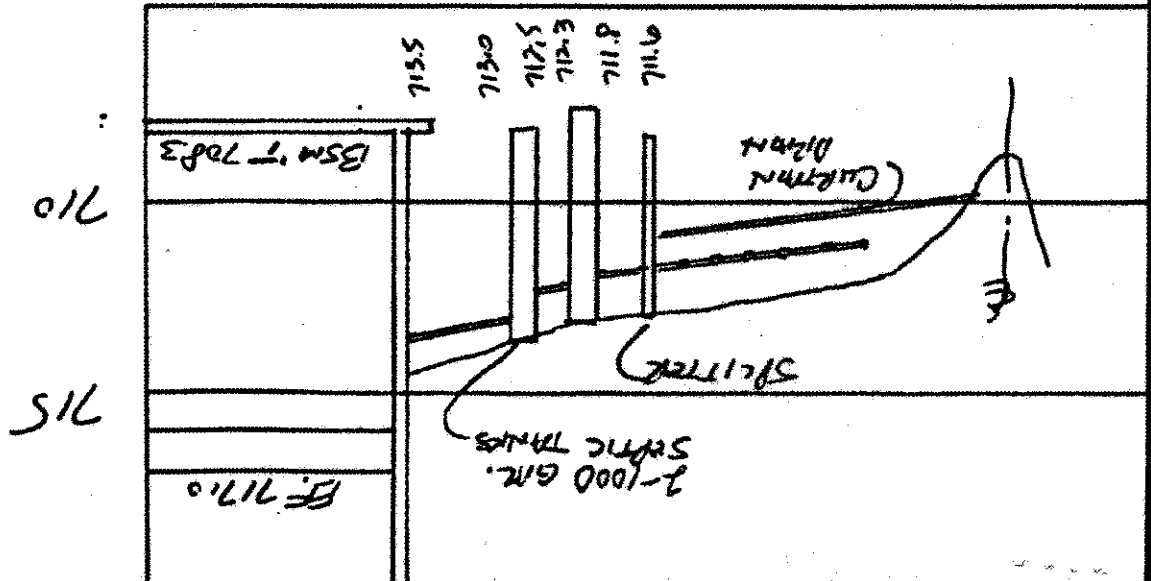
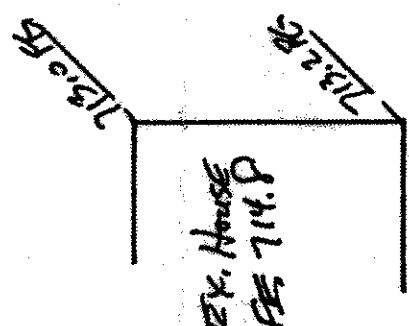
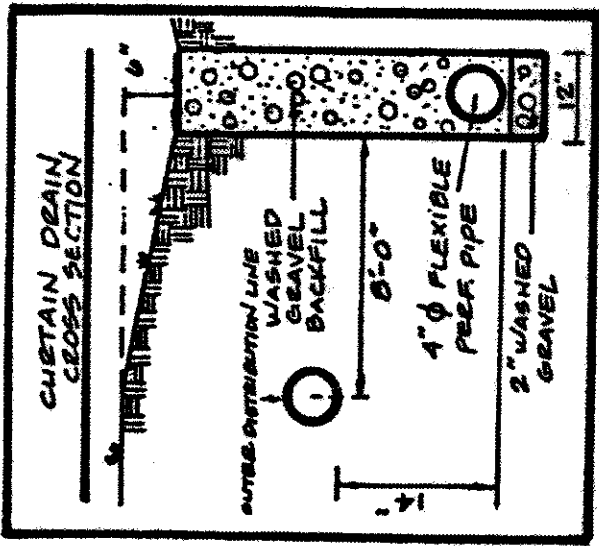


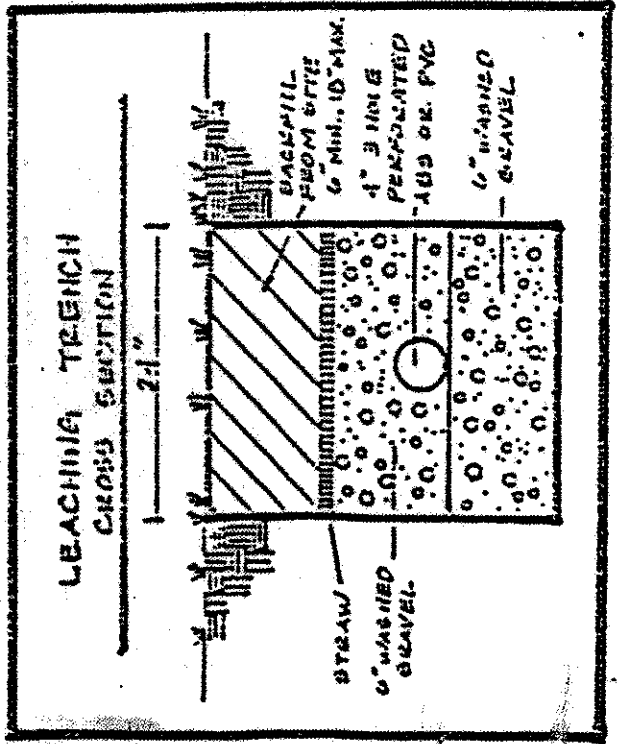

SITE PLAN

LOT 2 TOWNSHIP, LAKE COUNTY OHIO

100' KEN HOPE

913 Royal Road

City: Cleveland, Ohio 44110

SUBDIVISION

NAME: Vol. - 100-100-100-100

STREET: STREET

TRACT: TRACT

PAGE: PAGE

STREET: STREET

LEGEND

SANITARY MANHOLE

WATER VALVE (GAS)

WATER METER

AS BUILT ELEVATION

INLET OR CATCH BASIN

HYDRANT

EXISTING CONTOURS

PROPOSED CONTOURS

EXIST. ELEV. 100.0

PROP. ELEV. 100.0

INDICATES DIRECTION OF SURFACE DRAINAGE

REMARKS

ALL BOUNDARY DATA SHOWN WAS OBTAINED FROM (DEEDS, RECORDED SUBDIVISION PLAT OR OTHER PUBLIC RECORDS)

LOCATIONS AS SHOWN OF ADJACENT WELLS AND SEPTIC TANKS OBTAINED FROM LAKE COUNTY HEALTH DEPARTMENT

DESIGN CERTIFICATION

THIS PLAT WAS PREPARED BY ME, AND IS CORRECT TO THE BEST OF MY KNOWLEDGE AND BELIEF.

NAME: Harry S. Jones, Jr.

SURVEYOR REGISTRATION NO. 54343

CHECK LIST

NO. OF BEDROOMS

NO. OF BATHS

NO. OF TOILETS

NO. OF KITCHENS

NO. OF DINING ROOMS

NO. OF LIVING ROOMS

NO. OF PORCHES

NO. OF GARAGES

NO. OF DRIVEWAYS

NO. OF FENCES

NO. OF POOLS

NO. OF TREES

NO. OF SHRUBS

NO. OF ROCKS

NO. OF OUTCROPPINGS

WATER MAIN SIZE, LOCATION

SAN. SEWER SIZE & GR. LOC.

SAN. MH. CAST. ELEV. INV. ELEV.

SAN. CONN. SIZE, LOC. DEPTH

STORM SEWER SIZE & GR. LOC.

STORM MH. CAST. ELEV. INV. ELEV.

PAV'T TYPE GRADE CURVES

GAS LINE LOC. SIZE PRESSURE

SEPTIC TANK LOCATION & DUPLICATION AREA

WELL LOCATION

ISOLATION RADIUS FROM WELL

PLAN PREPARED BY:

BABCOCK • JONES & ASSOCIATES, INC.

PAINESVILLE, OHIO

SCALE: 1" = 20'

DATE: 4/19/76

DRAWING NO. 90-281-2

APP'D. BY: [Signature]

CHECKED BY: [Signature]

CREW CHIEF: [Signature]

"AS BUILT" CERTIFICATION

I, HEREBY CERTIFY THAT THE CIRCLED GRADES ARE EXISTING FINISH GRADES CHECKED IN THE FIELD ON 19 19 19 AND ARE CORRECT TO THE BEST OF MY KNOWLEDGE AND BELIEF.

REGISTERED SURVEYOR

REG. NO.

TPM - TOP OF IRON PIN

@ 11.41, 11.41, 11.41

ELEV. = 712.41

I, the undersigned, hereby certify that the above is a true and correct copy of the original and elevations shown thereon as an actual field survey made by me on the 28th day of March, 1976 and that the elevations were taken at appropriate intervals and that as of that date they existed as indicated hereon.

Harry S. Jones, Jr.

Reg. No. 54343