

SITE PLAN

Coloan Township, Lake County, Ohio

for: Rob Lash Client 352-1929

ADDRESS STREET CITY ZIP

SUBDIVISION NAME LOT TRACT  
VOL. - PG. VOLUME 170  
SUBLOT NO. STREET PERM. PARCEL NO. PAGE 120

LEGEND	
SANITARY MANHOLE	WATER VALVE (GAS)
STORM MANHOLE	WATER METER (GAS)
INLET OR CATCH BASIN	AS BUILT ELEVATION
HYDRANT	INDICATES DIRECTION OF SURFACE DRAINAGE
EXISTING CONTOURS	
PROPOSED CONTOURS	
EXIST. ELEV. 1000	PROP. ELEV. 1000

REMARKS  
ALL BOUNDARY DATA SHOWN WAS OBTAINED FROM (DEEDS, RECORDED SUBDIVISION PLAT OR OTHER PUBLIC RECORDS)  
LOCATIONS AS SHOWN OF ADJACENT WELLS AND SEPTIC TANKS OBTAINED FROM LAKE COUNTY HEALTH DEPARTMENT

DESIGN CERTIFICATION  
THIS PLAT WAS PREPARED BY ME, AND IS CORRECT TO THE BEST OF MY KNOWLEDGE AND BELIEF.  
NAME SURVEYOR REGISTRATION NO.

CHECK LIST	
NO. OF BEDROOMS	WATER MAIN SIZE, LOCATION
DIMENSIONS	SAN. SEWER SIZE, GR. LOC.
BEARINGS	SAN. MH. CAST. ELEV. INV. ELEV.
TIE TO NEAREST STREET	SAN. CONN. SIZE, LOC. DEPTH
SUBLOT NO. PARCEL NO.	STORM SEWER SIZE, GR. LOC.
SURROUNDING OWNERS	STORM MH. CAST ELEV. INV. ELEV.
BUILD. DIMENSIONS FIN. GR.	PAV'T TYPE, GRADE CURBS
BLDG. TIES FLR. GRADES	GAS LINE LOC. SIZE PRESSURE
APRON TYPE WIDTH THICKNESS	SEPTIC TANK LOCATION & DUPLICATION AREA
SEWER TYPE DIA. LENGTH	WELL LOCATION
ROCK OUTCROPPINGS	ISOLATION RADIUS FROM WELL

REVISIONS		PLAN PREPARED BY:	
NO.	DATE	BY	DATE
1			
2			
3			
4			
5			
		DRAWN BY	SCALE 1" = 50'
		CHKD.	DATE 2/24/17
		CREW	APPD. 97-039

"AS BUILT" CERTIFICATION

I, HEREBY CERTIFY THAT THE CIRCLED GRADES ARE EXISTING FINISH GRADES CHECKED IN THE FIELD ON 19 AND ARE CORRECT TO THE BEST OF MY KNOWLEDGE AND BELIEF.

REGISTERED SURVEYOR REG. NO.


THOMAS P. GILLES, P.E.  
Lake County Engineer  
APPROVED TO THIS PLAN  
DATE 2/24/17

ZONING PERMIT #0247-8641

ISSUED 2/28/17

SUBJECT TO APPROVAL BY:  
Lake County Sanitary Eng. ☐  
Lake County Eng. Dept. ☒  
Lake County Planning Comm. ☐  
Lake County Bldg. Dept. ☒

By Date 2/24/17  
Name  
Flood elev. = 736.0.

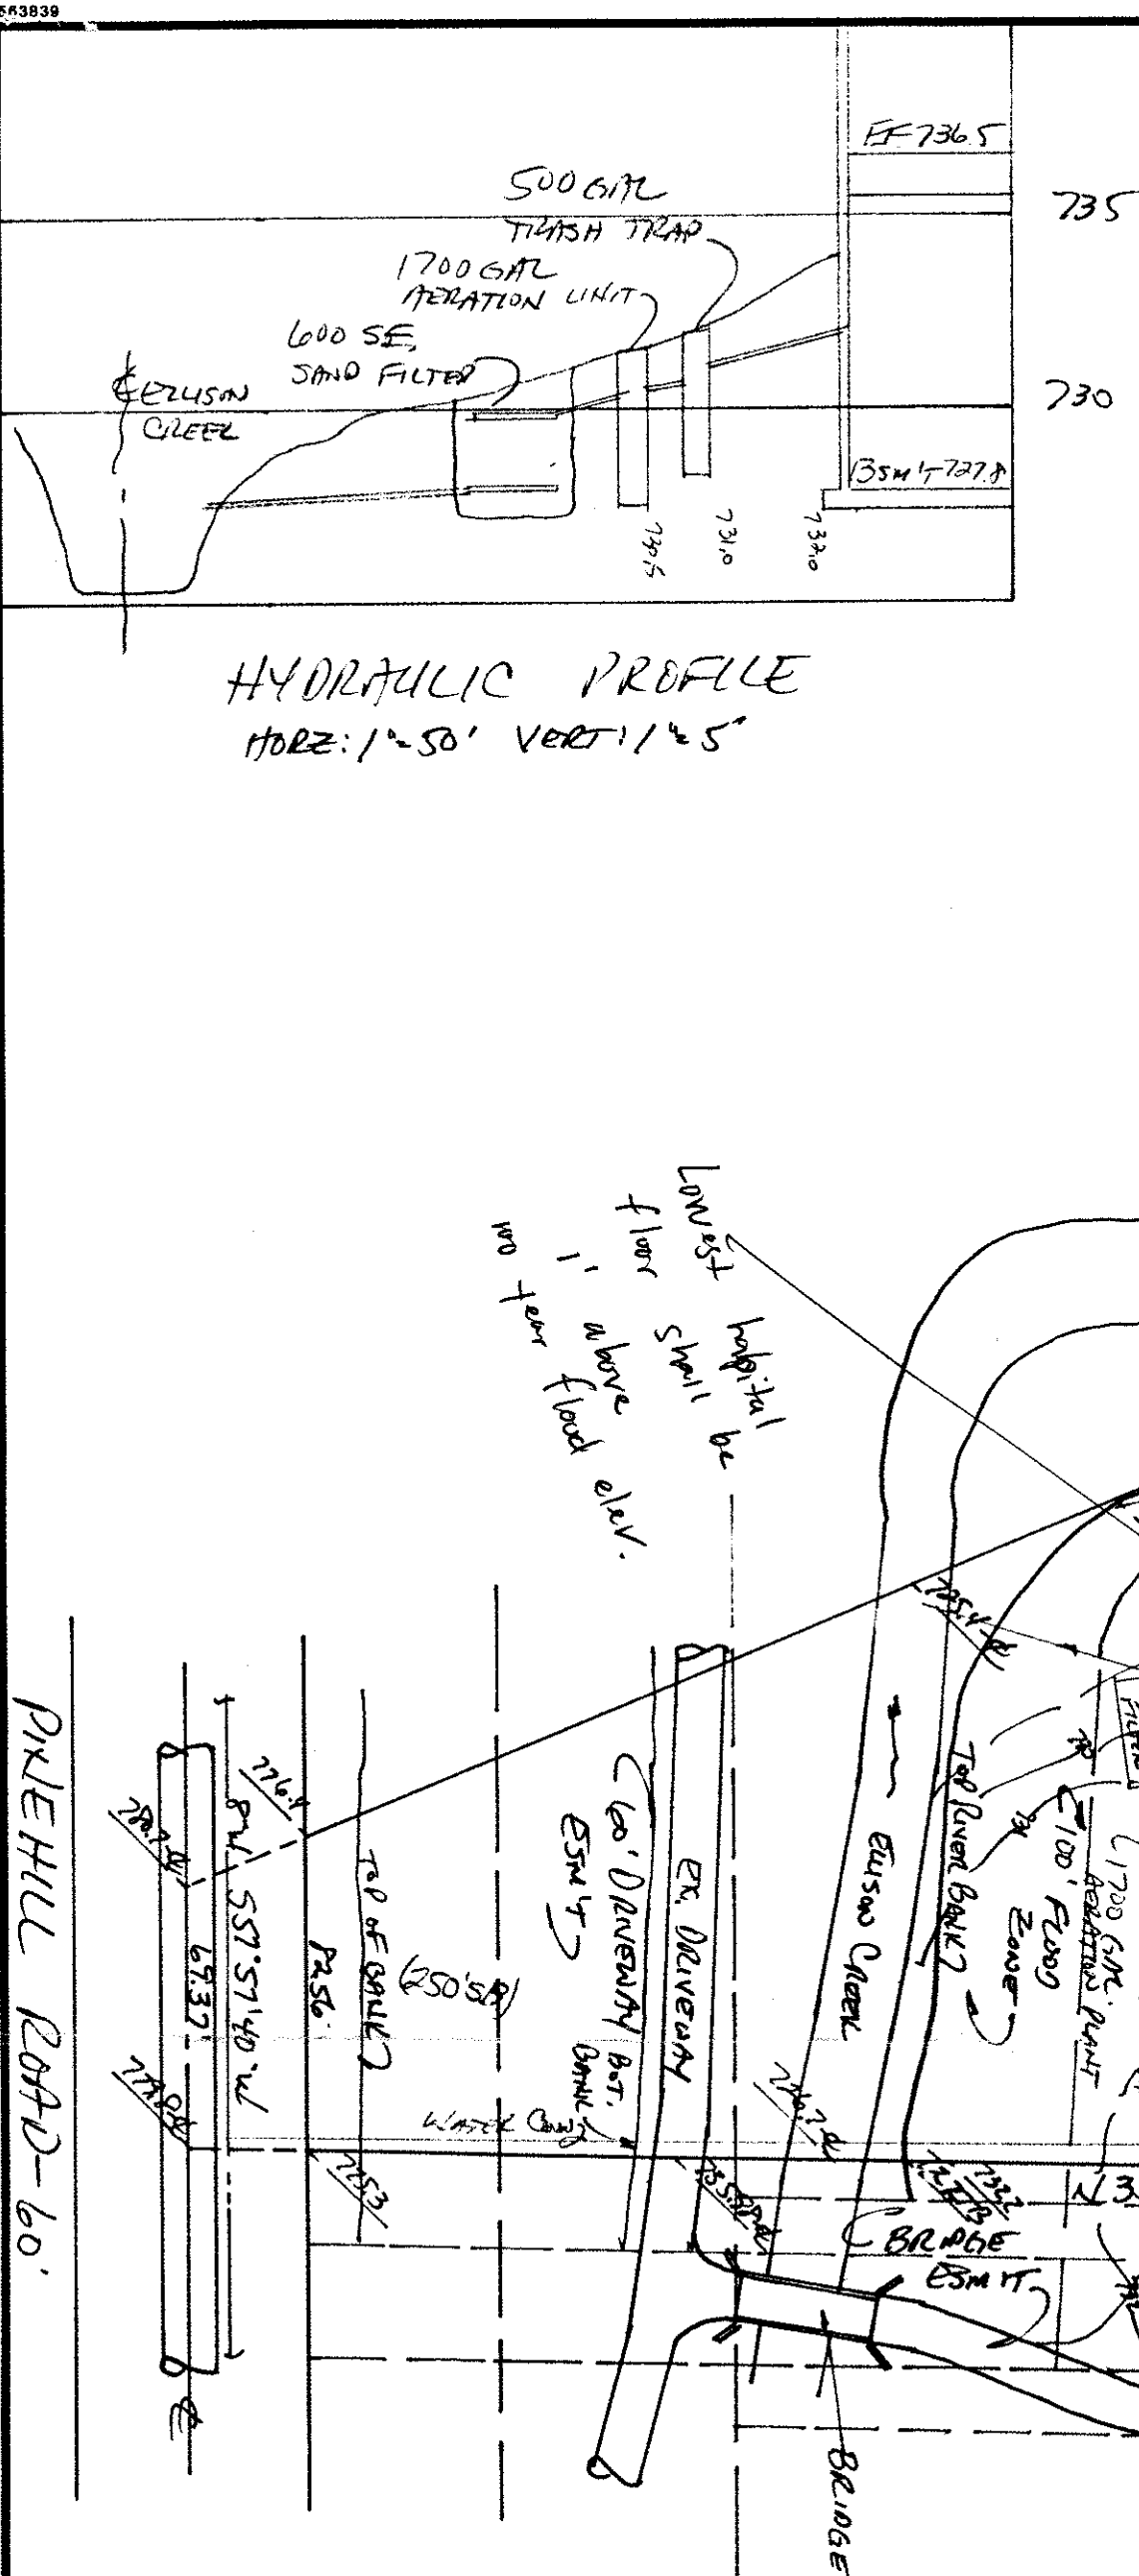

HYDRAULIC PROFILE  
HORIZ: 1"=50' VERT: 1"=5'