



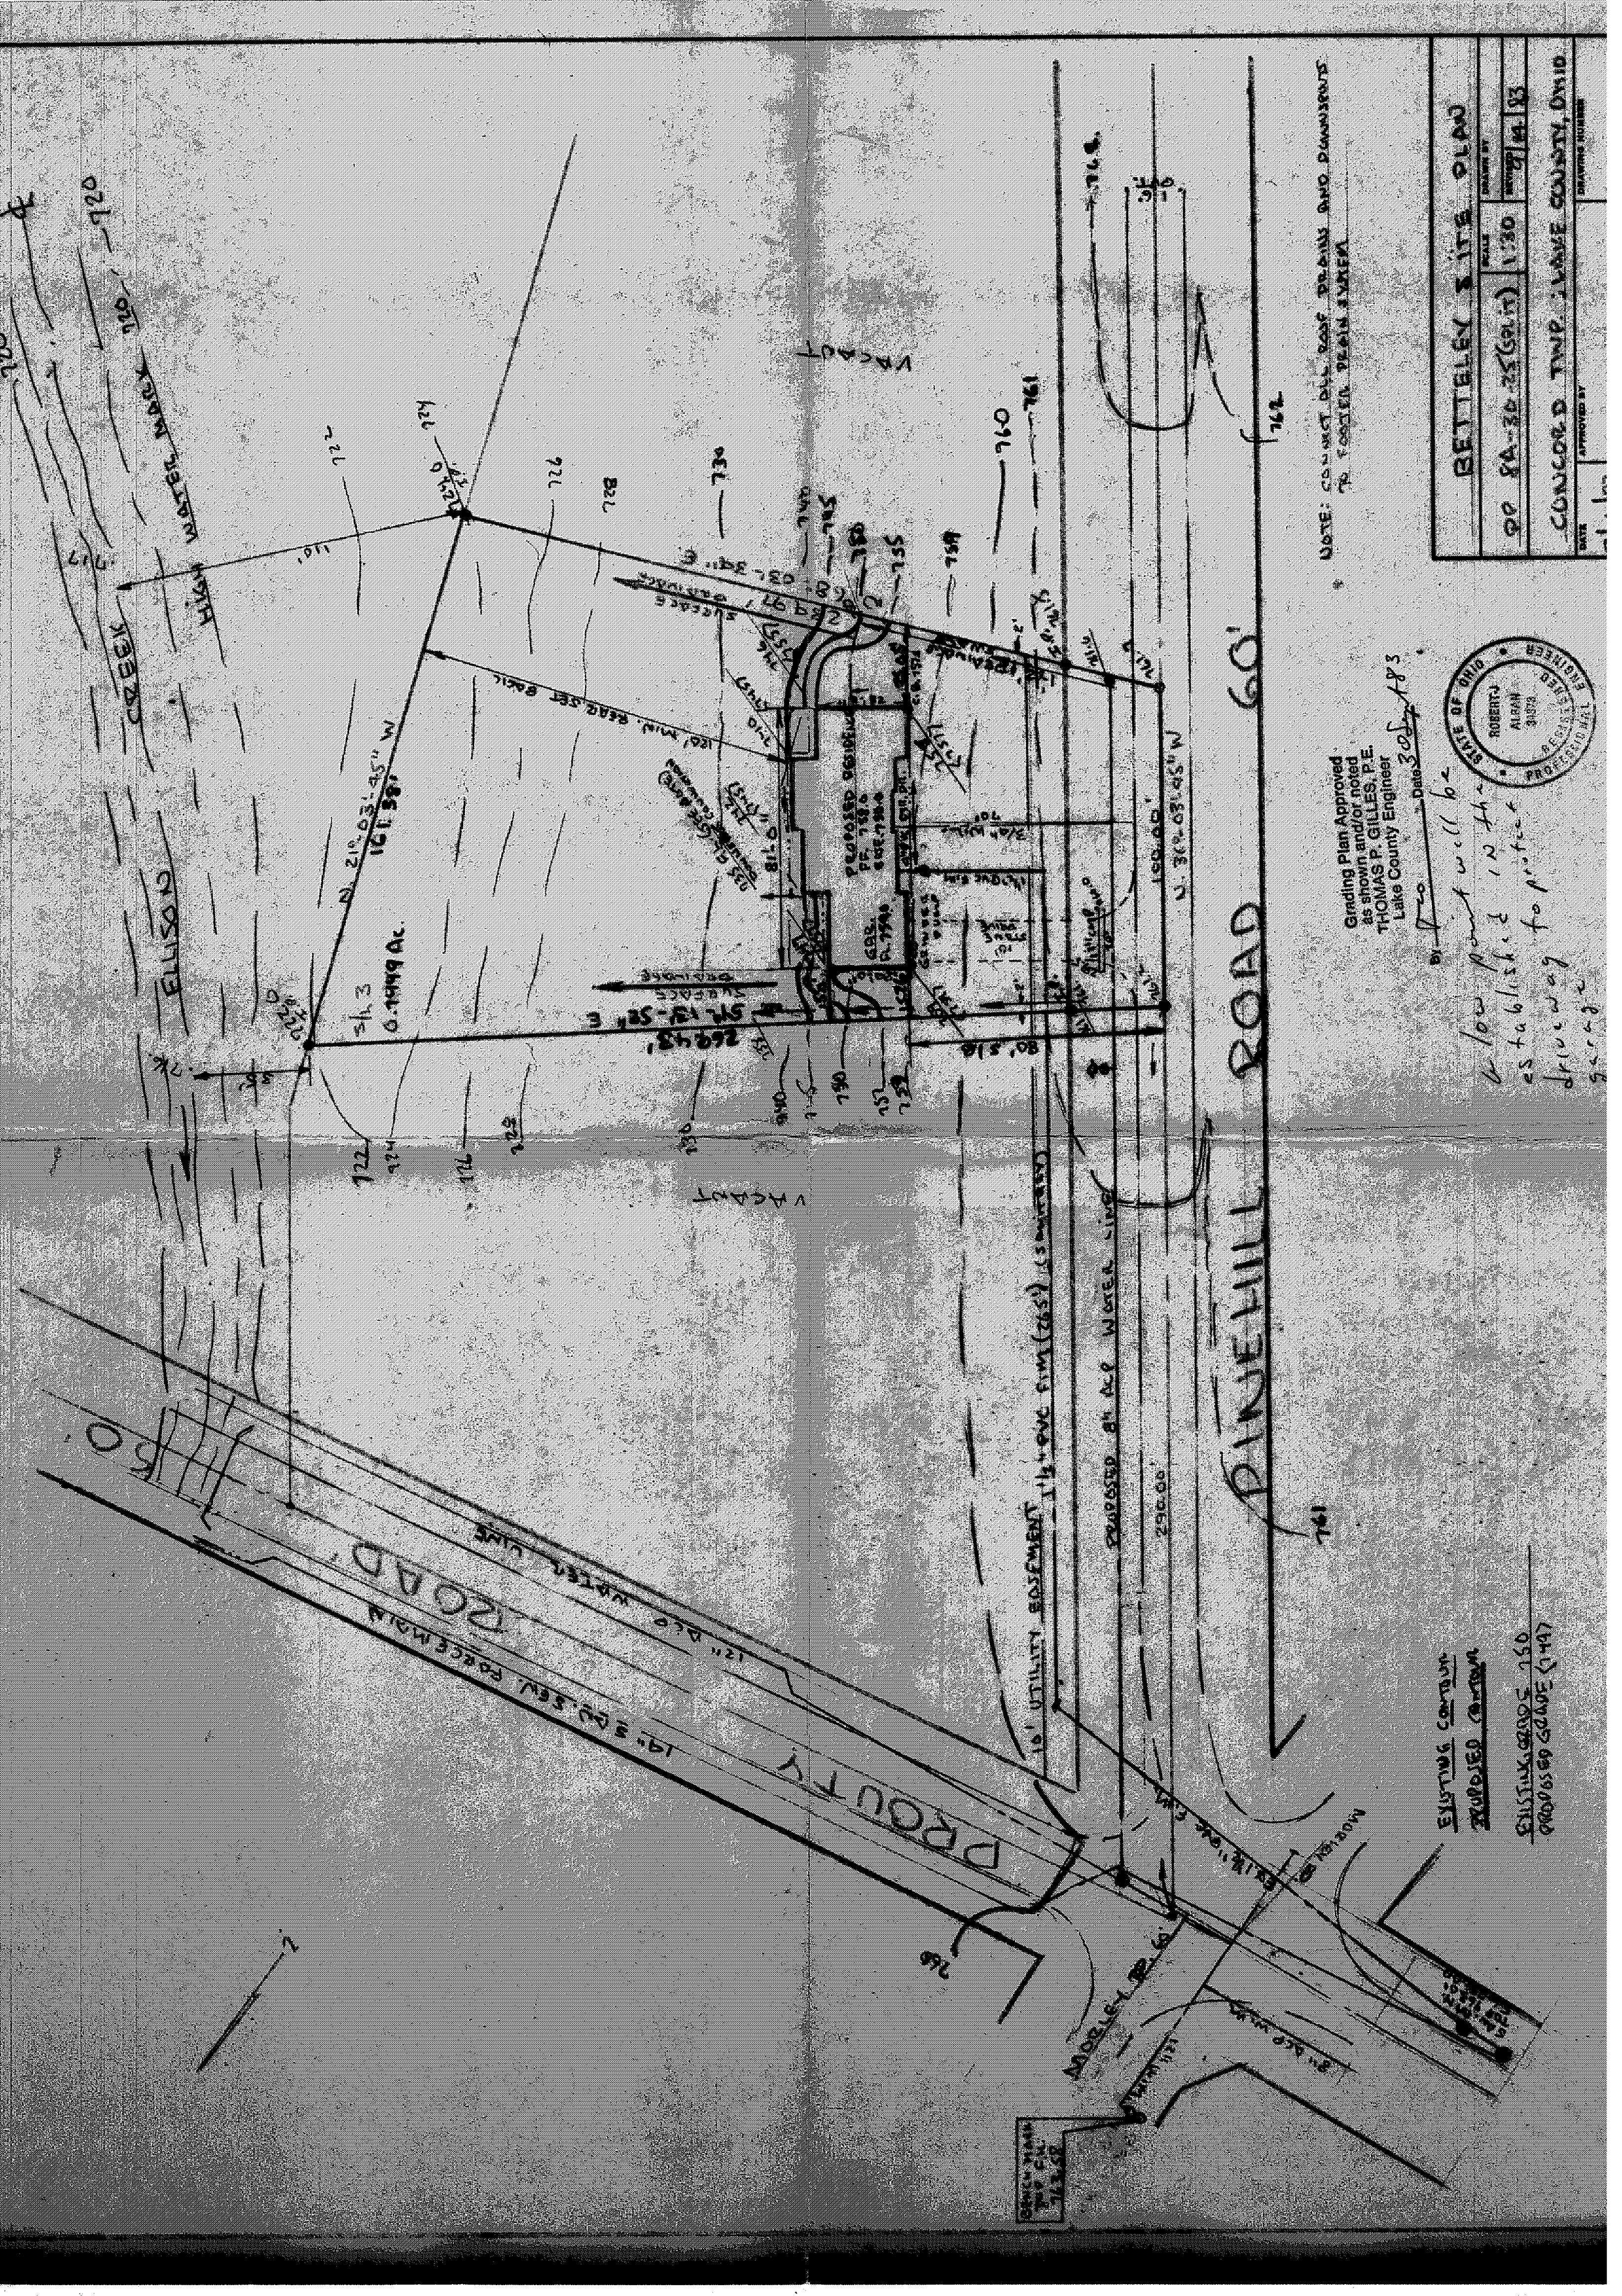

NOTE: CONJECTURE DRAIN DRAINAGE AND DRAINAGE
TO FOSTER DRAIN SYSTEM

Grading Plan Approved
as shown and/or noted
THOMAS P. GILLES, P.E.
Lake County Engineer

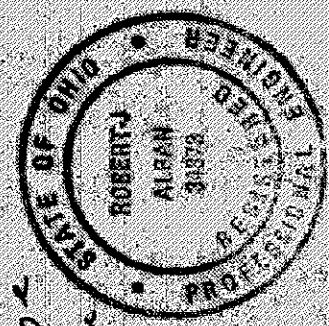

low point will be
established in the
driveway to provide
garage

EXISTING CORNER
PROPOSED CORNER

EXISTING GRADE 760
PROPOSED GRADE 749

BETTELEY SITE PLAN	
DATE	APPROVED BY
00 8A-30-25(SHIT) 1130	07/14/83
CONCORD TWP. LAKE COUNTY, OHIO	