


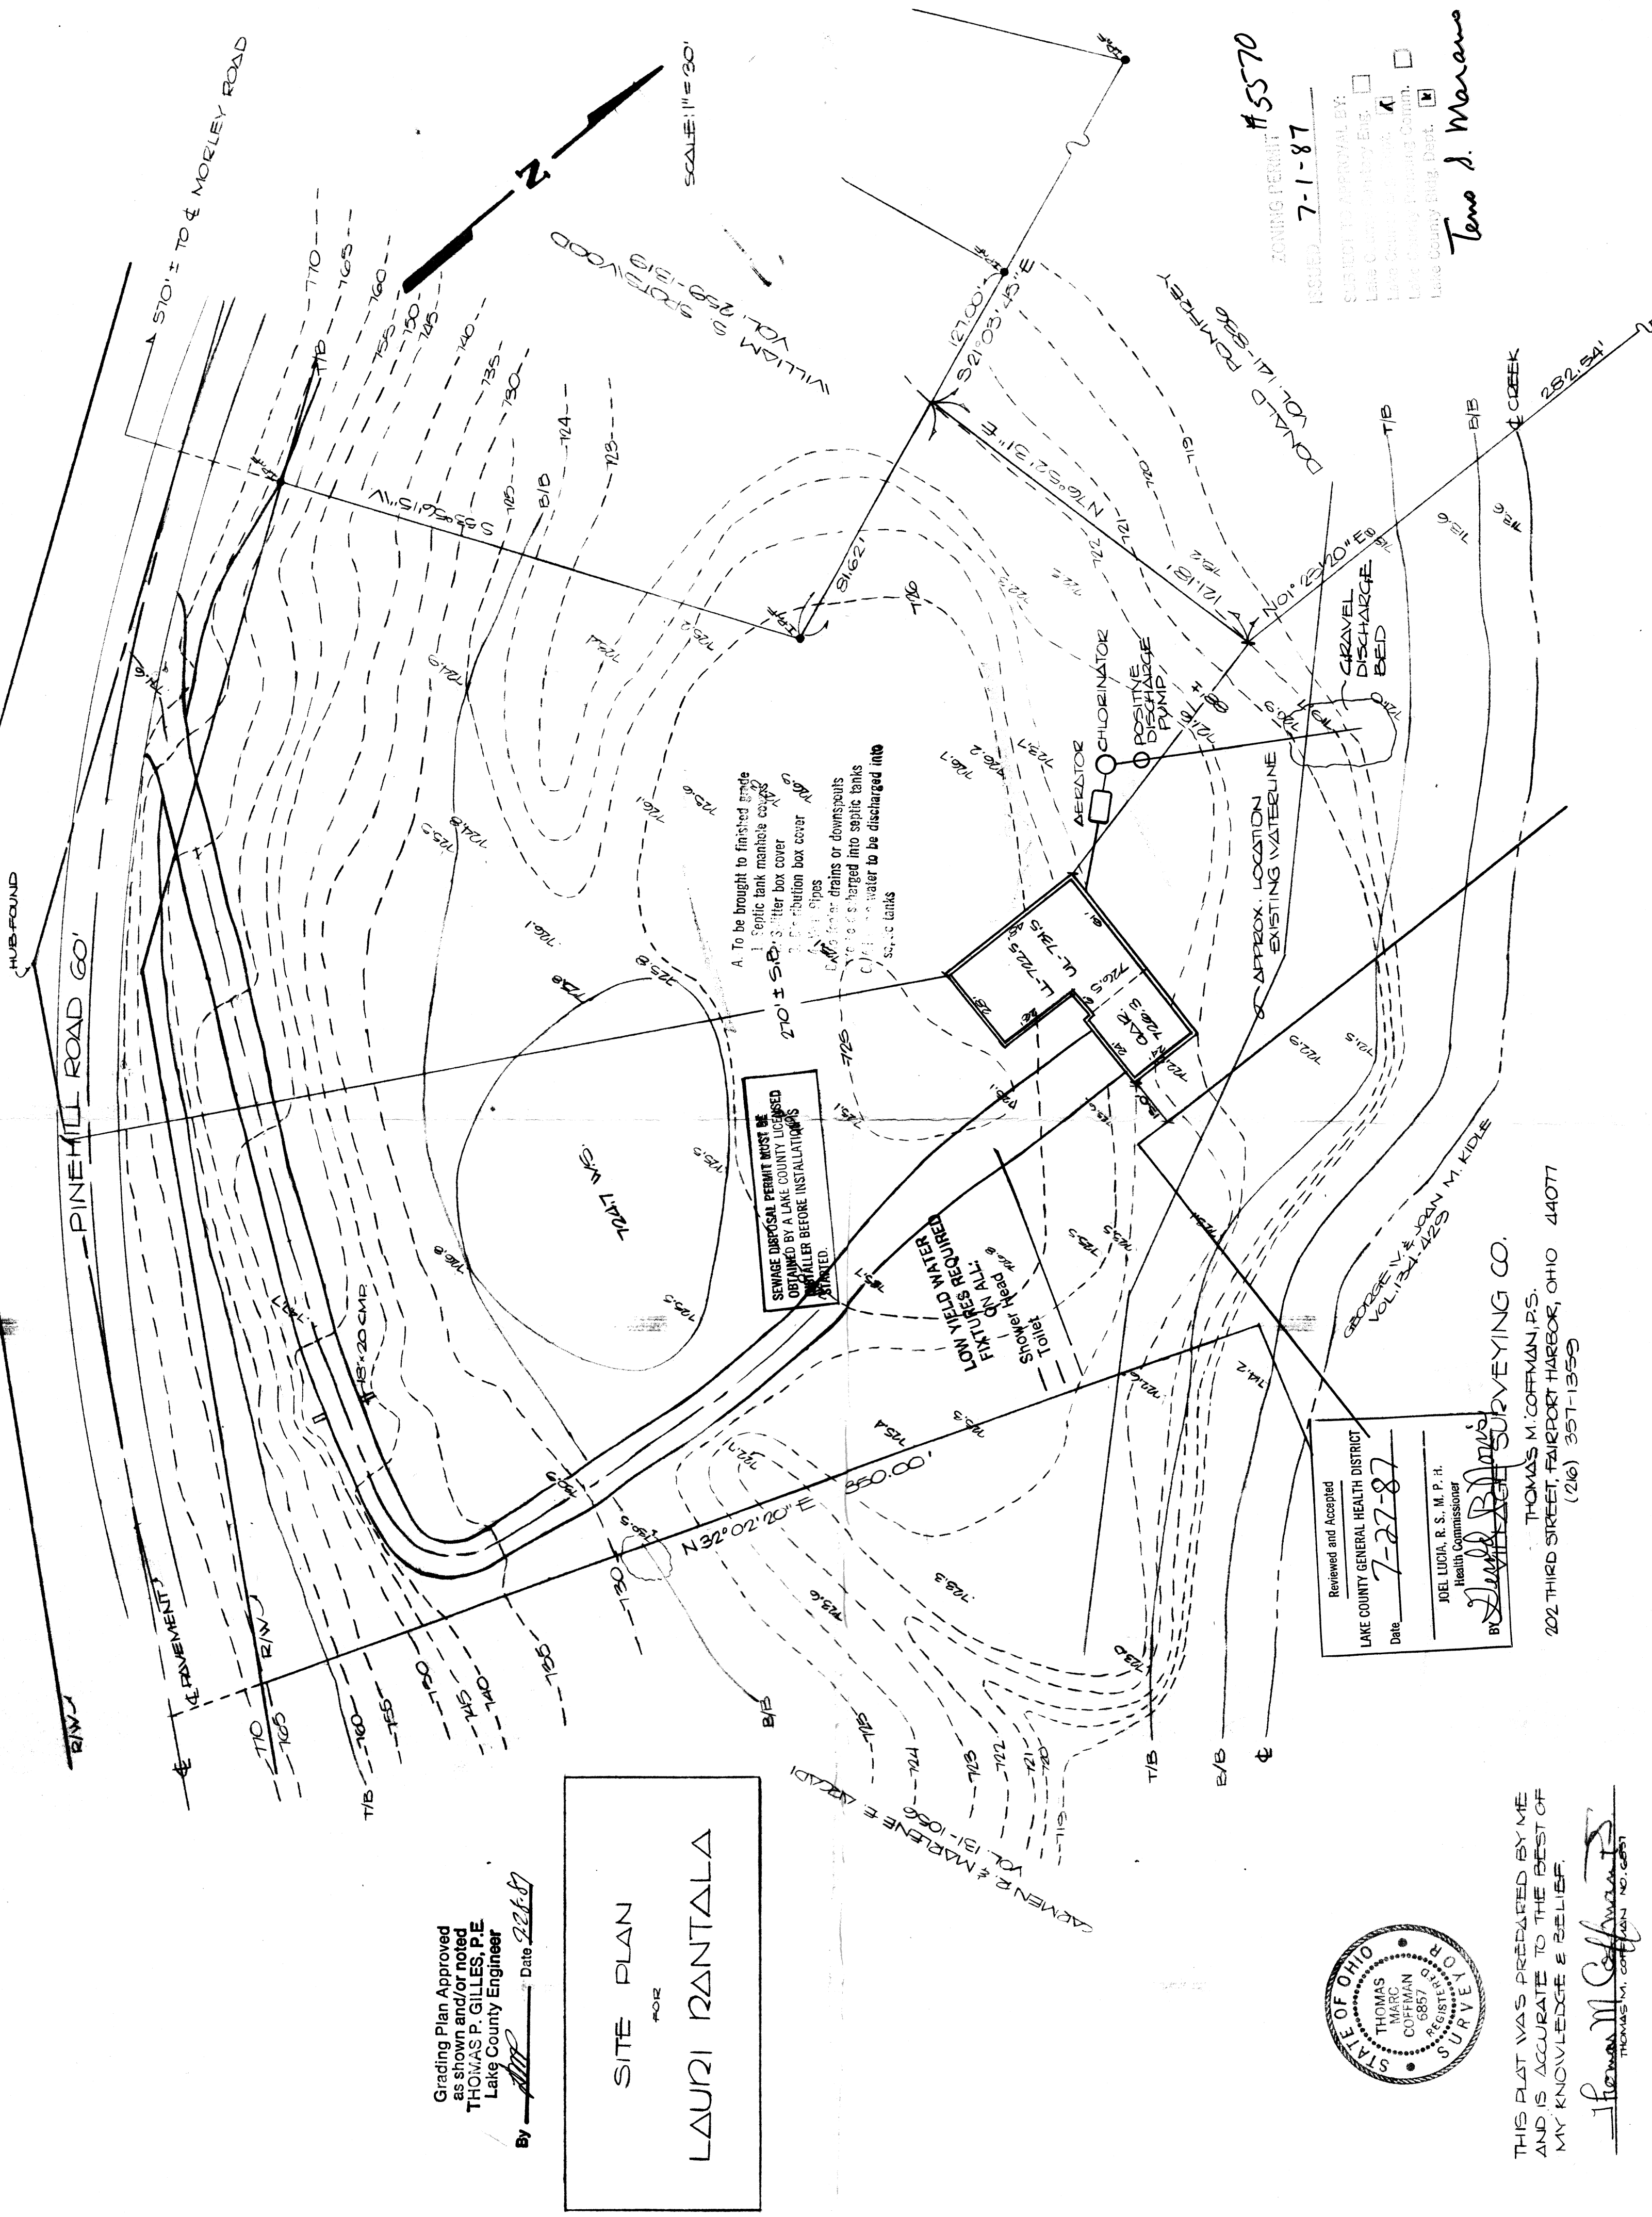

ISSUED 7-1-87

PERMIT #5570

APPROVED BY:

- ☐ Lake County Engineer
- ☒ Lake County Health Commissioner
- ☐ Lake County Planning Comm.
- ☐ Lake County Building Dept.

Tene J. Marano


A. To be brought to finished grade

- 1. Septic tank manhole cover
- 2. Distribution box cover
- 3. 4" Pipes
- 4. 6" Aerators or downspouts
- 5. 6" Discharge into septic tanks
- 6. 4" Water to be discharged into septic tanks

SEWAGE DISPOSAL PERMIT MUST BE OBTAINED BY A LAKE COUNTY LICENSED INSTALLER BEFORE INSTALLATION.

LOW YIELD WATER FIXTURES REQUIRED

- Toilet
- Shower Head
- Sink

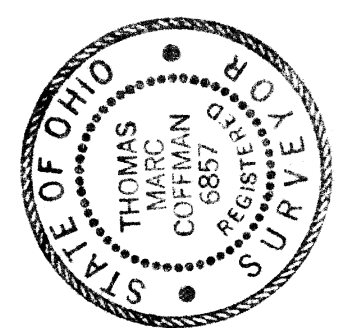

Reviewed and Accepted

LAKE COUNTY GENERAL HEALTH DISTRICT

Date 7-27-87

JOEL LUCIA, R. S. M. P. H.
Health Commissioner

BY *Thomas M. Coffman*
THOMAS M. COFFMAN, P.S.
202 THIRD STREET, FAIRPORT HARBOR, OHIO 44077
(216) 357-1359

Grading Plan Approved as shown and/or noted

THOMAS P. GILLES, P.E.
Lake County Engineer

By *TPG* Date 2-26-87

SITE PLAN FOR LAURDI RANTALA

THIS PLAN WAS PREPARED BY ME AND IS ACCURATE TO THE BEST OF MY KNOWLEDGE & BELIEF.

Thomas M. Coffman
THOMAS M. COFFMAN, P.S.
NO. 6857