


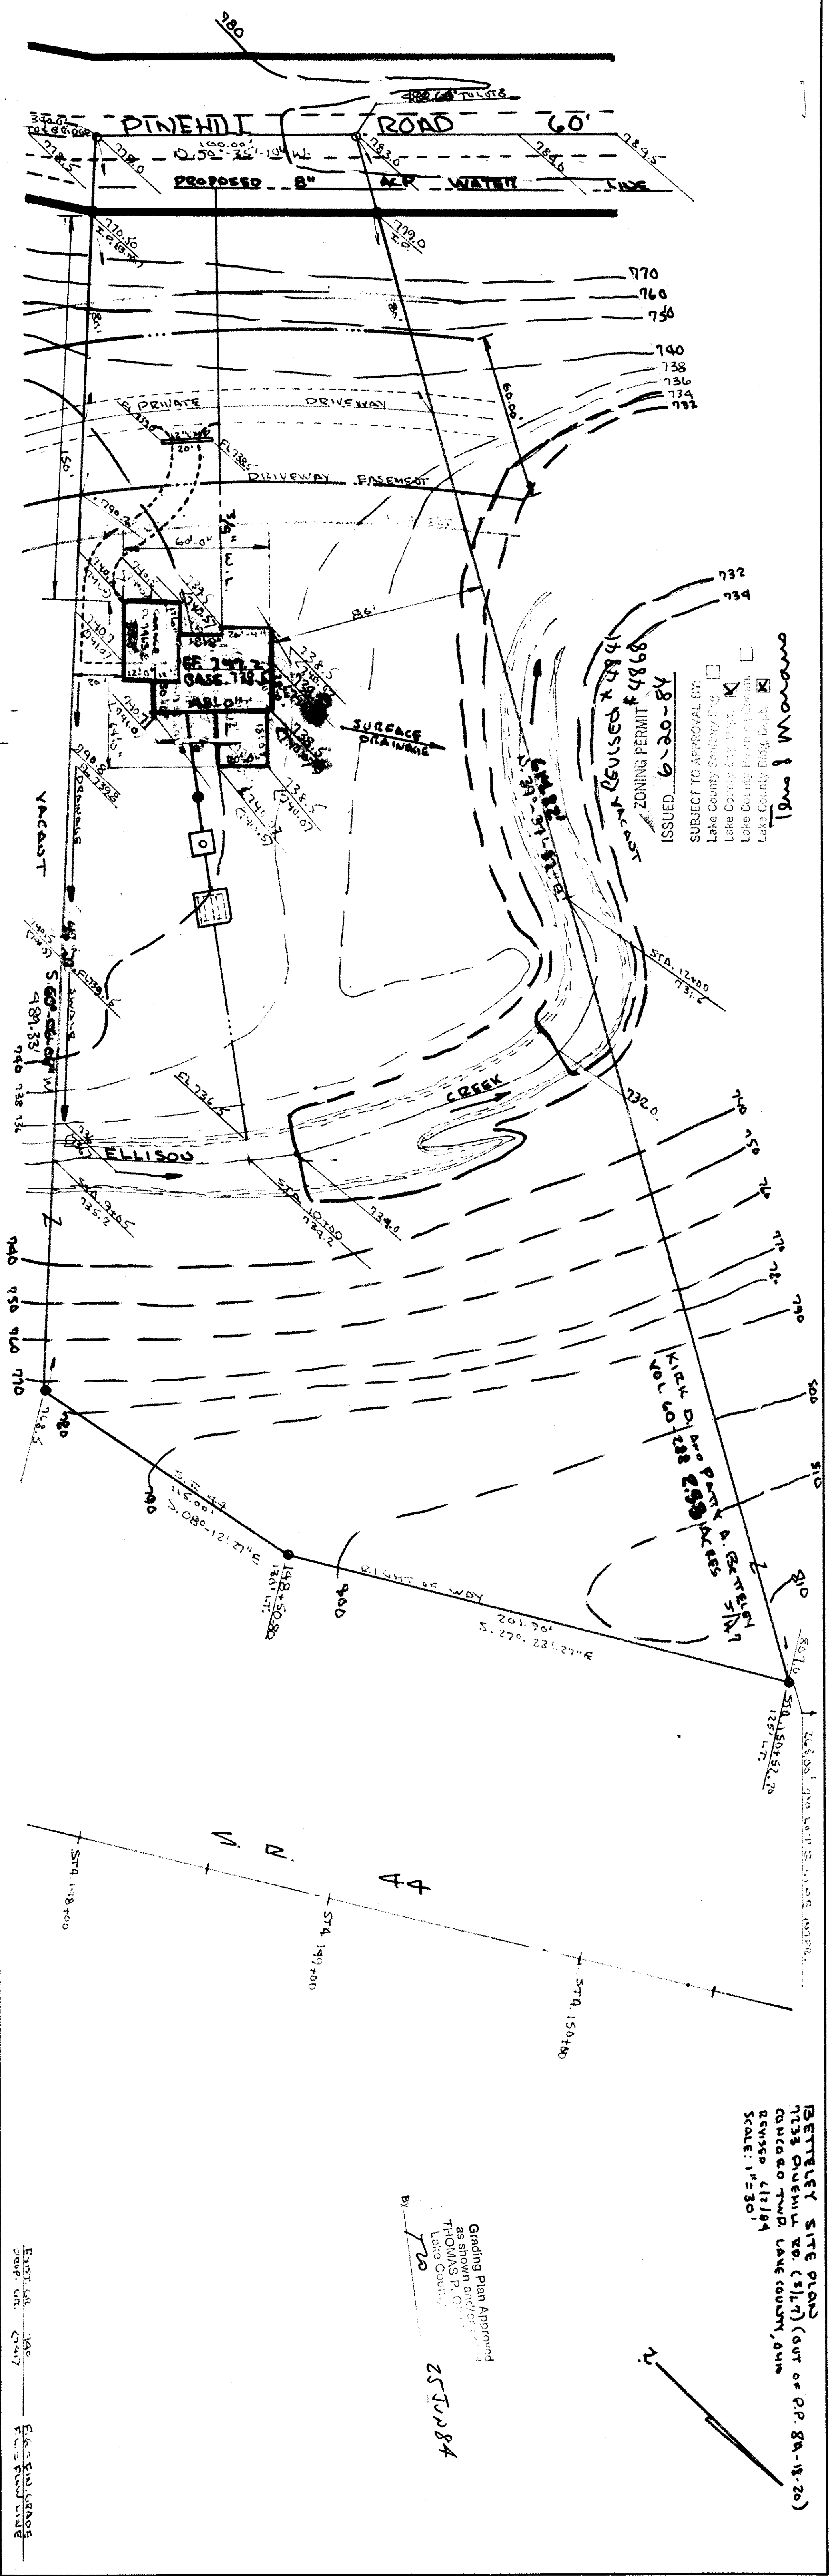

BETTERLEY SITE PLAN
7233 CHEMIST RD. (S117) (OUT OF P.P. 84-15-20)
CONCORD TWP. LAKE COUNTY, OHIO
REMSD 6/2/84
SCALE: 1" = 30'

Grading Plan Approved
as shown and/or noted
THOMAS P. CHITTENDEN
Lake County, Illinois

25 JUN 84

EXIST. GR. 740
PROP. GR. 67417

Elev. to FIN. GRADE
F.L. = FOUND. LINE

