


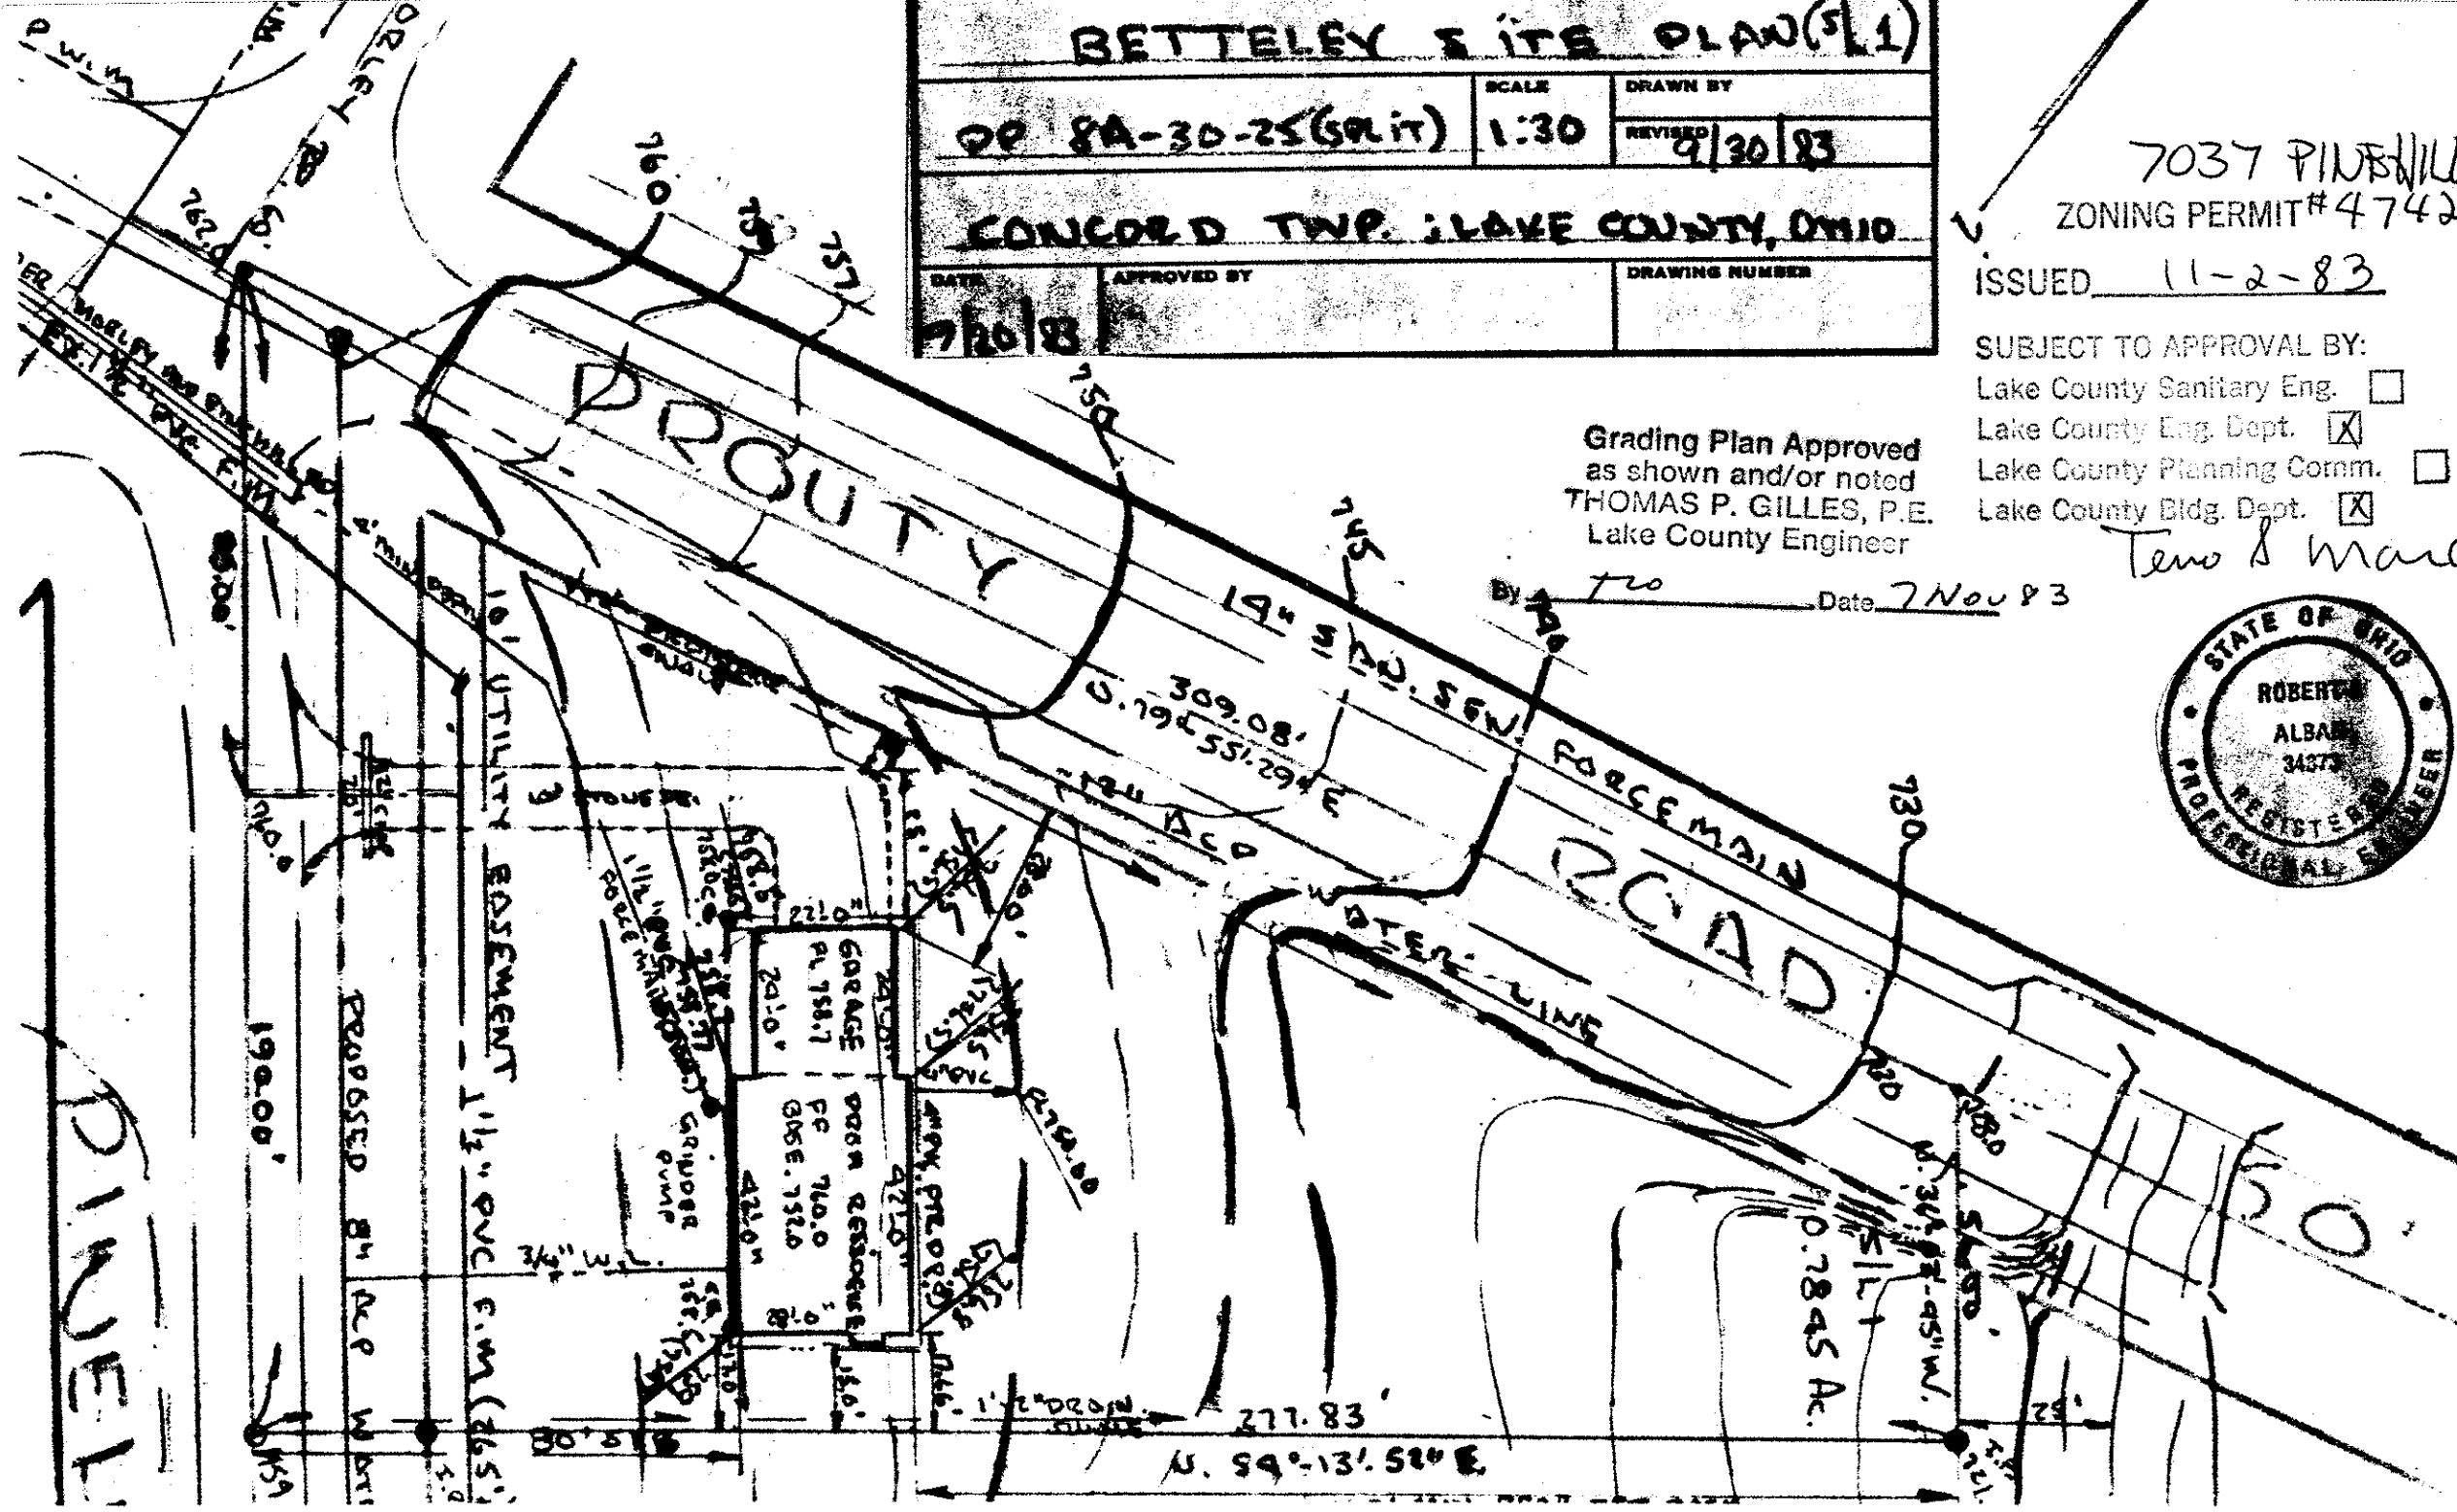

BETTELEY SITE PLAN(5)(1)		
88-8A-30-25(Split)	SCALE 1:30	DRAWN BY
CONCORD TWP. LAKE COUNTY, OHIO		REVISED 9/30/83
DATE 7/20/83	APPROVED BY	DRAWING NUMBER

7037 PINEHILL
ZONING PERMIT #4742
ISSUED 11-2-83
SUBJECT TO APPROVAL BY:
Lake County Sanitary Eng. ☐
Lake County Eng. Dept. ☒
Lake County Planning Comm. ☐
Lake County Bldg. Dept. ☒
Teno S. Marano

Grading Plan Approved
as shown and/or noted
THOMAS P. GILLES, P.E.
Lake County Engineer

By *Teno* Date *7 Nov 83*

