

SITE PLAN

Caloado Twp. Lake County, Ohio

for: Dave Kile

1278 Pallett Road, Caloado, Ohio

SUBDIVISION VOL. - PG. NAME LOT TRACT

SUBLOT NO. STREET VOLUME PERM. PARCEL NO. PAGE 1 of 2

LEGEND

SANITARY MANHOLE WATER VALVE (GAS) WATER METER (GAS) INLET OR CATCH BASIN AS BUILT ELEVATION HYDRANT EXISTING CONTOURS PROPOSED CONTOURS EXIST. ELEV. 100.00 PROP. ELEV. 100.00

REMARKS

ALL BOUNDARY DATA SHOWN WAS OBTAINED FROM IDEEDS, RECORDED SUBDIVISION PLAT OR OTHER PUBLIC RECORDS. LOCATIONS AS SHOWN OF ADJACENT WELLS AND SEPTIC TANKS OBTAINED FROM LAKE COUNTY HEALTH DEPARTMENT

DESIGN CERTIFICATION

THIS PLAT WAS PREPARED BY ME, AND IS CORRECT TO THE BEST OF MY KNOWLEDGE AND BELIEF

NAME SUPERVISOR REGISTRATION NO. 6345

CHECK LIST

NO. OF BEDROOMS NO. OF BATHS NO. OF TOILETS NO. OF SEPTIC TANKS NO. OF MANHOLES NO. OF HYDRANTS NO. OF CATCH BASINS NO. OF VALVES NO. OF METER BOXES NO. OF GAS MAINS NO. OF WATER MAINS NO. OF SEWER MAINS NO. OF STORM MAINS NO. OF SIDEWALKS NO. OF DRIVEWAYS NO. OF FENCES NO. OF GATES NO. OF LIGHTS NO. OF SIGNS NO. OF UTILITIES NO. OF OTHER FEATURES


PLAN PREPARED BY: BABCOCK & JONES & ASSOCIATES, INC. PAINESVILLE, OHIO

NO.	DATE	BY	SCALE	PROJ. NO.
1	11/14/82	HT	1" = 30'	357-1811
2	11/14/82	HT	1" = 30'	357-1811
3	11/14/82	HT	1" = 30'	357-1811
4	11/14/82	HT	1" = 30'	357-1811
5	11/14/82	HT	1" = 30'	357-1811

"AS BUILT" CERTIFICATION


I, HEREBY CERTIFY THAT THE CIRCLED GRADES ARE EXISTING FINISH GRADES CHECKED IN THE FIELD ON 19 AND ARE CORRECT TO THE BEST OF MY KNOWLEDGE AND BELIEF.

SUPERVISOR REG. NO. 6345

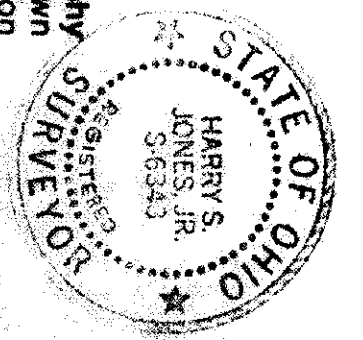


"I, the undersigned hereby certify that this topography indicated by 6', 1' or 2' contours, and elevations shown hereon, represent an actual field survey made by me on the day of 11/14/82 and that the elevations were taken at appropriate intervals and that as of that date they existed as indicated hereon."

Name: Dave Kile Reg. No. 6345

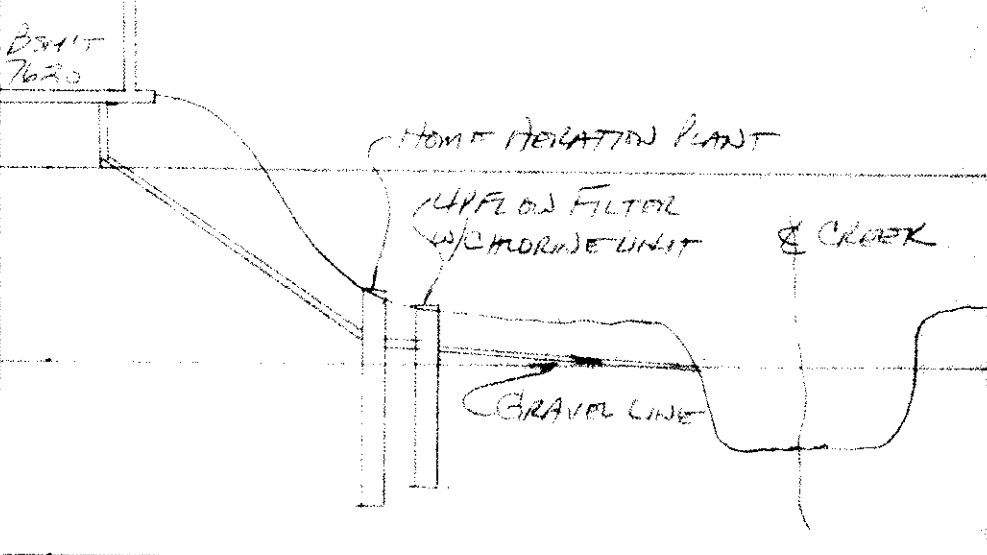

HYDRAULIC PROFILE DATE 11-21-80 VERT. 1" = 5'

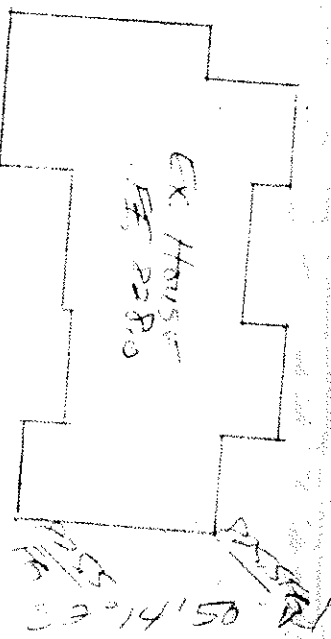

LOW YIELD WATER FIXTURES REQUIRED ON ALL Shower Head Toilet

ZONING PERMIT #6590 ISSUED 9-6-90

SUBJECT TO APPROVAL BY: Lake County Sanitary Eng. Lake County Eng. Dept. Lake County Planning Comm. Lake County Bldg. Dept.

Permit 8 March

7288 RICH HILL ROAD - 60'

Grading Plan Approved as shown and/or noted THOMAS P. GILLES, P.E. Lake County Engineer GJH Date 10/3/90 I, FEMA MAPS INDICATE SITE LOCATION IS IN ZONE A.

SEWAGE DISPOSAL PERMIT MUST BE OBTAINED BY A LAKE COUNTY LICENSED INSTALLER BEFORE INSTALLATION IS STARTED.

Standard and Accepted LAKE COUNTY GENERAL HEALTH DISTRICT Date 6-20-90 JOEL LUCIA, R.S., M.P.H. Health Commissioner By: [Signature]