

SITE PLAN

Palatka Twp, Lake County, Ohio

for: Dave Kirt

1228 Pine Hill Road Palatka

SUBDIVISION	NAME	LOT	TRACT
VOL. - PG.		VOLUME	PAGE
SUBLOT NO.	STREET	PERM. PARCEL NO.	STREET

LEGEND

SANITARY MANHOLE	WATER VALVE (GAS)
STORM MANHOLE	WATER METER (GAS)
INLET OR CATCH BASIN	AS BUILT ELEVATION
HYDRANT	INDICATES DIRECTION OF SURFACE DRAINAGE
EXISTING CONTOURS	
PROPOSED CONTOURS	
EXIST. ELEV.	PROP. ELEV.

REMARKS

ALL BOUNDARY DATA SHOWN WAS OBTAINED FROM IDEDS, RECORDED SUBDIVISION PLAT OR OTHER PUBLIC RECORDS.
LOCATIONS AS SHOWN OF ADJACENT WELLS AND SEPTIC TANKS OBTAINED FROM LAKE COUNTY HEALTH DEPARTMENT

DESIGN CERTIFICATION
THIS PLAT WAS PREPARED BY ME, AND IS CORRECT TO THE BEST OF MY KNOWLEDGE AND BELIEF.

CHECK LIST


NO. OF BEDROOMS	WATER MAIN SIZE, LOCATION
DIMENSIONS	SAN. SEWER SIZE, % GR. LOC.
BEARINGS	SAN. MH. CAST. ELEV. INV. ELEV.
THE TO NEAREST STREET	SAN. CORR. SIZE, LOC. DEPTH
SUBLOT NO. PARCEL NO.	STORM SEWER SIZE, % GR. LOC.
SURROUNDING OWNERS	STORM MH. CAST. ELEV. INV. ELEV.
BLOS. DIMENSIONS FIN. GR.	SAFETY TIES, GRADE CORRECTIONS
BLOS. TIES FIN. GRADES	SEPTIC TANK LOCATION & DIMENSIONS
SEPTIC TANK MANHOLE	WELL LOCATION
SEPTIC TANK TYPE, THICKNESS	ISOLATION RADIUS FROM WELL
SEPTIC TANK LENGTH	
ROCK OUTCROPPINGS	

PLAN PREPARED BY:
BABCOCK • JONES & ASSOCIATES, INC.
PAINESVILLE, OHIO

NO.	DATE	BY	SCALE	PHONE NO.
1	1/24/87	HT	1" = 30'	357-1811
2	1/24/87	HT		
3	1/24/87	HT		
4	1/24/87	HT		
5	1/24/87	HT		

"AS BUILT" CERTIFICATION
I, HEREBY CERTIFY THAT THE CIRCLED GRADES ARE EXISTING FINISH GRADES CHECKED IN THE FIELD ON 1/19/87 AND ARE CORRECT TO THE BEST OF MY KNOWLEDGE AND BELIEF.


REGISTERED SURVEYOR REG. NO.

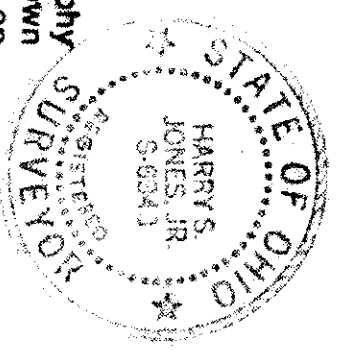

"I, the undersigned hereby certify that this topography indicated by 6", 1' or 2' contours, and elevations shown hereon represent an actual field survey made by me on the 1/19/87 day of 1987 and that the elevations were taken at appropriate intervals and that as of that date they existed as indicated hereon."

Name: Dave Kirt
#6343

Reg. No.

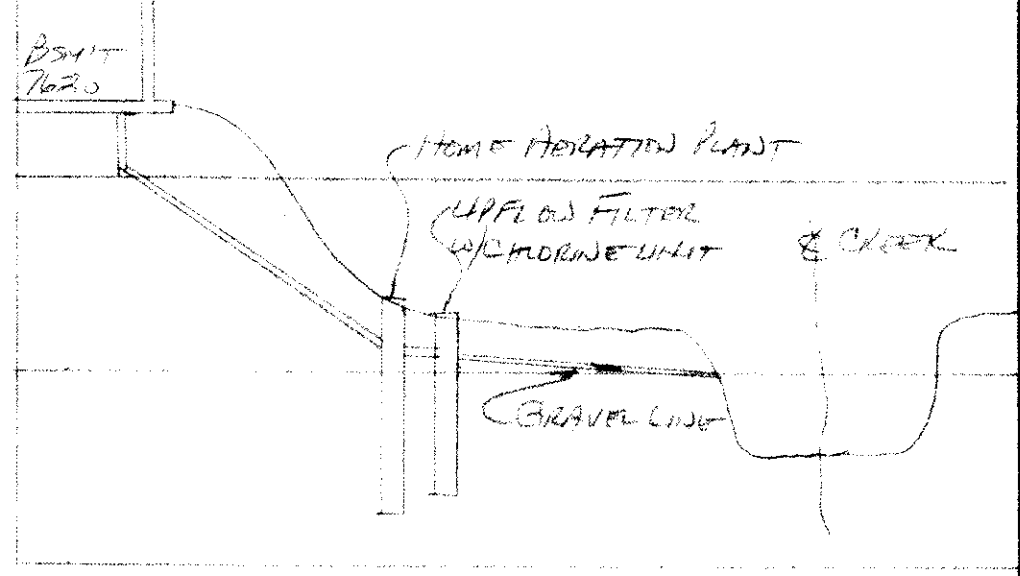

HYDRAULIC PROFILE
DATE: 1/24/87
BY: HT

PALEHILL ROAD - 60'

