


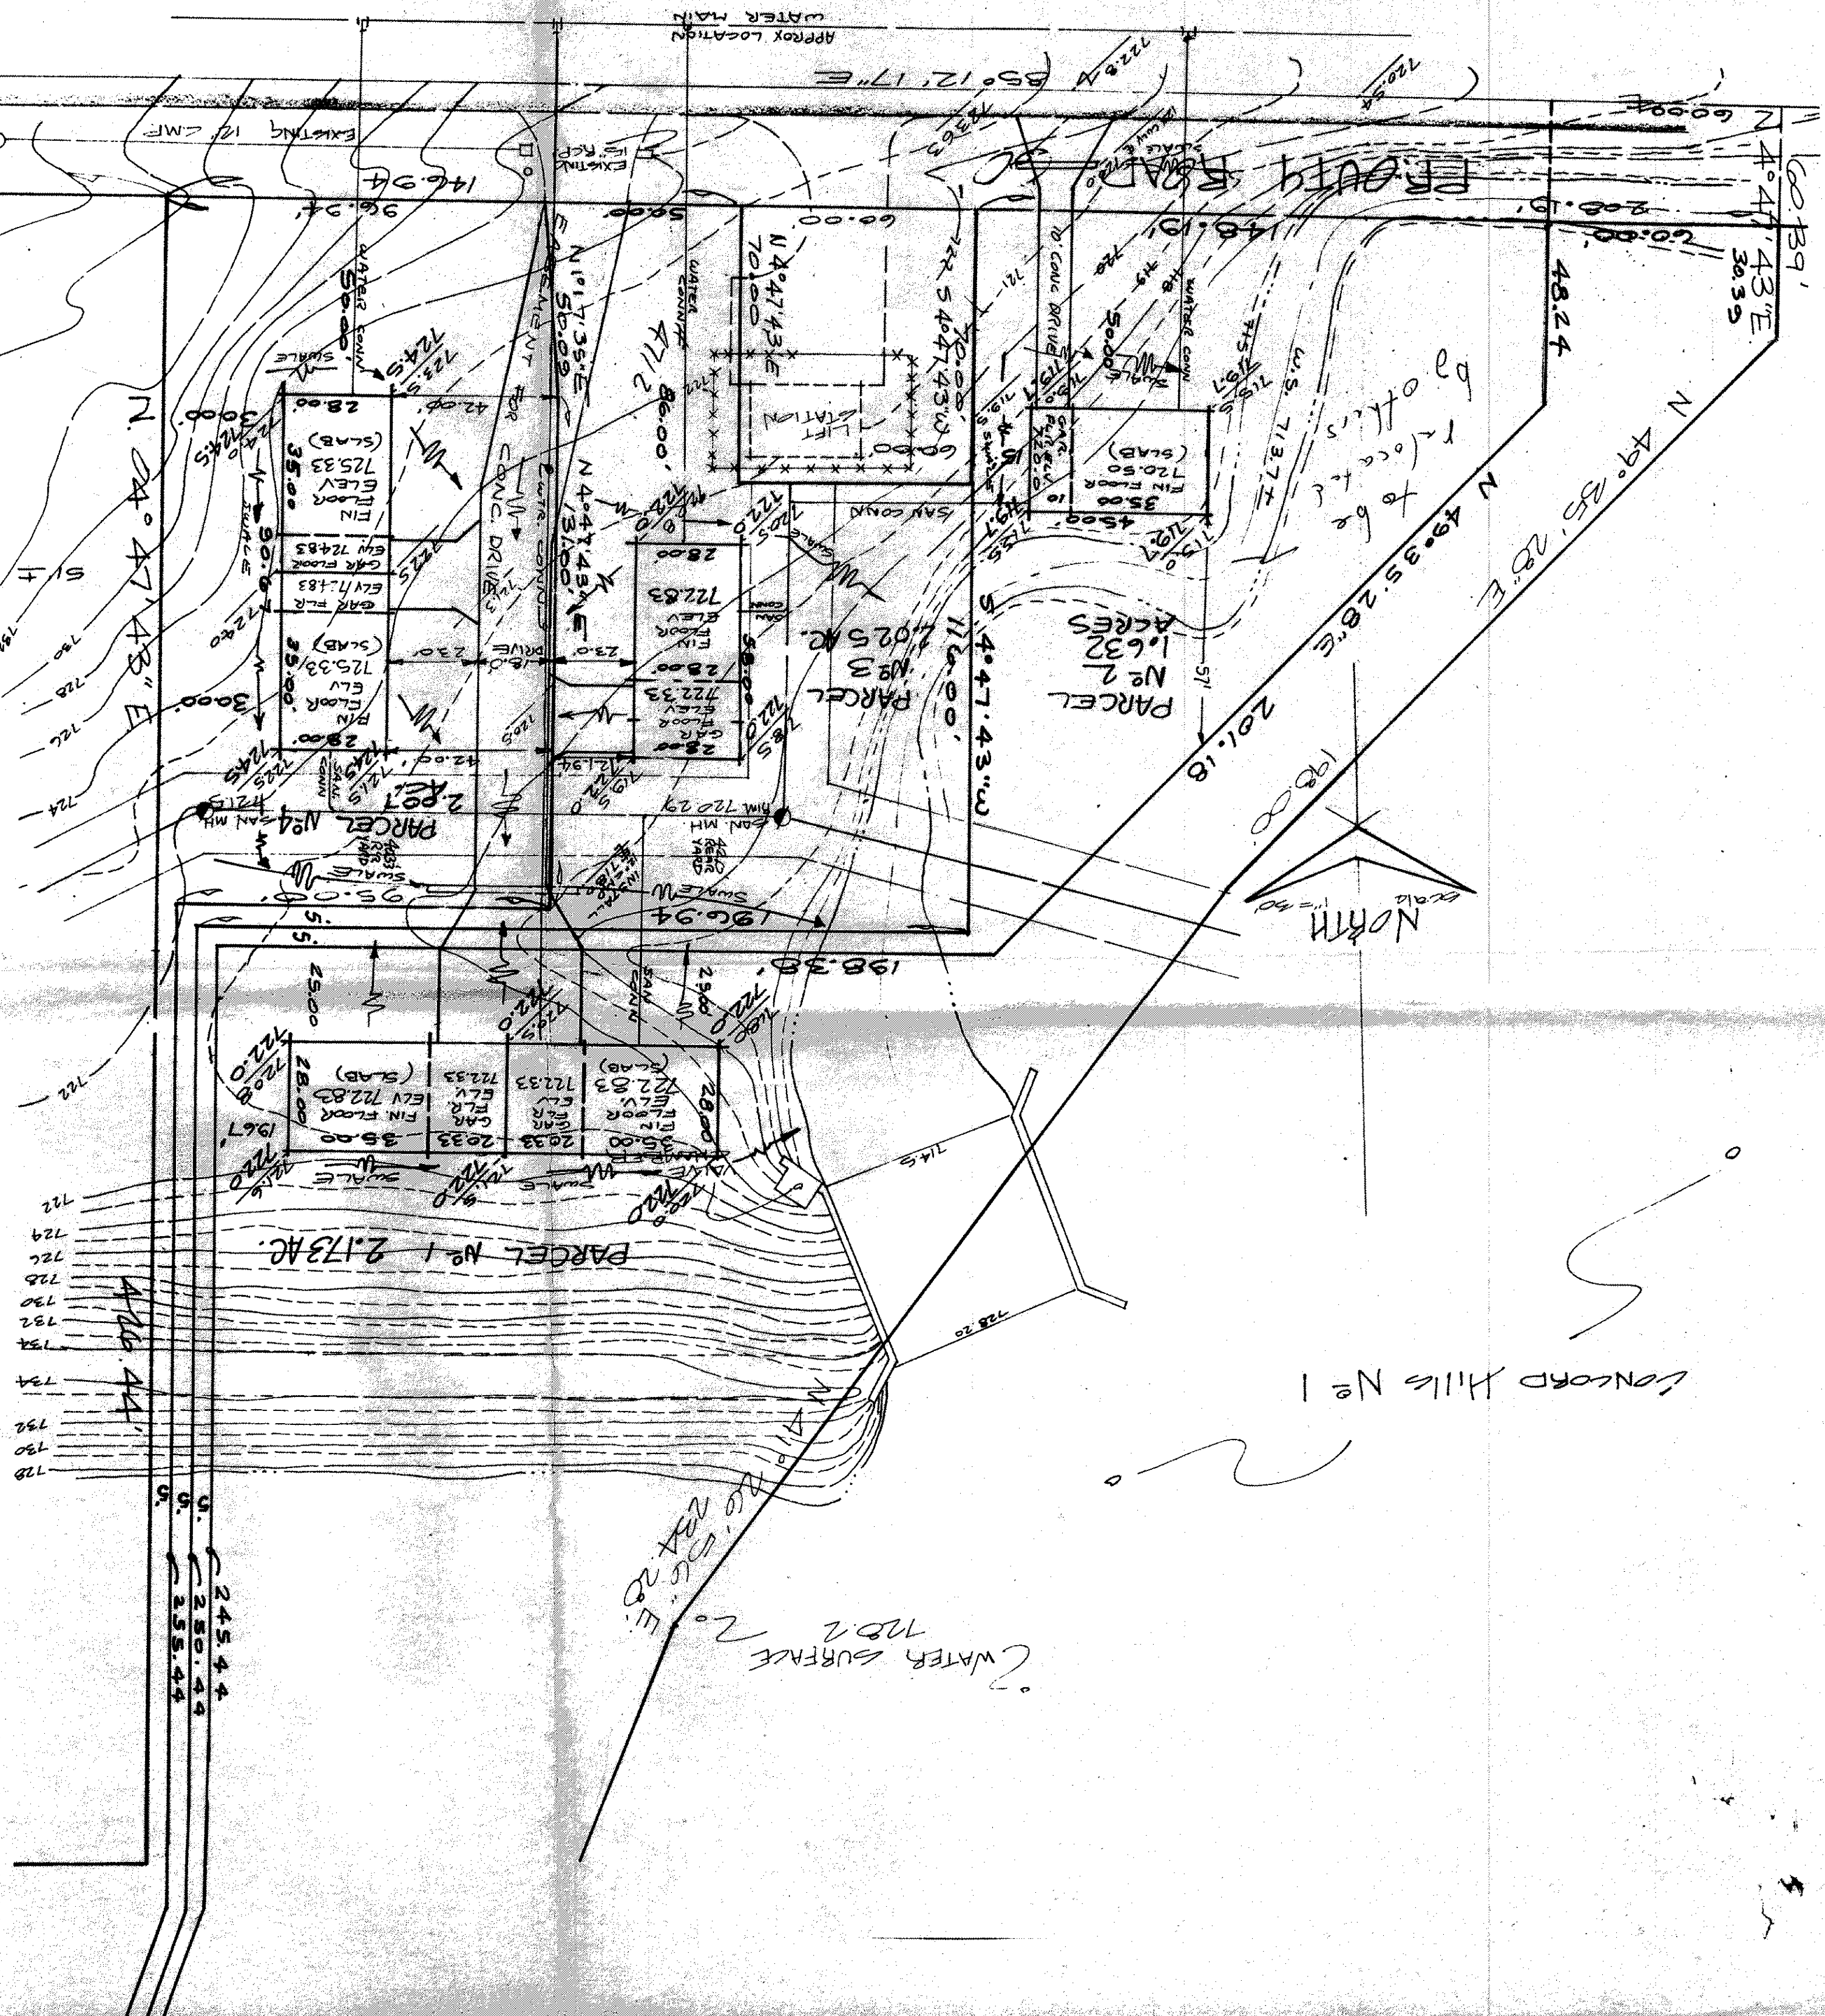

ZONING PERMIT #47123
ISSUED 9-14-83
SUBJECT TO APPROVAL BY:
☐ Lake County Sanitary Eng.
☒ Lake County Eng. Dept.
☒ Lake County Planning Comm.
☒ Lake County Bldg. Dept.

Water Comm.
to engineering
Road opening
permit
on shown and/or
as shown and/or
Lake County Eng.
Planning Comm.
Bldg. Dept.

SITE PLAN for KENNETH T. SAUL of
PART OF A 7.837 ACRE PARCEL IN ORIG LOT# 34, TRACT No. 4
CONCORD TOWNSHIP, LAKE COUNTY, OHIO

DATE SEPT 9, 83
SCALE 1"=30'
DRAWN BY [Signature]
CHECKED BY [Signature]
F.B.F.

SHEET 1 OF 1
CONTRACT NO. 83-2C3

#5
REV
9/13/83
RJB

THIS PLAN PREPARED BY
Richard J. Gilski
RICHARD J. GILSKI
REG. SURV. NO. 5244