

ZONING # 4713

Drive Culvert 15" cnp

4714

Rooter DRAINS to be wrapped
in engineering fabric

#'s 4711, 4712, 4713 & 4714


1. water Conn. to require
road opening perm. ts

2. Ditch to be relocated
by others

CONCORD Hills No 1

Grading Plan Approved -
as shown and/or noted
THOMAS P. GILLES, P.E.
Lake County Engineer

By 720 Date 26 Sept 83

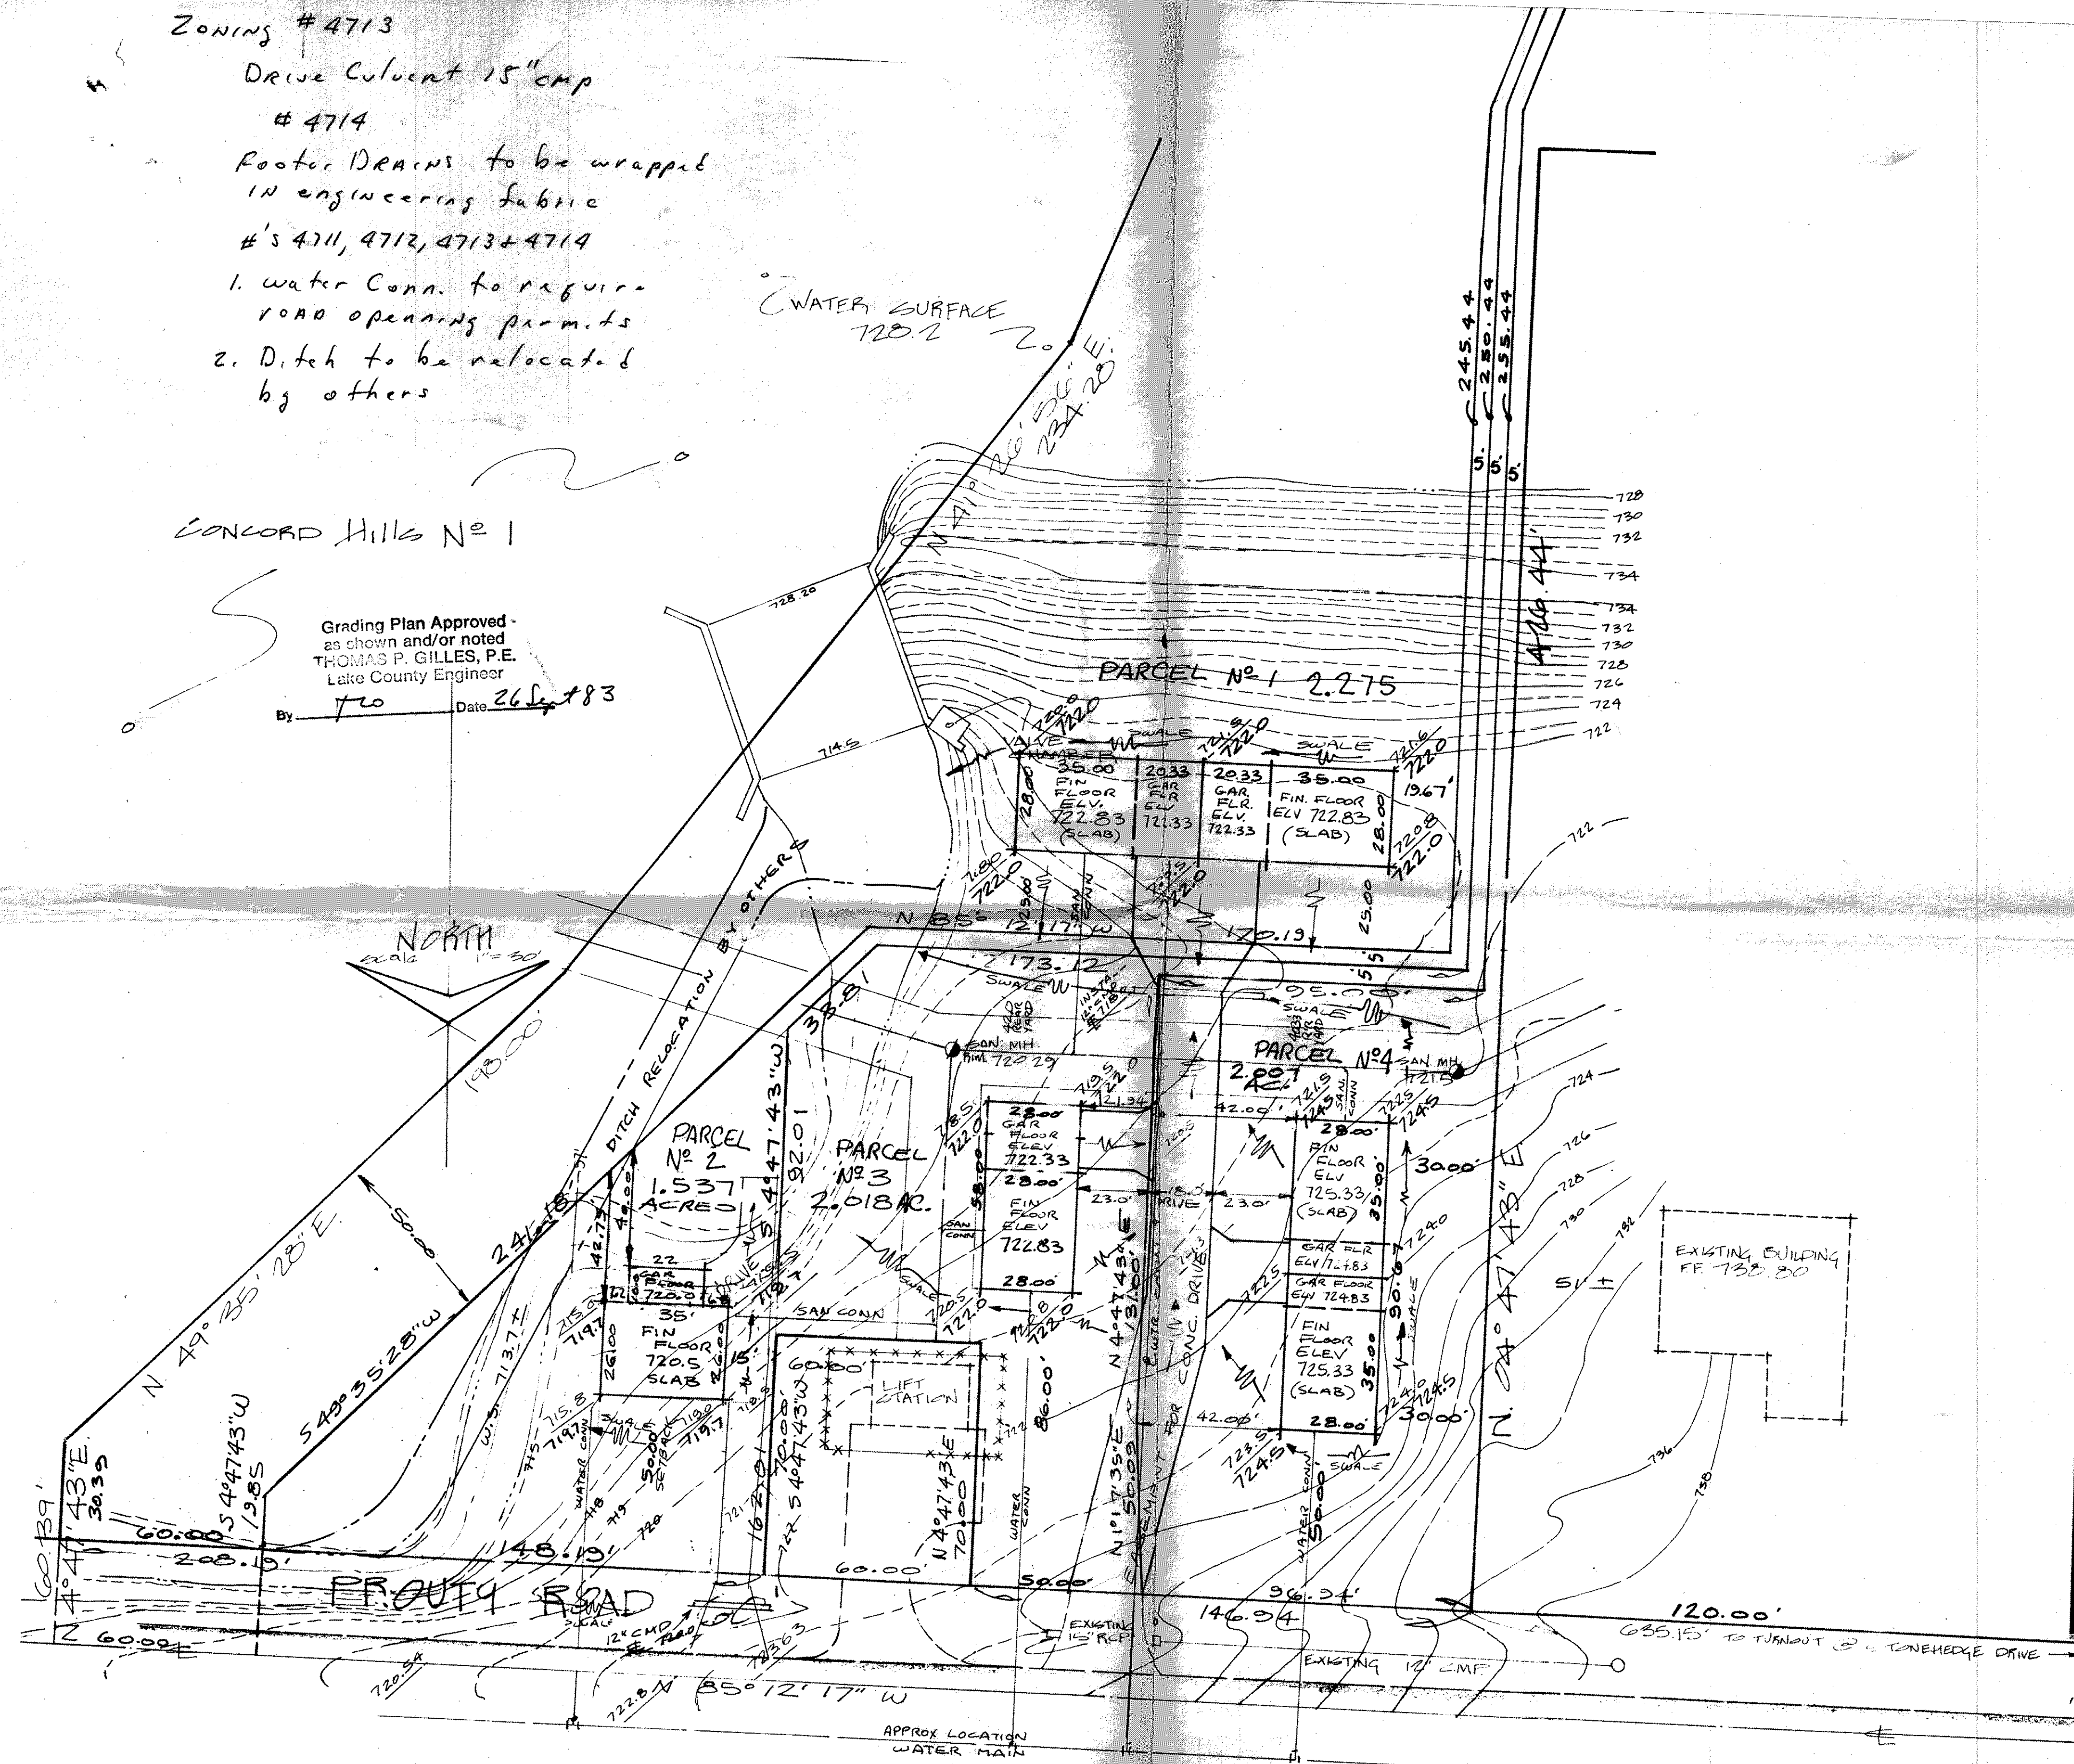

SITE PLAN for KENNETH T. SAWUL of
PART OF A 7.837 ACRE PARCEL IN ORIG. LOT# 34, TRACT # 4
CONCORD TOWNSHIP, LAKE COUNTY, OHIO

Colpetzer • Woods Consultants, Inc.
CONSULTING ENGINEERS AND SURVEYORS

DATE SEPT 9, 83
SCALE 1" = 20'
DRAWN BY [Signature]
CHKD BY [Signature]

THIS PLAN PREPARED BY
Richard J. Colpetzer
RICHARD J. GILSKI
REG. SURV. NO. 52444