




ORIG LOT N2 7 TRT N2 3
ORIG LOT 36 TRT N2 4

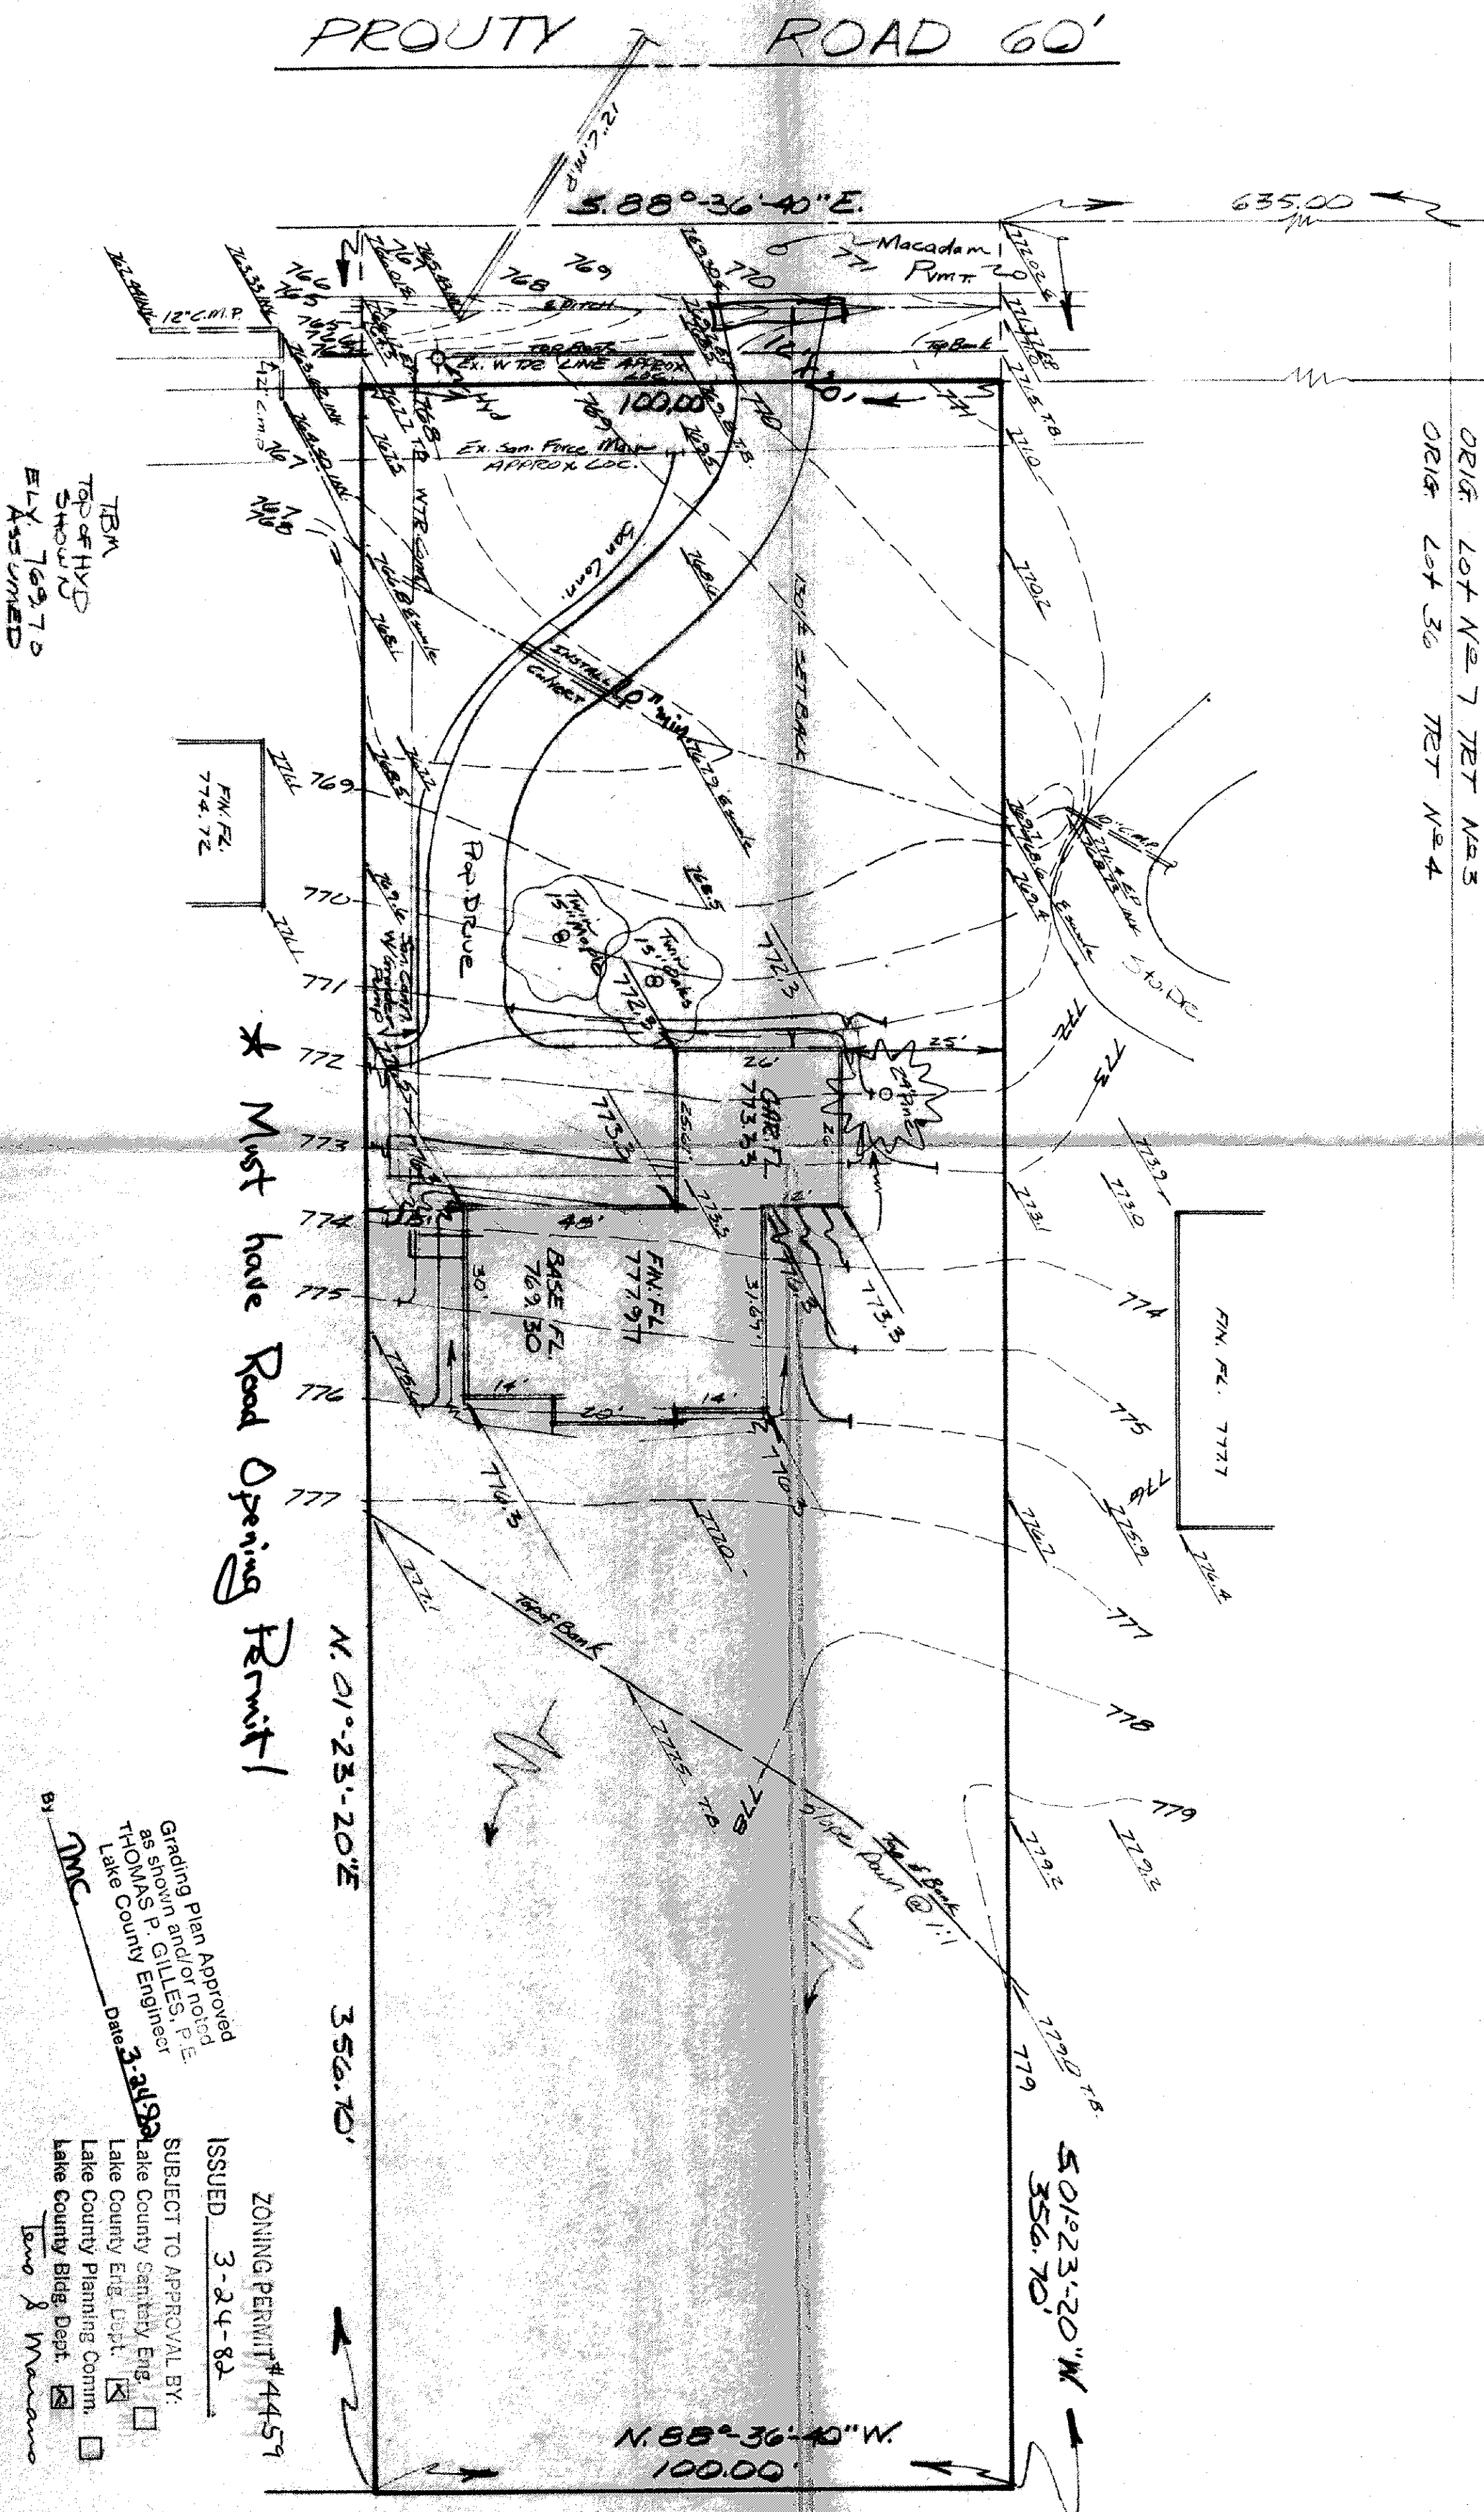

DESIGN CERTIFICATION
THIS PLAN WAS PREPARED BY ME
AND IS CORRECT TO THE BEST OF
MY KNOWLEDGE AND BELIEF

AS BUILT CERTIFICATION
I HEREBY CERTIFY THAT THE CIRCLED GRADES
ARE EXISTING FINISH GRADES CHECKED IN THE
FIELD ON
DATE 1-20-81
BY JWB
THIS SURVEY IS CORRECT TO THE BEST OF MY
KNOWLEDGE AND BELIEF

SITE PLAN for
J.W. BETTELEY BUILDERS
OF 0.819 Acres Being Part of Orig Lot 36 Tract No. 4
Concord Township, Lake County, Ohio

COLPETZER WOODS
CONSULTANTS, INC.
MENTOR, OHIO 44060

Grading Plan Approved
and/or noted
as shown P. GILLES, P.E.
THOMAS P. GILLES, Engineer
Lake County Engineer
Date 3-24-82

SUBJECT TO APPROVAL BY:
☐ Lake County Sanitary Eng.
☐ Lake County Eng. Dept.
☐ Lake County Planning Comm.
☒ Lake County Bldg. Dept.
Law & Mariano

ISSUED 3-24-82
ZONING PERMIT #4459

DATE 1-20-81
BY JWB

CONTRACT NO. 82-033