

ZONING PERMIT #0798-9153

ISSUED 7/2/58

SUBJECT TO APPROVAL BY:

Lake County Sanitary Eng. ☐

Lake County Eng. Dept. ☒

Lake County Planning Comm. ☐

Lake County Bldg. Dept. ☒


Grading Plan Approved
by Town and/or County
T. J. AS P. GILLES
Lake County Engineer

By GJH Date 7.23.98
Road right-of-way
permit required.

NOTE: NO EXIST. SANITARY
WYE. - MAN NEEDS
TO BE SADDLED &
BURNED REW'D.

"I, the undersigned hereby certify that this topography indicated by 6", 1" or 2" contours, and elevations shown hereon represent an actual field survey made by me on the 10th day of July, 1998 and that the elevations were taken at appropriate intervals and that as of that date they existed as indicated hereon."

Name Harry Jones #6343 Reg. No. _____

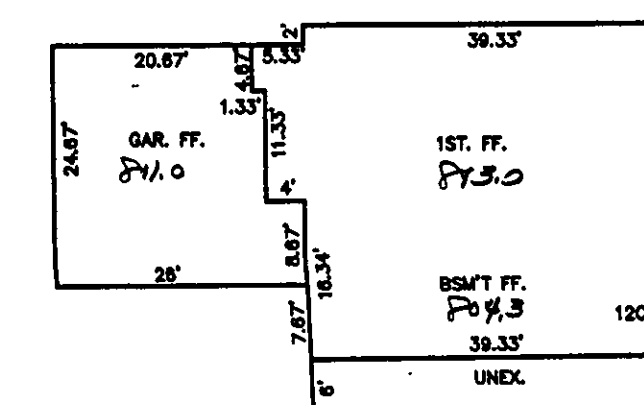

TBM-SANITARY MH.
RIM=798.56

[illegible]

b7c

BABCOCK, JONES AND ASSOCIATES, INC
CIVIL ENGINEERS - SURVEYORS - LAND PLANNERS
PAINESVILLE OHIO 44077

DATE	7/13/98
DESIGN BY	H.J.
DRAWN BY	T.R.
APPROVED BY	H.J.

SITE PLAN
FOR
MRS. PEARCE

CONCORD TWP.

SCALE	1"=30'	
JOB NO	98-	224
SHEET	1	OF 1

PROUTY ROAD - 60'