


MAREWOOD PLACE - 60'

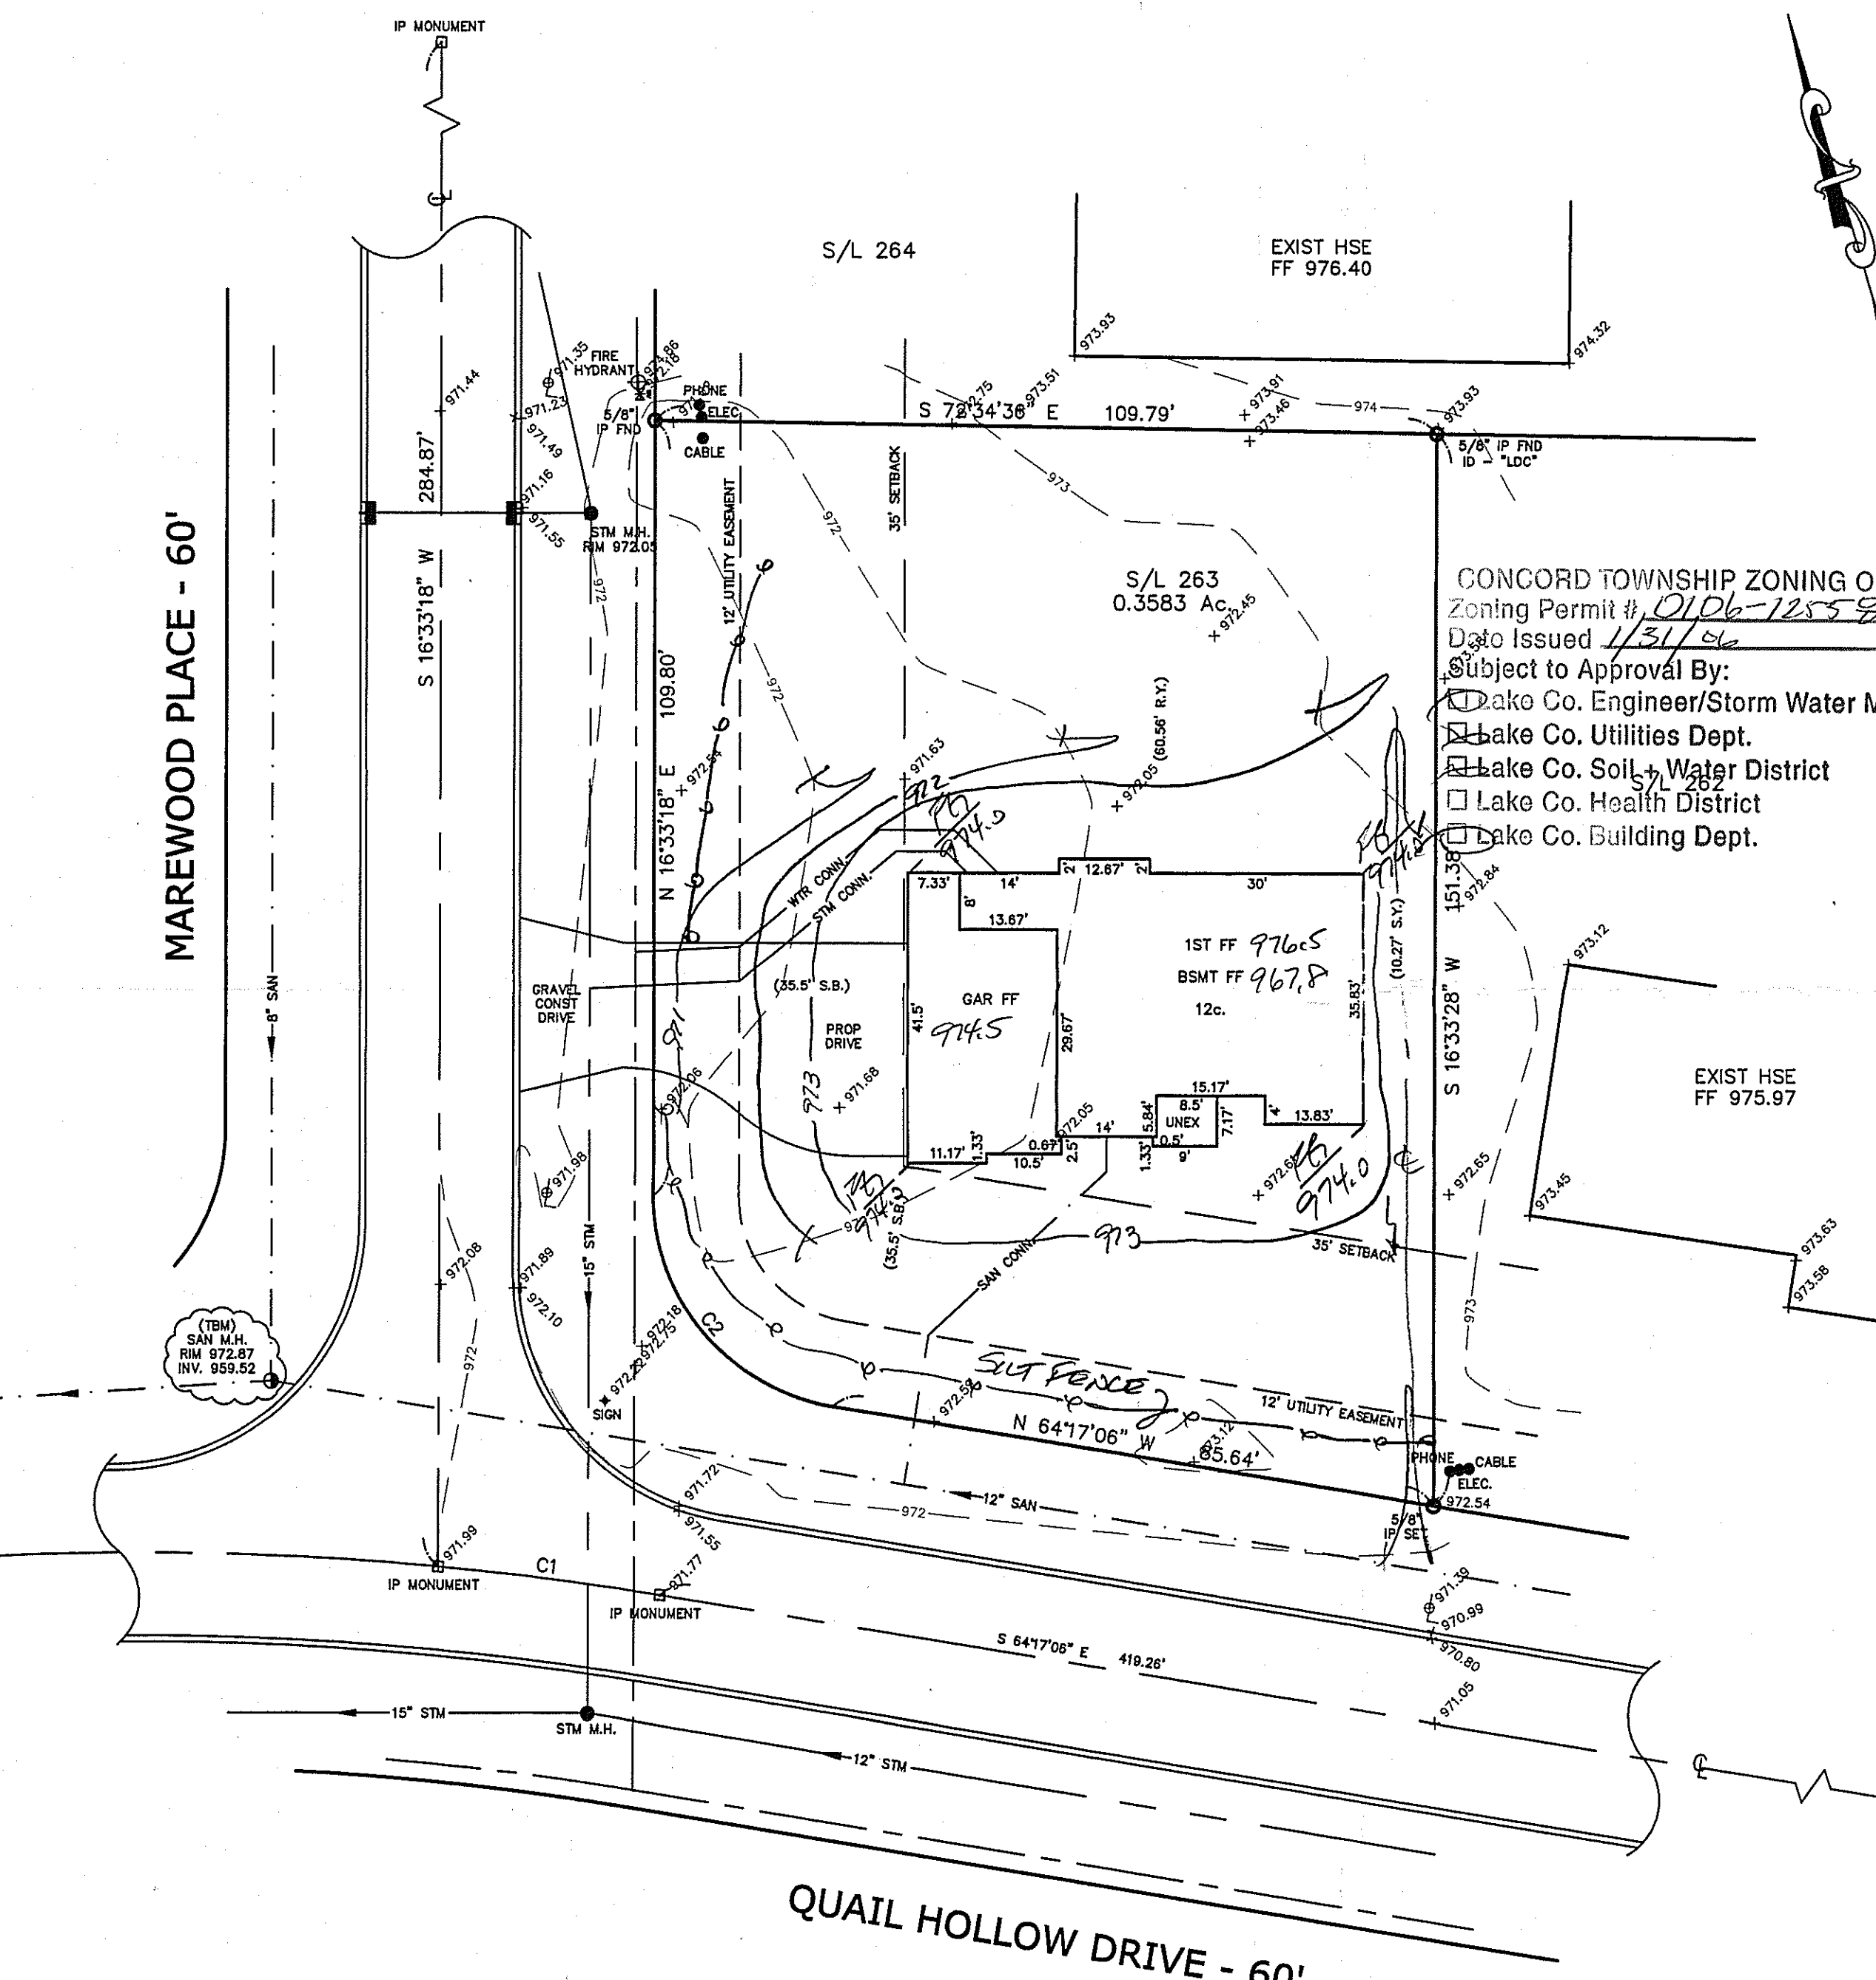

| CURVE TABLE | | | | | |
|-------------|--------|--------|---------|-------|-------------|
| CURVE | LENGTH | RADIUS | TANGENT | CHORD | BEARING |
| C1 | 31.35 | 450.00 | 15.68 | 31.34 | N66°15'51"W |
| C2 | 42.32 | 30.00 | 25.55 | 38.90 | S23°51'54"E |

1
2

Water Management Plan
Approved as shown and/or noted
JAMES R. GILLS, P.E.
County Drainage Engineer
By L.S. Date 1/31/06

SITE PLAN

CONCORD TWP., LAKE COUNTY, OHIO
for: HANDCRAFTED HOMES
CLIENT _____ OWNER _____
ADDRESS _____ STREET _____ CITY _____ ZIP _____

QUAIL HOLLOW #9
SUBDIVISION 46-32 NAME _____ TRACT _____ STREET _____
VOL.-PG. 263 LOT _____
SUBLOT NO. 263 STREET MAREWOOD & QUAIL VOL.-PG. _____ PERM. PARCEL NO. _____

LEGEND
SANITARY MANHOLE --- --- EXIST. ELEV. 100.0 PROP. ELEV. 100.0
STORM MANHOLE --- --- AS BUILT ELEVATION
INLET OR CATCH BASIN --- --- INDICATES
HYDRANT --- --- DIRECTION OF
EXISTING CONTOURS --- --- SURFACE DRAINAGE
PROPOSED CONTOURS ---

REMARKS
ALL BOUNDARY DATA SHOWN WAS OBTAINED FROM (DEEDS, RECORDED
SUBDIVISION PLAT OR OTHER PUBLIC RECORDS)
LOCATIONS AS SHOWN OF ADJACENT WELLS AND SEPTIC TANKS OBTAINED FROM
LAKE COUNTY HEALTH DEPARTMENT

DESIGN CERTIFICATION
THIS PLAT WAS PREPARED BY ME, AND IS CORRECT
TO THE BEST OF MY KNOWLEDGE AND BELIEF.
Harry S. Jones, Jr. #6343
NAME _____ SURVEYOR _____ REGISTRATION NO. _____

CHECK LIST
NO. OF BEDROOMS _____
DIMENSIONS _____
TIE TO NEAREST STREET _____
SUBLOT NO. PARCEL NO. _____
SURROUNDING OWNERS _____
BLDG. DIMENSIONS FIN GR. _____
BLDG. TIES FL'R. GRADES _____
APRON TYPE WIDTH THICKNESS _____
SIDEWALK TYPE WIDTH THICKNESS _____
CULVERT TYPE DIA., LENGTH _____
ROCK OUTCROPPINGS _____
WATER MAIN SIZE, LOCATION _____
SAN. SEWER SIZE & GR. LOC. _____
SAN. MH. CAST. ELEV. INV. ELEV. _____
SAN. CONN. SIZE, LOC. DEPTH _____
STORM SEWER SIZE & GR. LOC. _____
STORM MH. CAST. ELEV. INV. ELEV. _____
PAV'T TYPE GRADE CURBS _____
GAS LINE LOC. SIZE PRESSURE _____
SEPTIC TANK LOCATION & DUPLICATION AREA _____
WELL LOCATION _____
ISOLATION RADIUS FROM WELL _____

| REVISIONS | | | PLAN PREPARED BY: | | |
|-----------|------|----|------------------------------------|--------------|------------------------|
| NO. | DATE | BY | BABCOCK - JONES & ASSOCIATES, INC. | | |
| 1 | | | PAINESVILLE, OHIO | | |
| 2 | | | | | |
| 3 | | | DRAWN BY B.P. | SCALE 1"=20' | PHONE NO. 440-357-1811 |
| 4 | | | CHK'D. H.J. | DATE 1/19/06 | DRAWING NO. |
| 5 | | | CREW CHIEF W.B. | APP'D H.J. | 03-236-263 |

"AS BUILT" CERTIFICATION
I, HEREBY CERTIFY THAT THE CIRCLED GRADES ARE EXISTING
FINISH GRADES CHECKED IN THE FIELD ON _____, 20____
AND ARE CORRECT TO THE BEST OF MY KNOWLEDGE AND BELIEF.

REGISTERED SURVEYOR _____ REG. NO. _____

TBM - SANITARY MANHOLE
ELEV - 972.87

NOTE: ALL IRON PINS SET ARE
5/8" X 30" AND ARE CAPPED
BABCOCK, JONES & ASSOC.

EXISTING UTILITIES NOTE:
THE SIZE AND LOCATION, BOTH HORIZONTAL AND VERTICAL
OF THE UNDERGROUND UTILITIES SHOWN HEREON, HAVE BEEN
OBTAINED BY A SEARCH OF AVAILABLE RECORDS.
VERIFICATION BY FIELD OBSERVATION HAS BEEN CONDUCTED
WHERE PRACTICAL, HOWEVER, BABCOCK, JONES AND ASSOCIATES
INC. DOES NOT GUARANTEE THE COMPLETENESS NOR ACCURACY
THEREOF.

