

SITE PLAN FOR:

RYAN HOMES
7660 CHIPPEWA ROAD
BRECKSVILLE, OHIO

BEING SUBLAT NO. 19 IN REVERE WOODS
SUBDIVISION NO. 2 IN CONCORD TWP, OHIO

PREPARED BY:

WM. R. GRAY ASSOC, INC.
ENGINEERS & SURVEYORS
7547 MENTOR AVENUE
MENTOR, OHIO

DATE: SEPT. 6, 1973

SCALE: 1" = 30'

CERTIFICATION:

I HEREBY CERTIFY THAT THIS PLAT IS
CORRECT TO THE BEST OF MY KNOWLEDGE

By: *Wm. R. Gray*
WM. R. GRAY RS 2152 DE 6421
2752


Grading Plan
as shown and/or noted
THOMAS P. GILLES, P.E.
Lake County Engineer

By *JWK* Date 9-17-73

NOTE:

ALL INFORMATION PERTAINING TO UTILITIES &
PAVEMENT IS SUBJECT TO AS-BUILT CONDITIONS.


Grading Permit #2572
issued 9-13-73
JWK

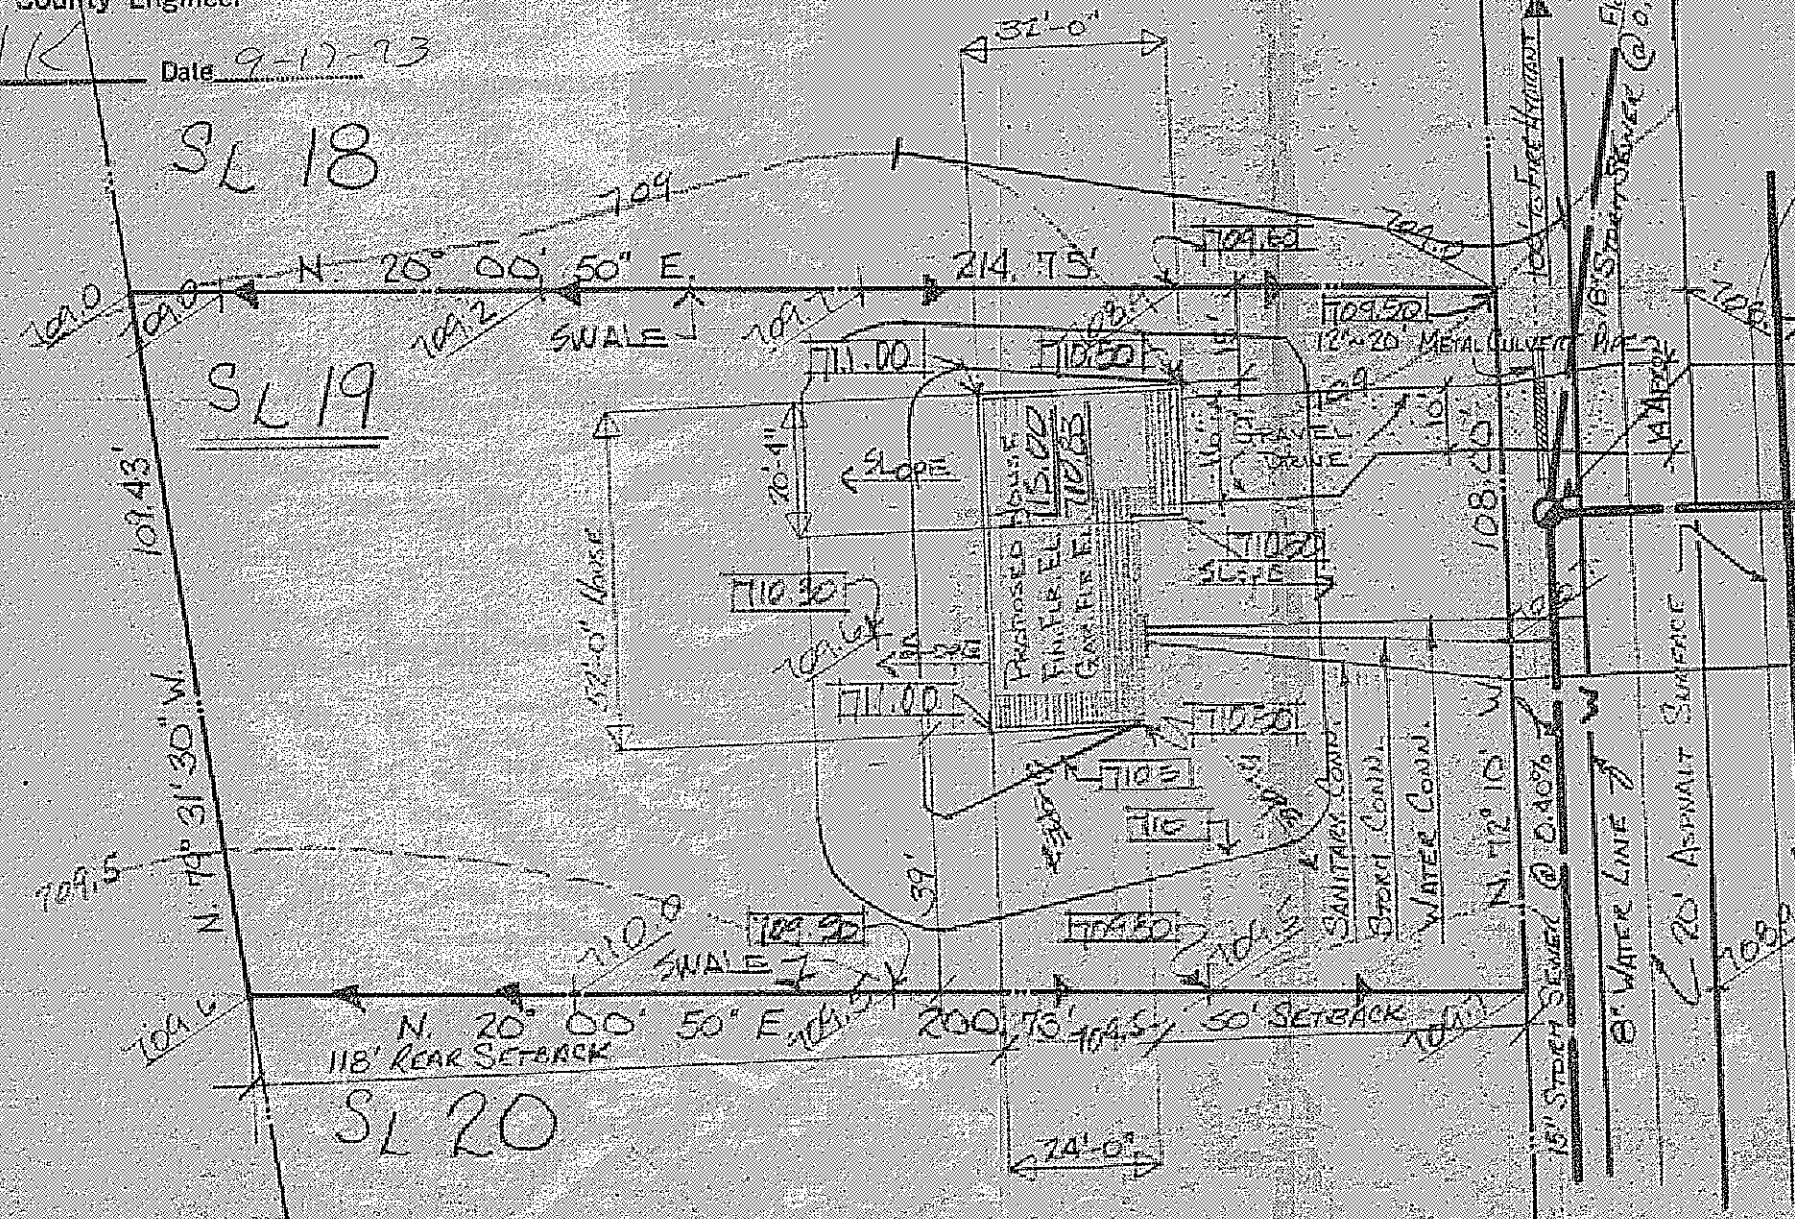

STORM MANHOLE (INLET)
R.H. EL. 107.50
I.N.V. EL. 104.85
104.60

Grading Plan
as shown and/or noted
THOMAS P. GILLES, P.E.
Lake County Engineer

By *JWK* Date 9-17-73

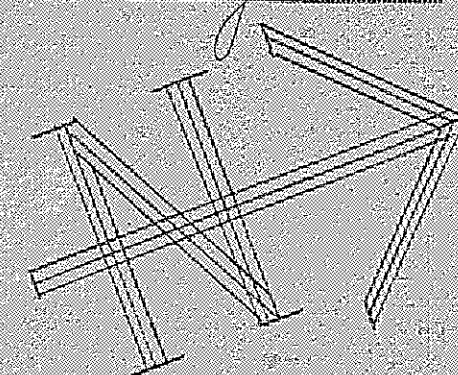

SANITARY MANHOLE
R.H. EL. 69.71
I.N.V. EL. 69.71

REVERE COURT