

TE PLAN FOR:

YAN HOMES
3600 MERCANTILE ROAD
EACHVIEW, OHIO

ING SUBLOT No. 20 & No. 21 IN THE
EVERE WOODS SUBDIVISION No. 2 IN
CONCORD TOWNSHIP, OHIO.

PREPARED BY:

WM. R. GRAY ASSOC., INC.
7547 MENTOR AVENUE
MENTOR, OHIO


DATE: SEPT. 24, 1973 SCALE: 1"=20'

ENGINEERS
SURVEYORS

CERTIFICATION:

I HEREBY CERTIFY THAT THIS PLAN IS CORRECT
TO THE BEST OF MY KNOWLEDGE.

By: Wm. R. Gray
WM. R. GRAY REG. SURV. # 2752

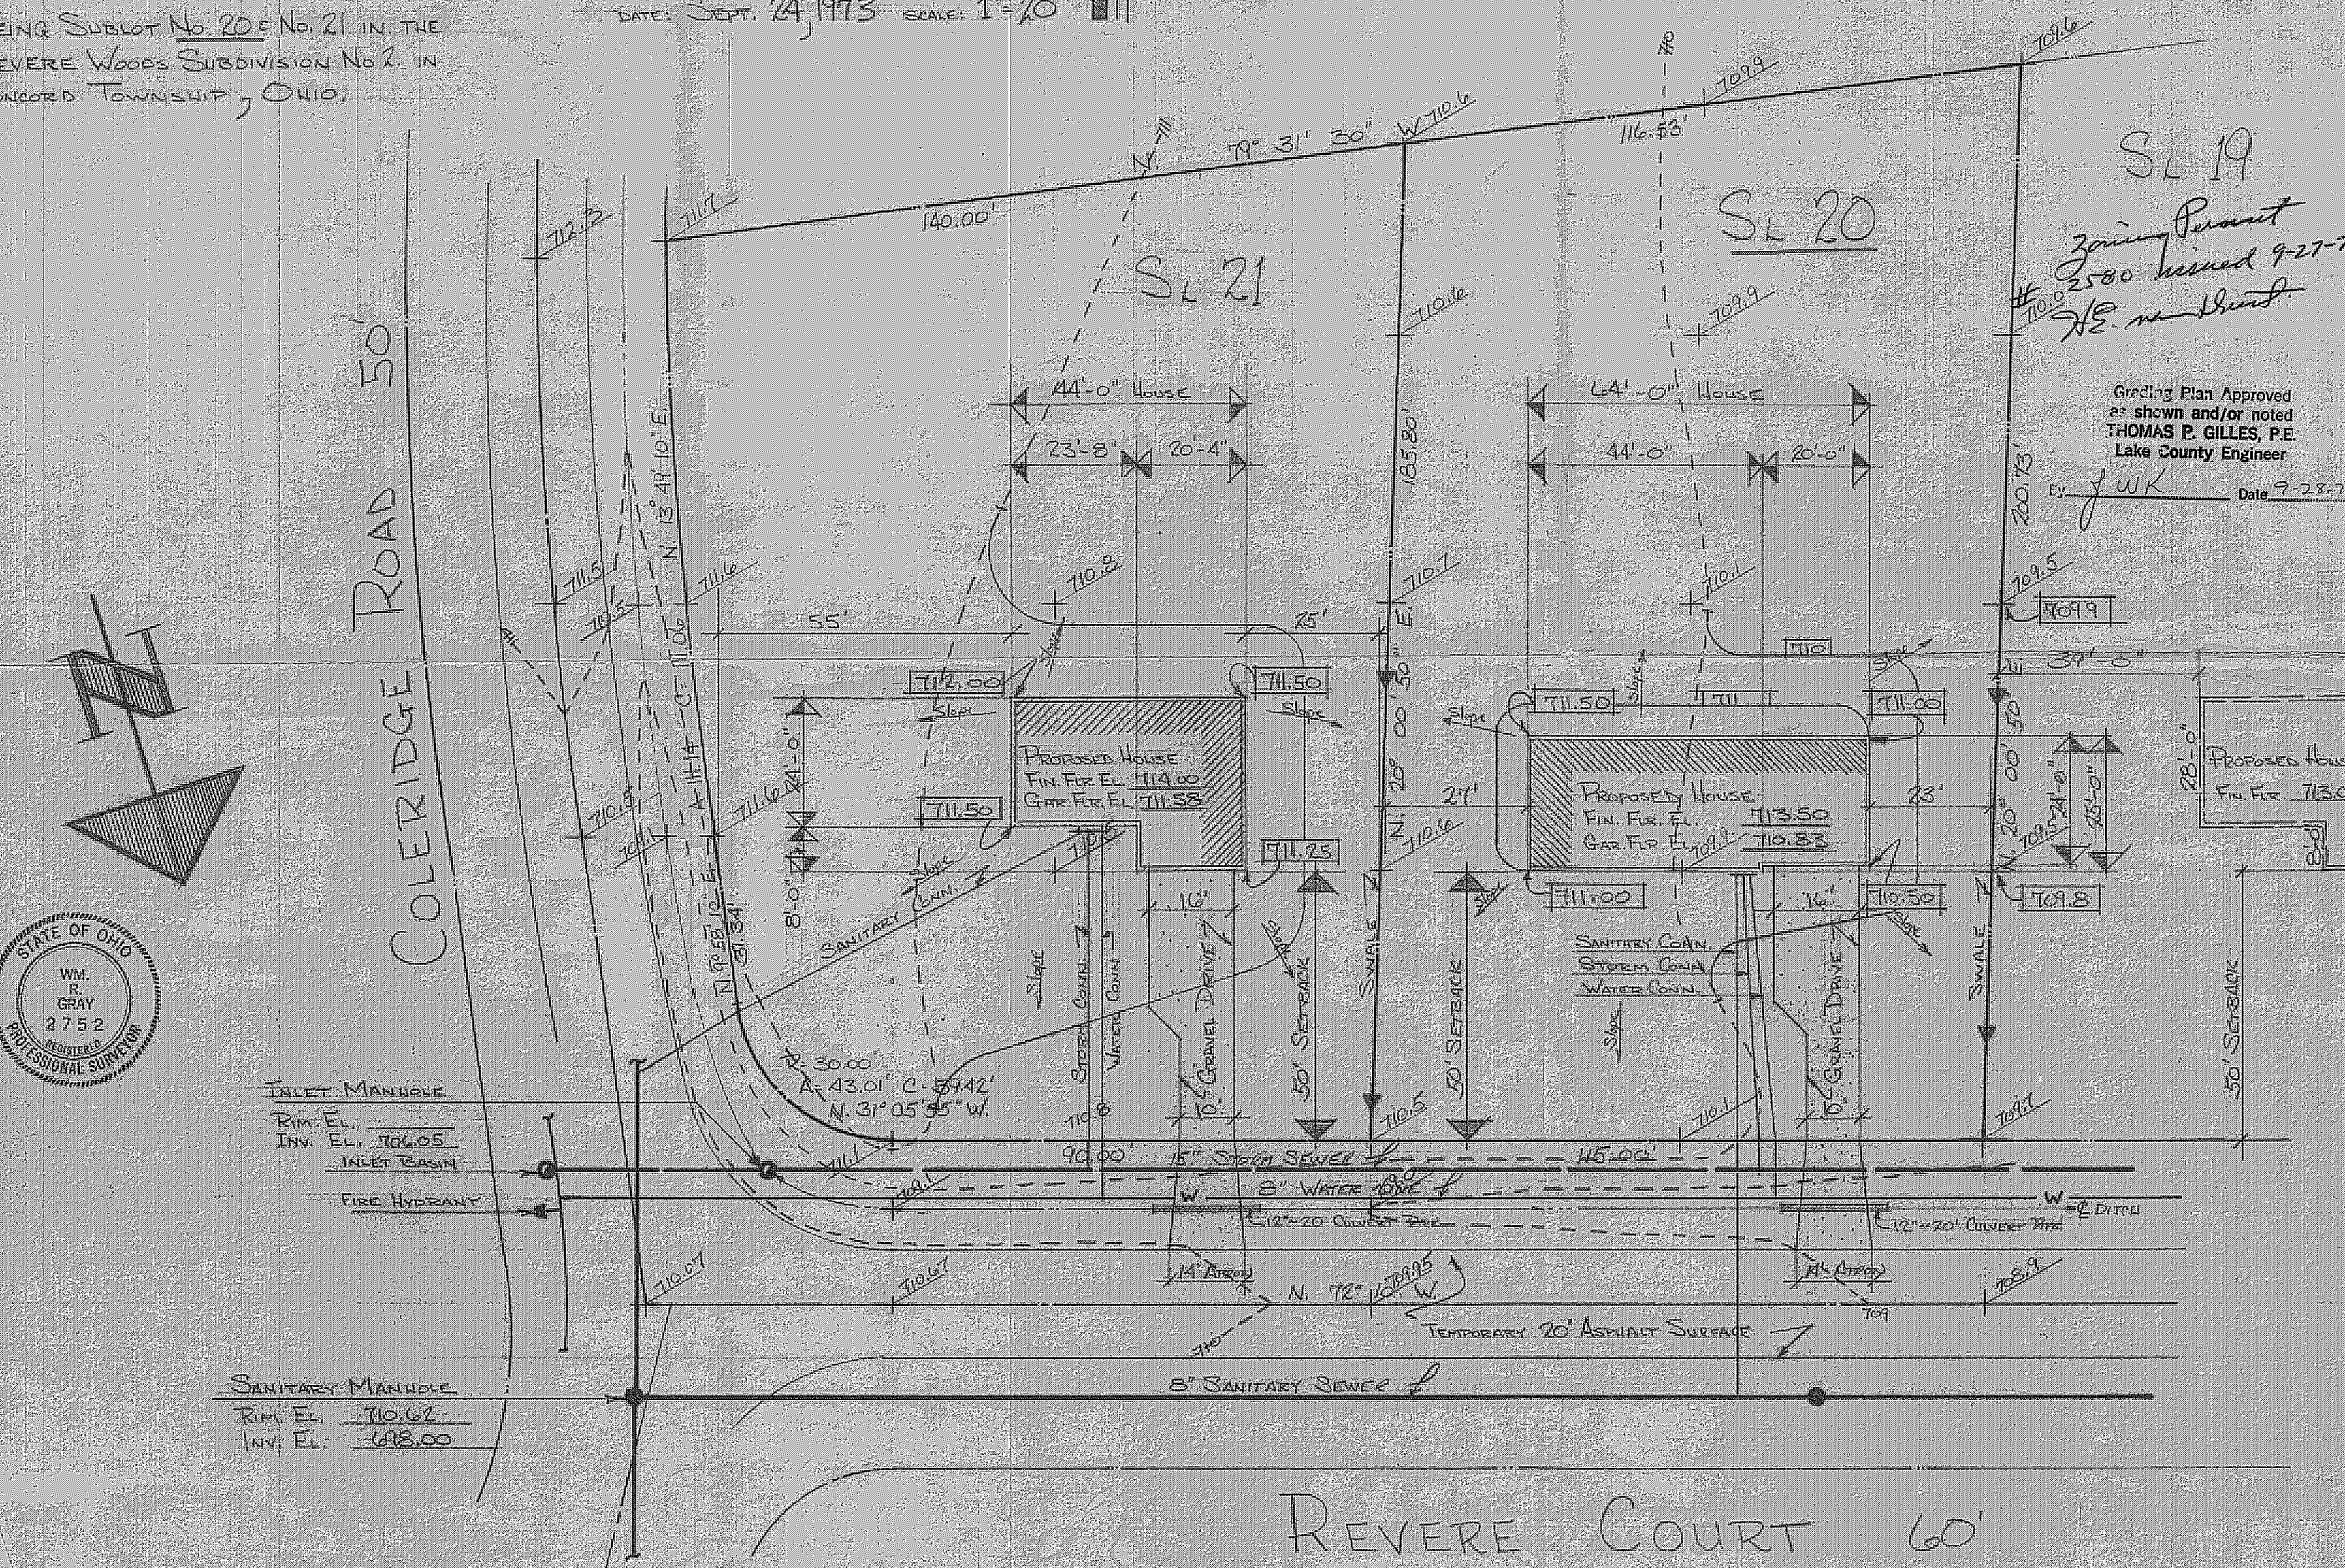

SL 19

SL 20

SL 21

Joining Permit
2580 issued 9-27-73
J.E. M. M. M.

Grading Plan Approved
as shown and/or noted
THOMAS P. GILLES, P.E.
Lake County Engineer

Date 9-28-73

