



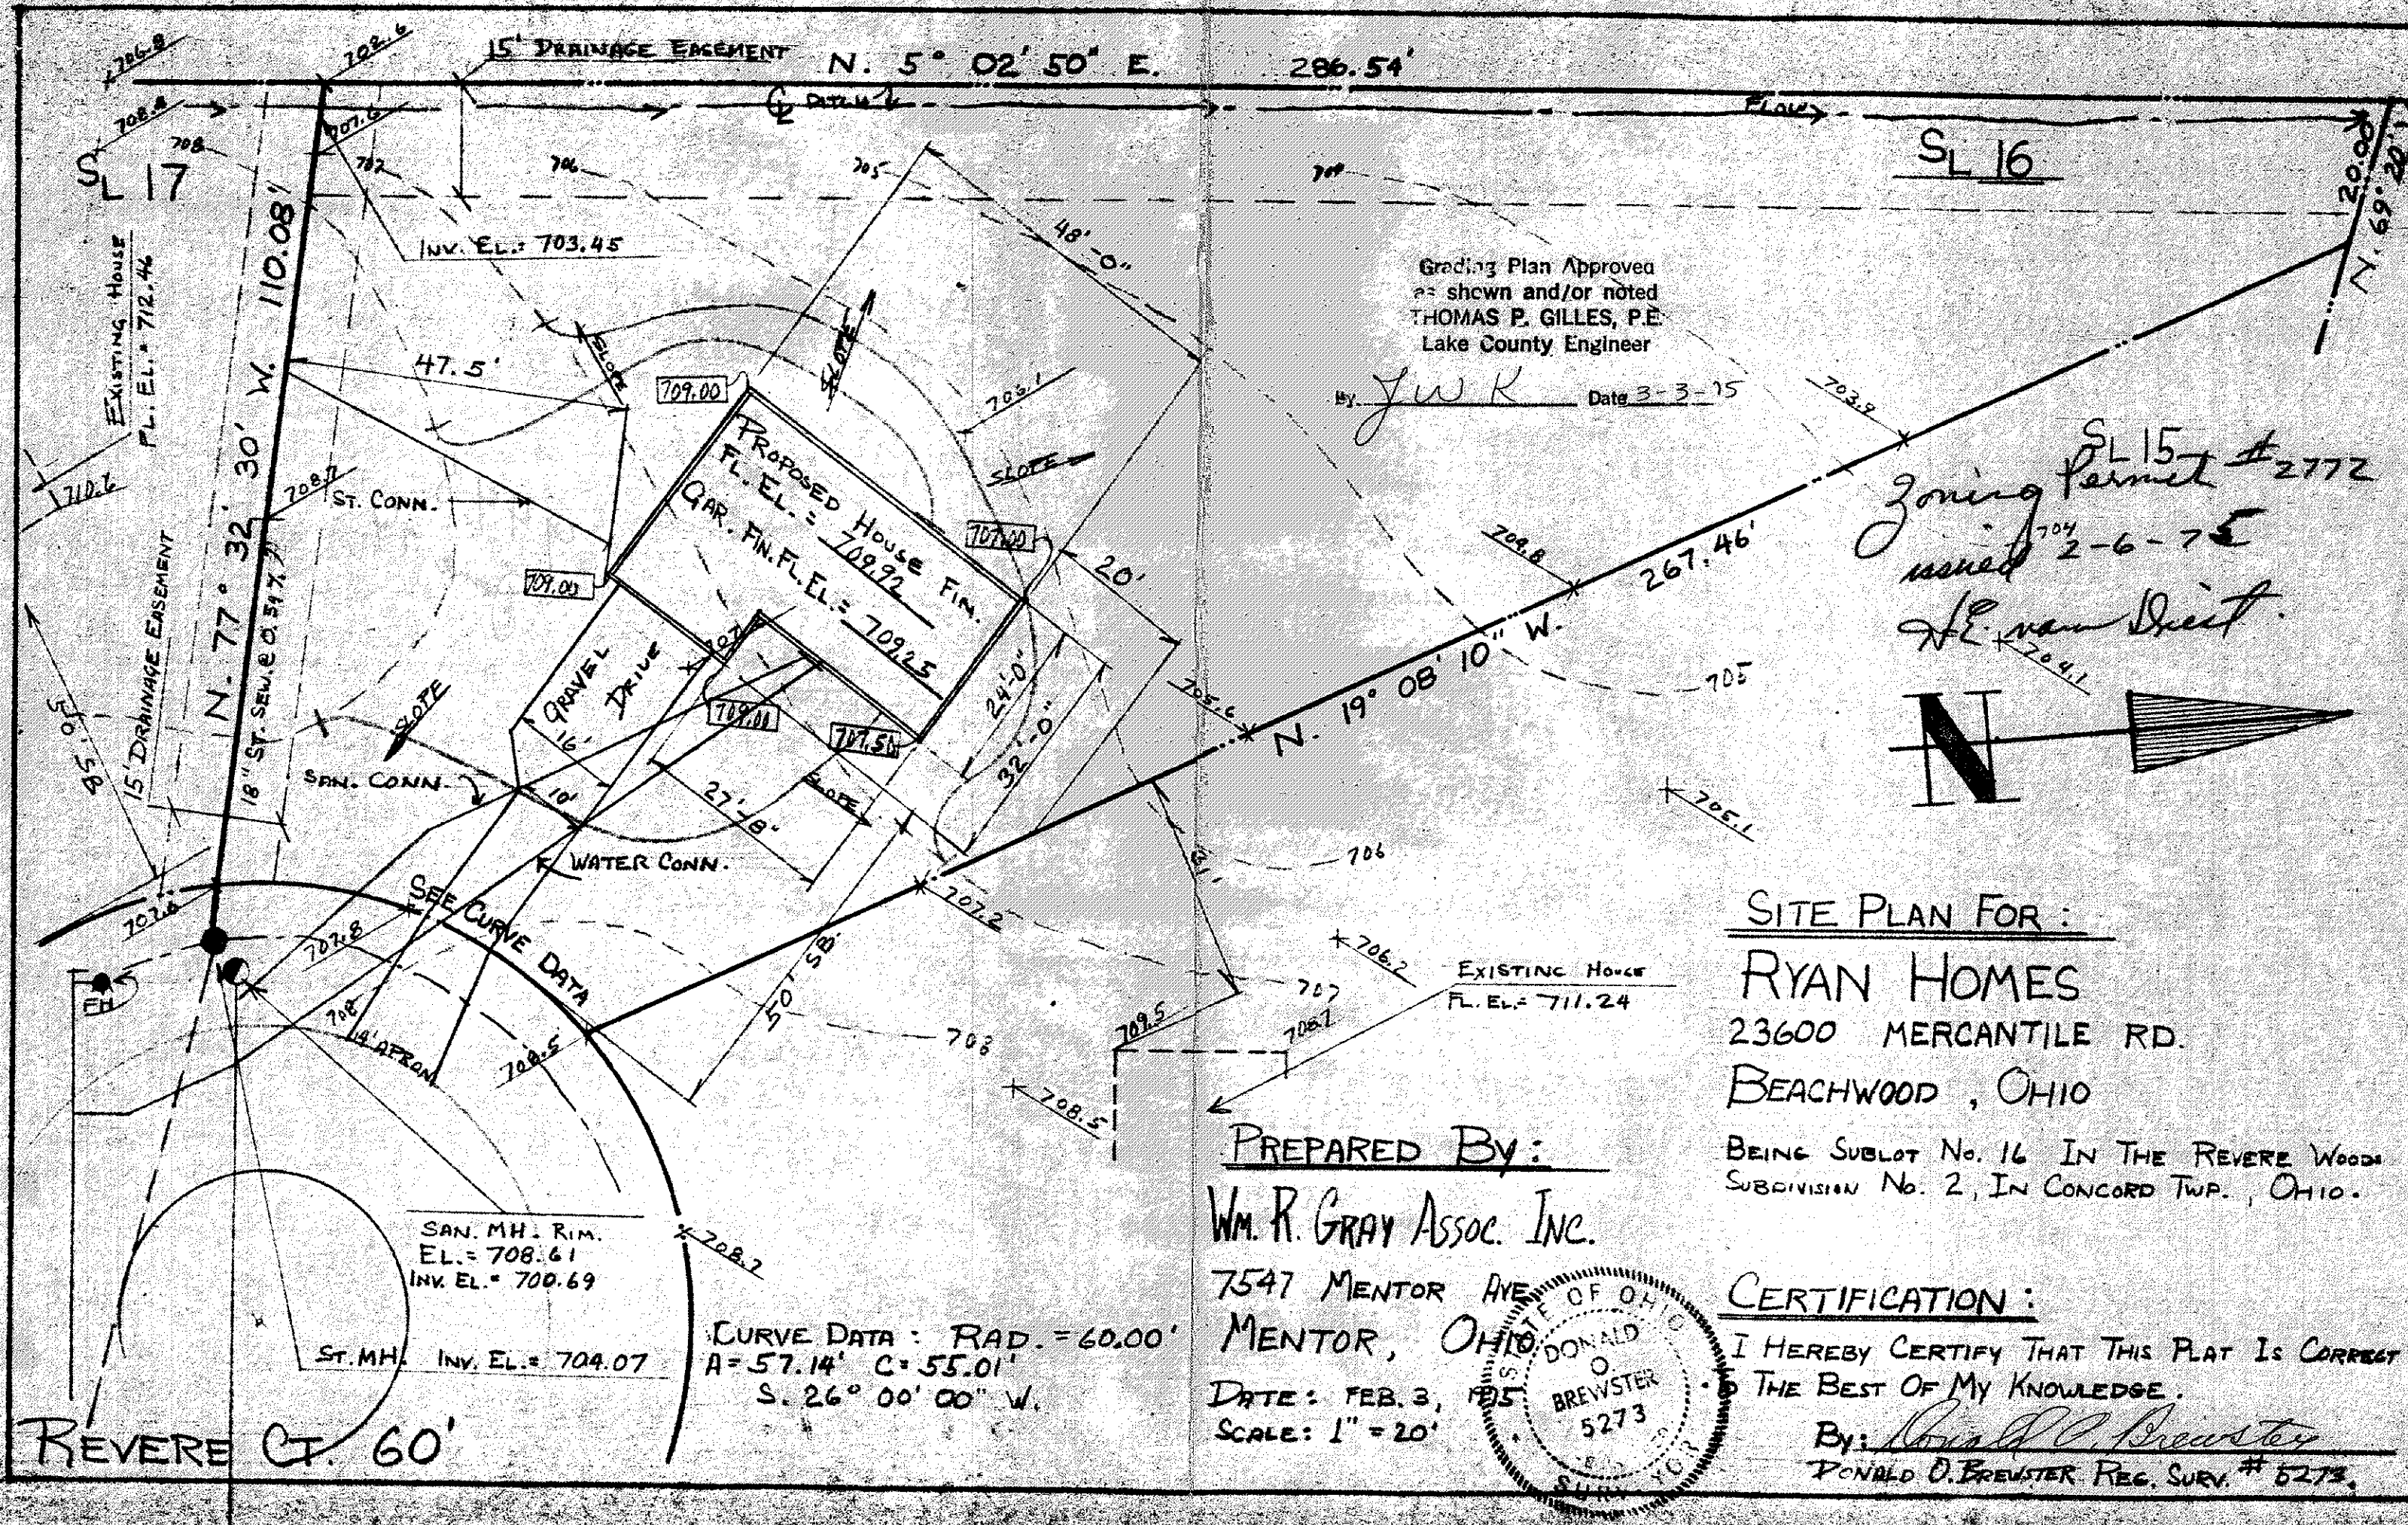

Grading Plan Approved
as shown and/or noted
THOMAS P. GILLES, P.E.
Lake County Engineer

By *JWR* Date 3-3-75

SL 15-2772
issued 2-6-75
H.E. van Driel

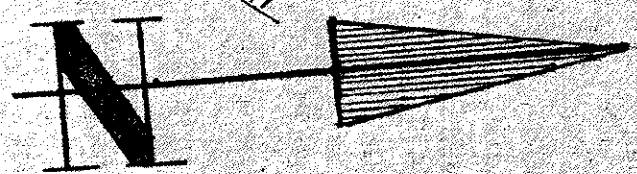


SITE PLAN FOR:
RYAN HOMES
23600 MERCANTILE RD.
BEACHWOOD, OHIO

BEING SUBLLOT No. 16 IN THE REVERE WOODS
SUBDIVISION No. 2, IN CONCORD TWP., OHIO.

PREPARED BY:
WM. R. GRAY Assoc. Inc.

7547 MENTOR AVE.
MENTOR, OHIO
DATE: FEB. 3, 1975
SCALE: 1" = 20'

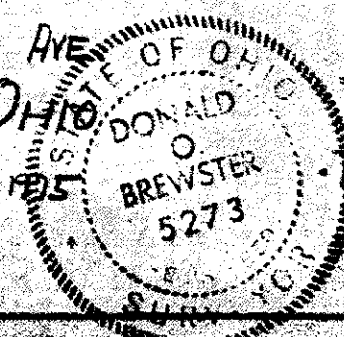

CERTIFICATION:
I HEREBY CERTIFY THAT THIS PLAT IS CORRECT
TO THE BEST OF MY KNOWLEDGE.

By: *Donald O. Brewster*
DONALD O. BREWSTER, REG. SURV. # 5273.

REVERE CT. 60'