

SITE PLAN FOR:

RYAN HOMES
23600 MERCANTILE ROAD
BEACHWOOD, OHIO


BEING SUBLT NO. 17 IN REVERE WOODS SUBDIVISION
NO. 2 IN CONCORD TOWNSHIP, OHIO.

Zoning Permit
2634 Issued 4-3-74
H.E. man Christ

GAR. FLR. EL. 710.33

PROPOSED HOUSE
FLR. EL. 712.00

Changed 11-17-74

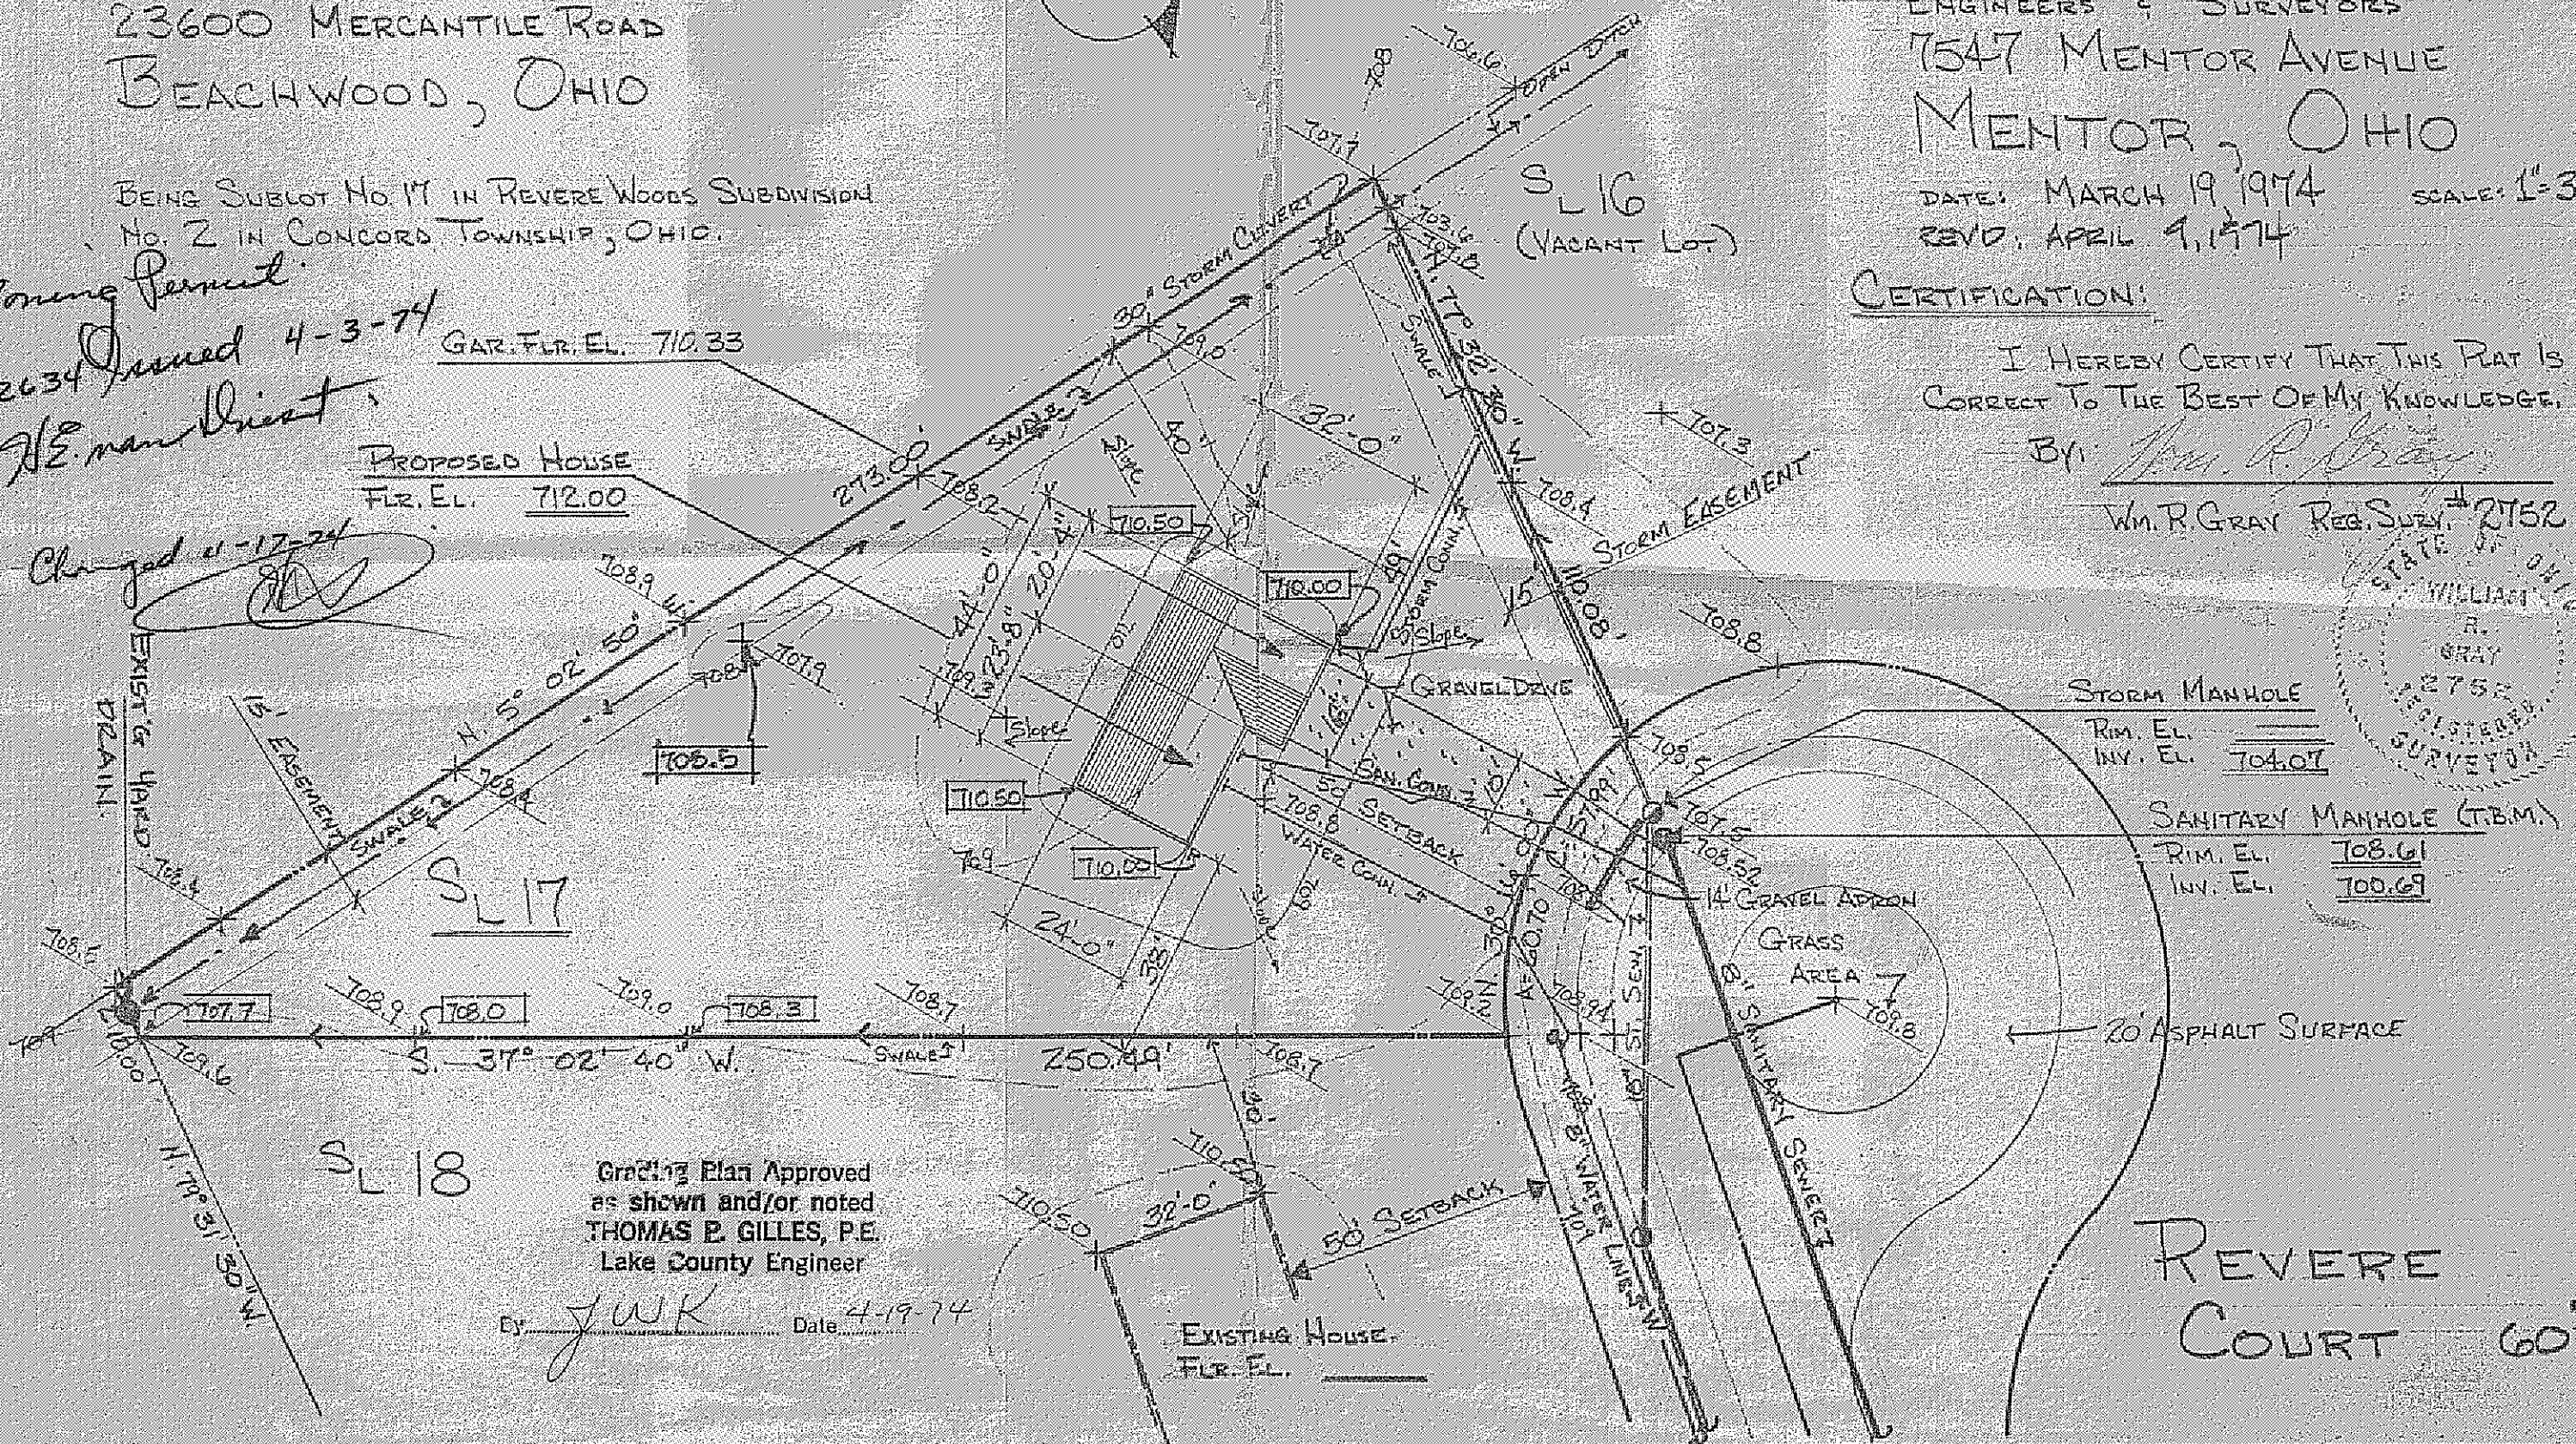

Grading Plan Approved
as shown and/or noted
THOMAS E. GILLES, P.E.
Lake County Engineer

By *JWK* Date 4-19-74

PREPARED BY:

WM. R. GRAY ASSOC., INC.
ENGINEERS & SURVEYORS
7547 MENTOR AVENUE
MENTOR, OHIO

DATE: MARCH 19, 1974
REV'D: APRIL 9, 1974

SCALE: 1"=30'

CERTIFICATION:

I HEREBY CERTIFY THAT THIS PLAN IS
CORRECT TO THE BEST OF MY KNOWLEDGE.

By *Wm. R. Gray*
WM. R. GRAY REG. SURV. # 2752



STORM MANHOLE
RIM. EL. 708.07
INV. EL. 706.07

SANITARY MANHOLE (T.B.M.)
RIM. EL. 708.61
INV. EL. 700.69

20' ASPHALT SURFACE

REVERE
COURT 60'