


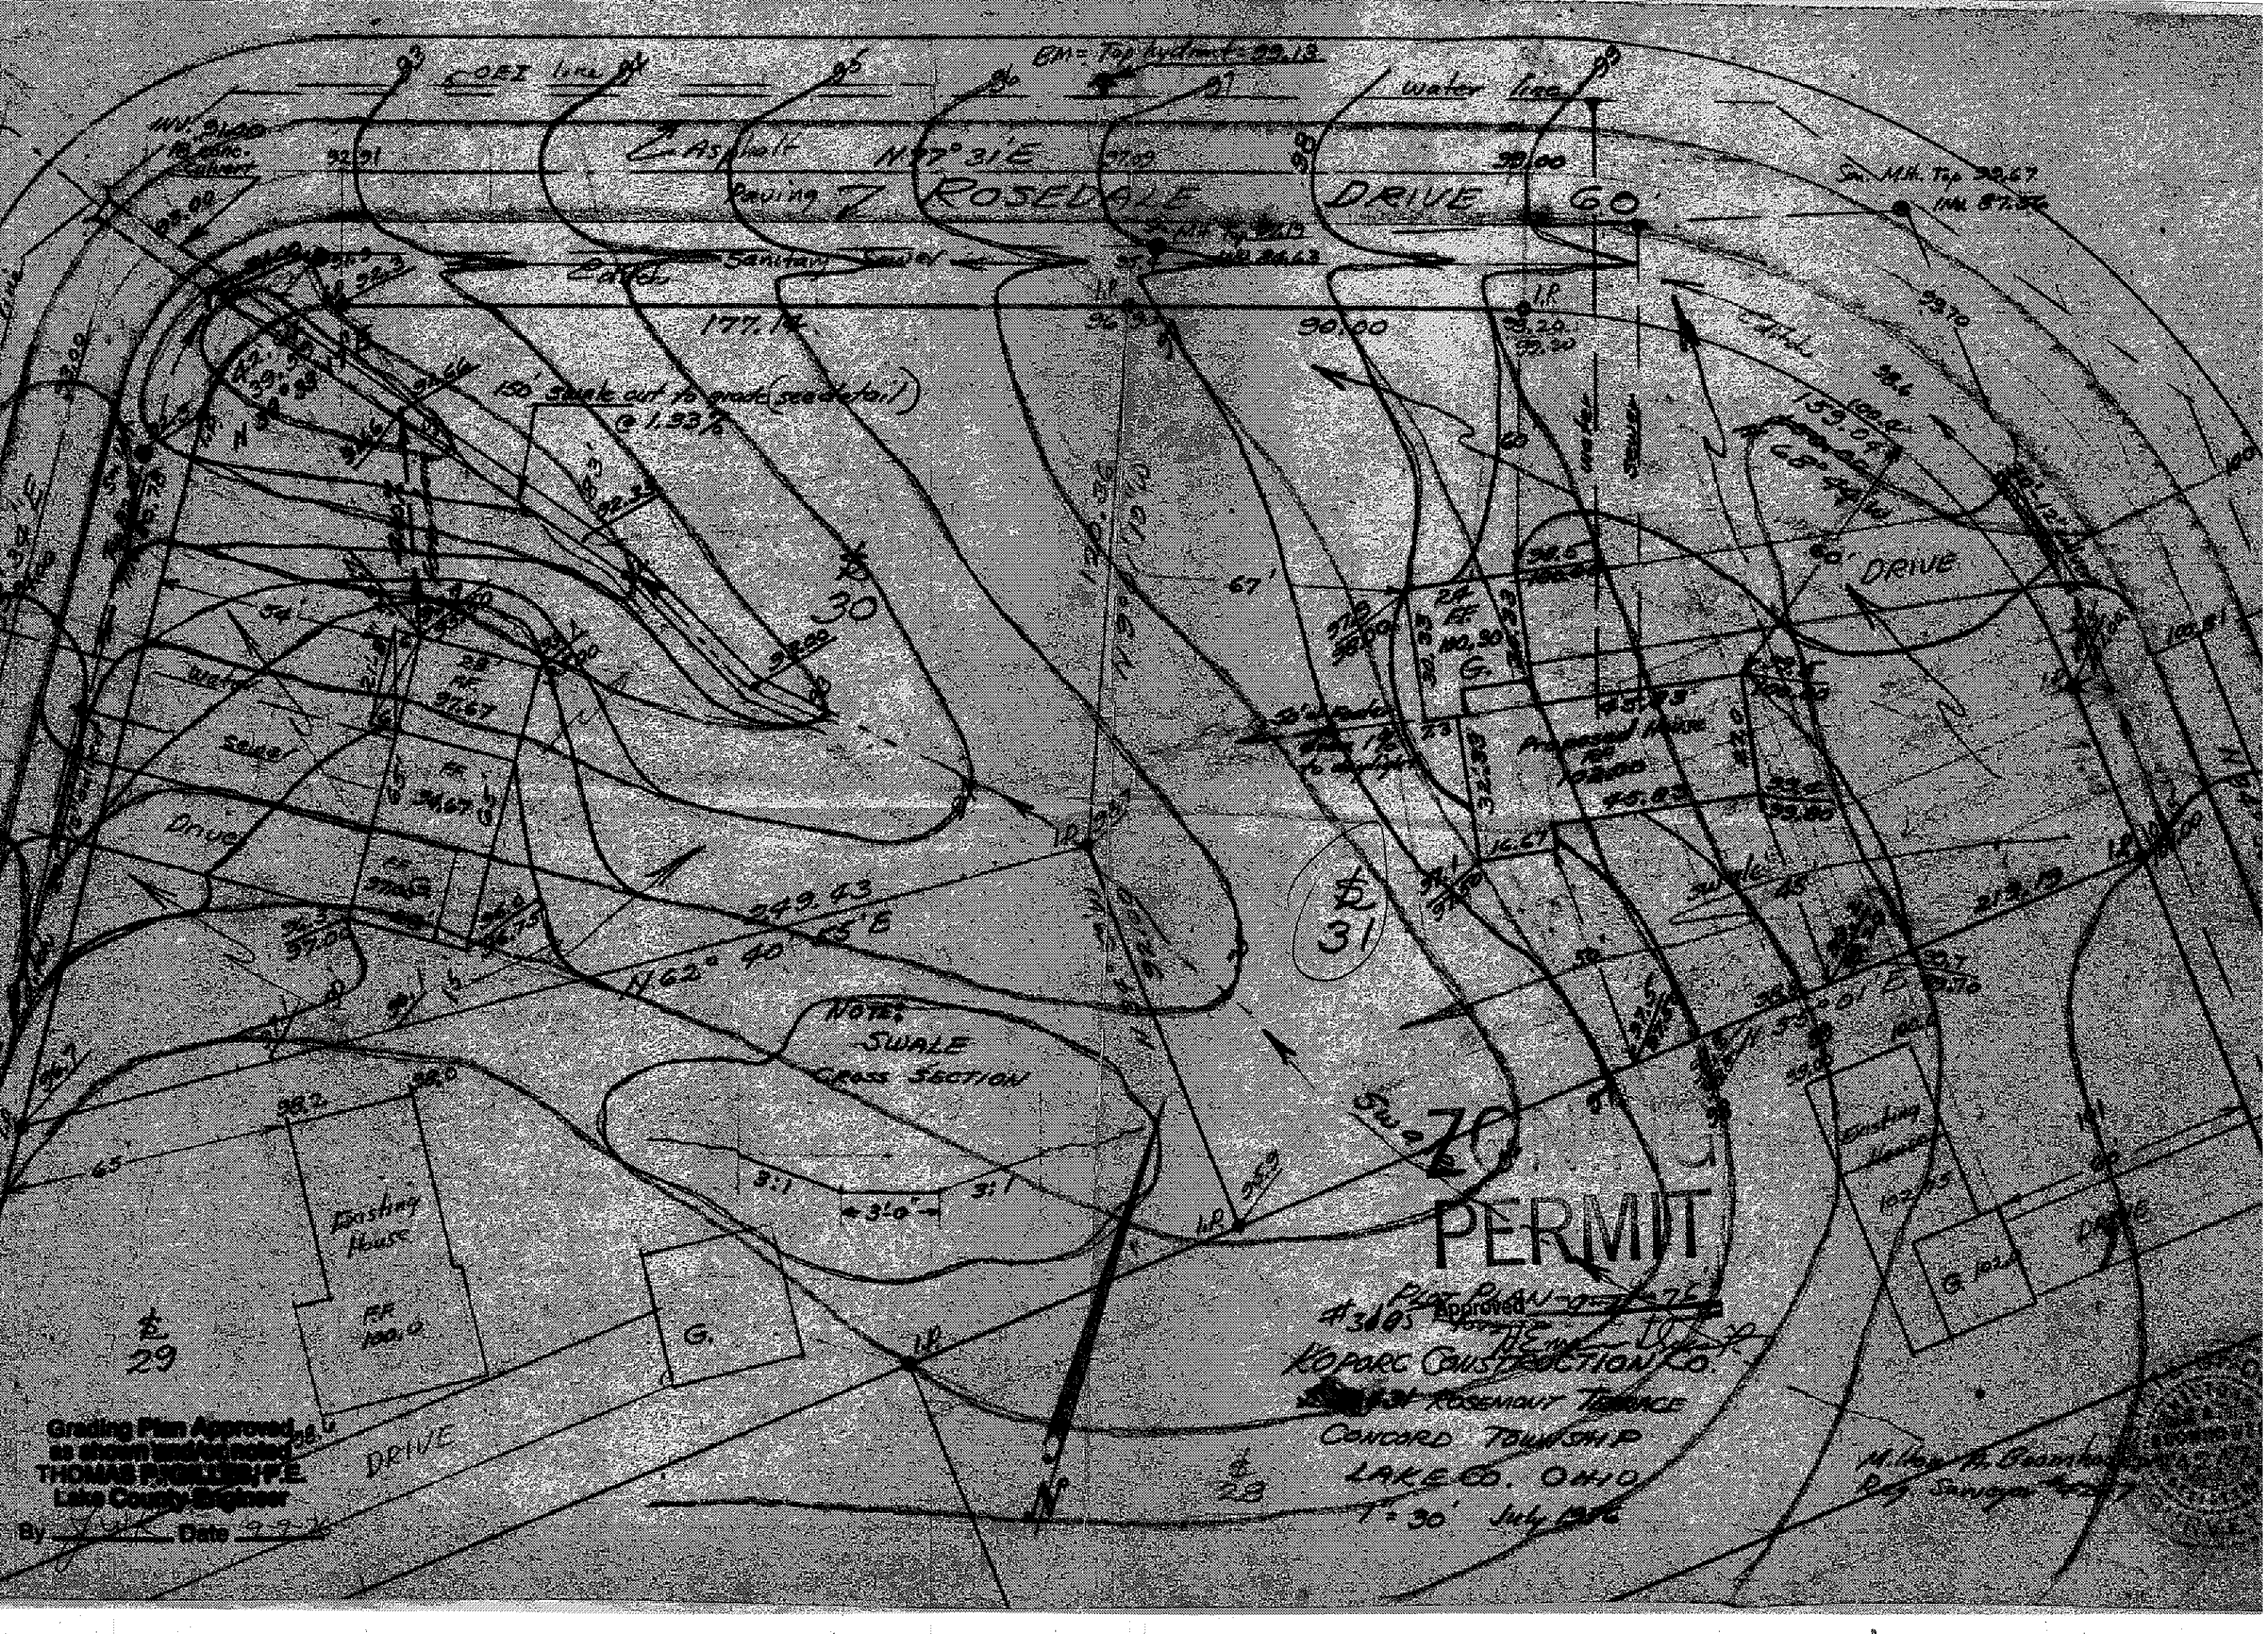

Grading Plan Approved  
as shown and noted  
THOMAS PROSSER, P.E.  
Lake County Engineer  
By \_\_\_\_\_ Date 7-7-76

**PERMIT**  
#3005  
KOPARC CONSTRUCTION CO.  
ROSEMOUNT TERRACE  
CONCORD TOWNSHIP  
LAKE CO. OHIO  
T-30 July 1976

NOTE:  
SWALE  
CROSS SECTION

3:1  
3:1  
3:1