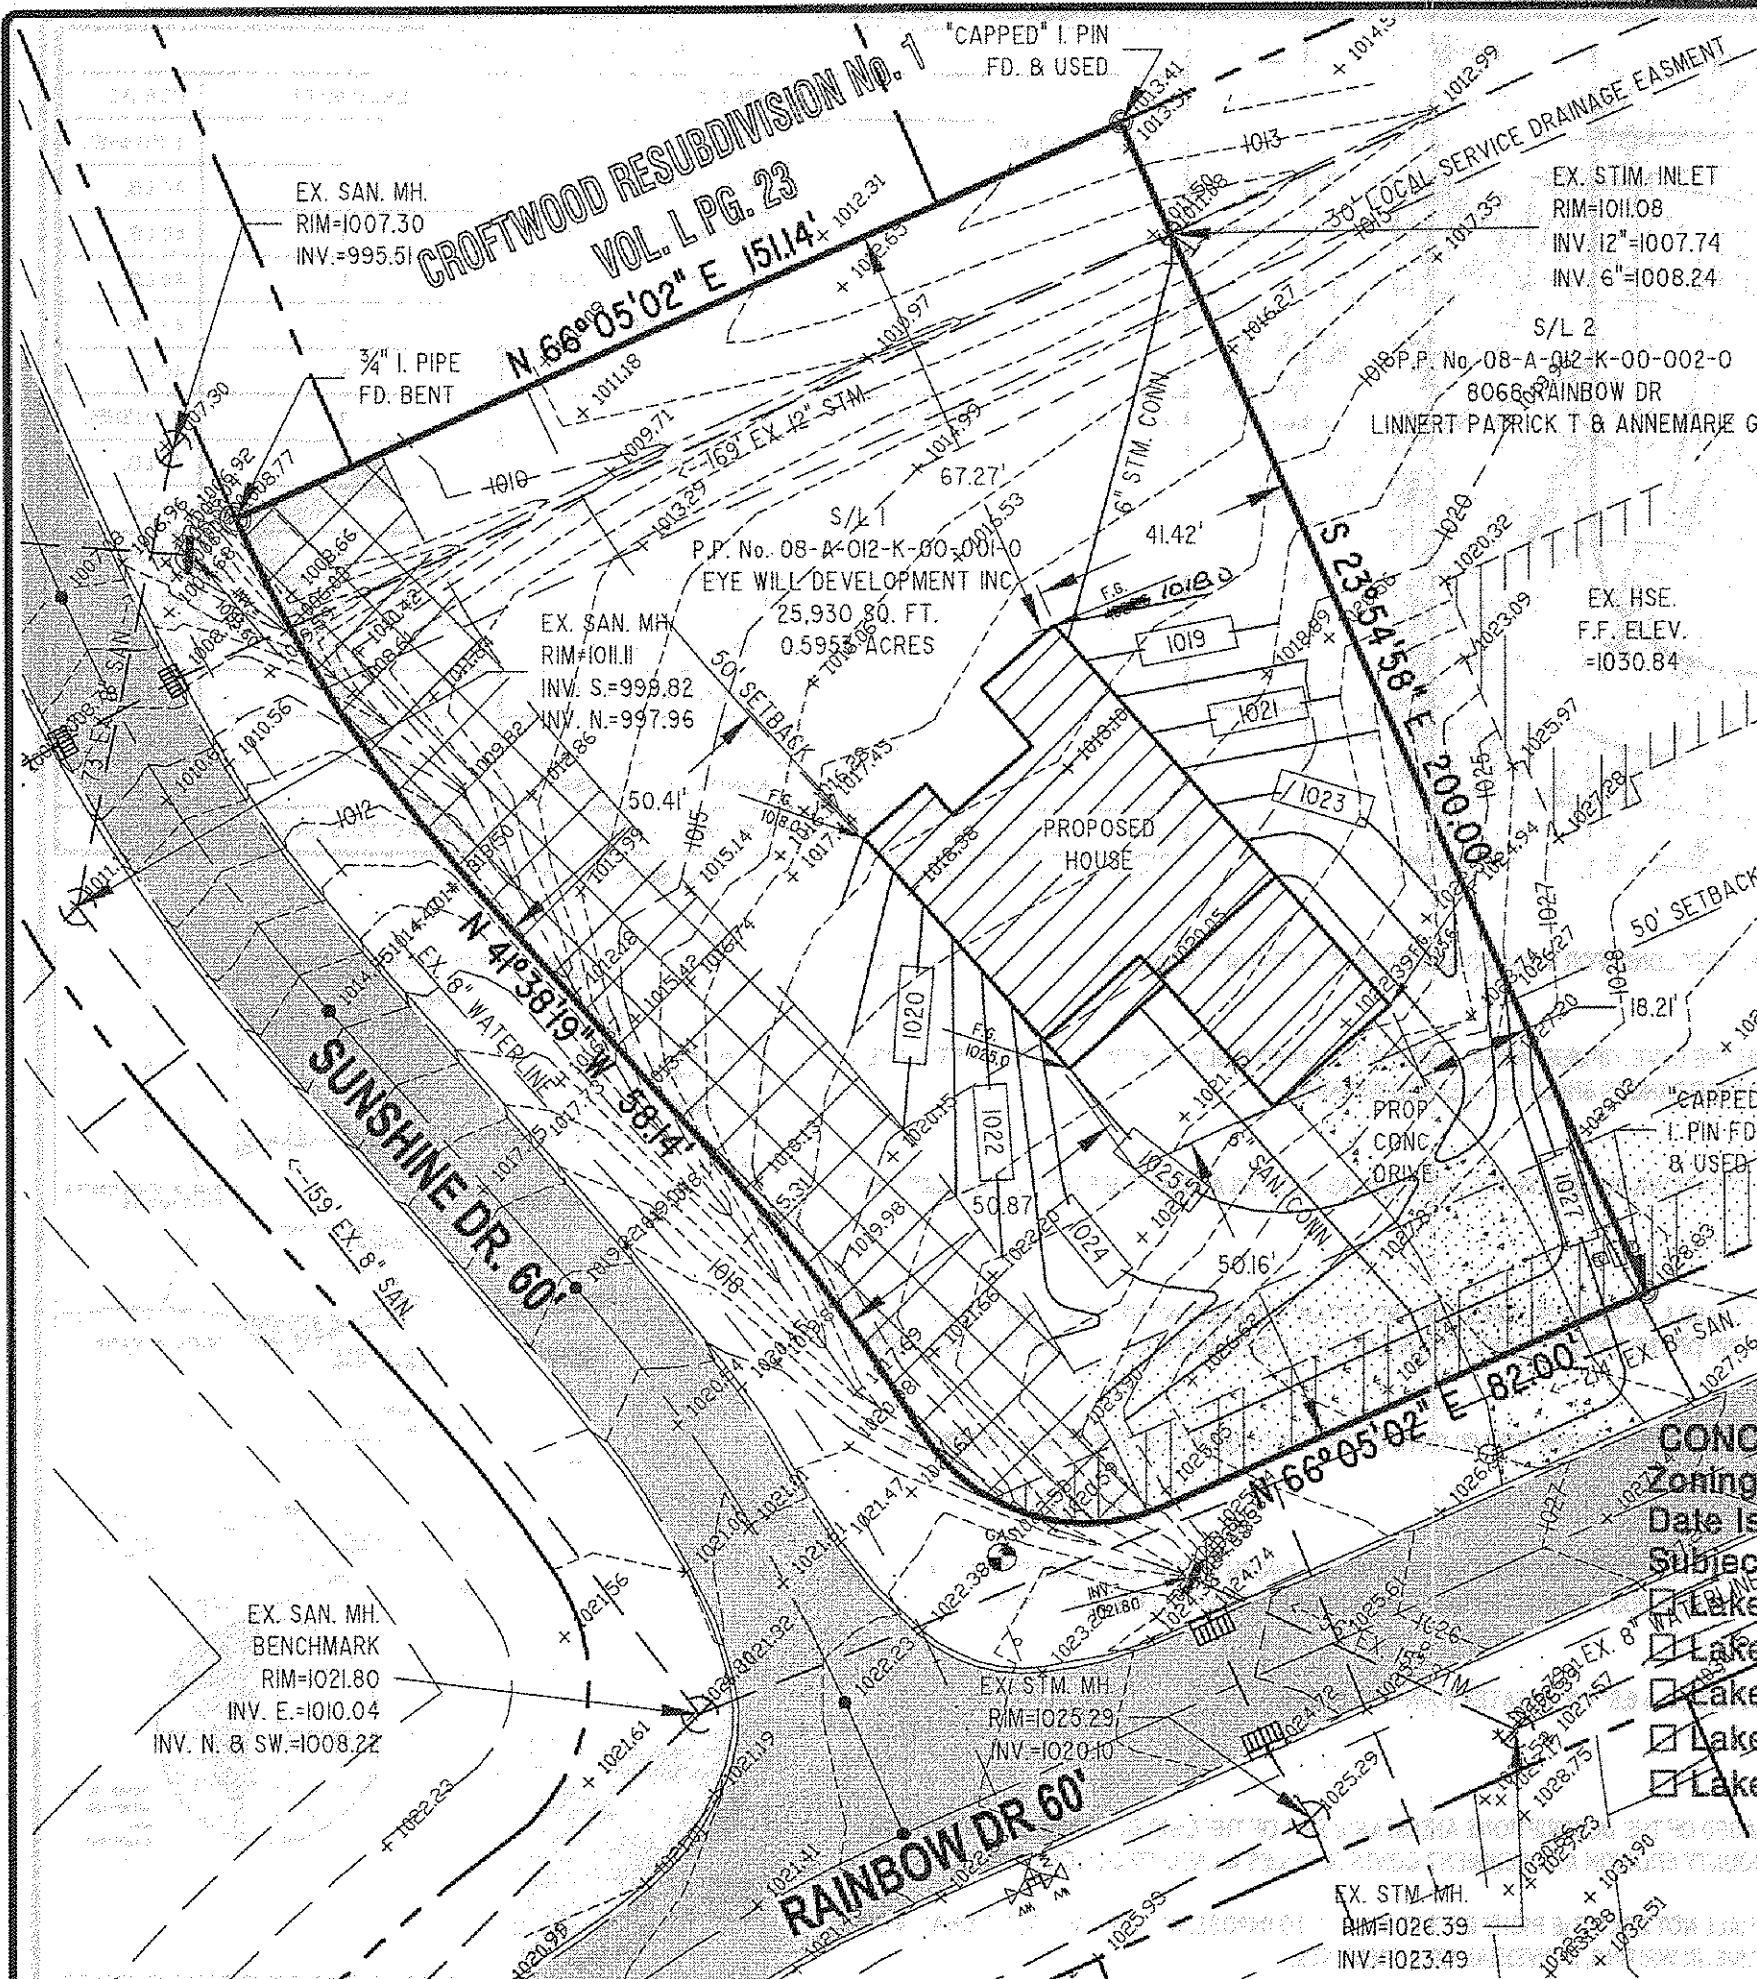


(A)
 L=43.48'
 R=30.00'
 Δ=83°02'08"
 C=39.77'
 N 72°23'54" W

(B)
 L=55.65'
 R=280.00'
 Δ=11°23'17"
 C=55.56'
 S 36°34'28" E

(C)
 L=68.05'
 R=220.00'
 Δ=17°43'21"
 C=67.78'
 N 32°46'38" W

GENERAL NOTES:

1. BENCHMARK - RIM OF EXISTING SANITARY MANHOLE LOCATED ON THE NORTHWEST CORNER OF SUNSHINE DR. & RAINBOW DR., ELEVATION = 1021.80.
2. DRIVEWAY APRON TO BE 6" THICK CONCRETE.
3. ALL DOWNSPOUTS TO BE OUTLETED TO SPLASH BLOCKS.
4. CONTRACTOR RESPONSIBLE FOR CONTACTING THE OHIO UTILITY PROTECTION SERVICE (1.800.362.2764) AND ALL UTILITY COMPANIES A MINIMUM OF 48 HOURS PRIOR TO CONSTRUCTION.
5. THE LOCATION BOTH HORIZONTAL AND VERTICAL OF EXISTING UNDERGROUND UTILITIES SHOWN HEREON, HAVE BEEN OBTAINED BY A DILIGENT AND COMPREHENSIVE SEARCH OF AVAILABLE RECORDS. VERIFICATION BY FIELD OBSERVATION HAS BEEN CONDUCTED WHERE PRACTICAL, HOWEVER, BARRINGTON CONSULTING GROUP, INC. DOES NOT GUARANTEE THE COMPLETENESS, NOR ACCURACY THEREOF.
6. CONTRACTOR SHALL VERIFY ELEVATIONS OF LATERAL INVERTS IN THE FIELD PRIOR TO FOUNDATION EXCAVATION.
7. SEE SHEET 2 FOR EROSION AND SEDIMENT-CONTROL PLAN
8. SEE SHEET 2 FOR SEEDING INFORMATION

CERTIFICATION :

"I THE UNDERSIGNED HEREBY CERTIFIES THAT THIS TOPOGRAPHY INDICATED BY 1 FOOT CONTOURS AND ELEVATION SHOWN HEREON REPRESENTS AN ACTUAL SURVEY MADE BY ME ON THE 5th DAY OF JANUARY, 2011 AND THE ELEVATIONS WERE TAKEN AT AN APPROPRIATE INTERVAL AND AS OF THAT DAY THEY EXISTED AS INDICATED HEREON.


"I HEREBY CERTIFY THAT THIS PLAN WAS PREPARED BY ME AND IS CORRECT TO THE BEST OF MY KNOWLEDGE AND BELIEF"

DWN 01/10/2011
 DAVID W. NOVAK, P.S. No. 7507
 CERT. L.DWG

CONCORD TOWNSHIP ZONING OFFICE


Zoning Permit # 011-14348
 Date Issued 1/20/11
 Subject to Approval By:
☒ Lake Co. Engineer/Storm Water Mgmt.
☒ Lake Co. Utilities Dept.
☒ Lake Co. Soil + Water District
☒ Lake Co. Health District
☒ Lake Co. Building Dept.

Stormwater Management Plan
 Approved as shown and/or noted
 JAMES R. GILLS, P.E.
 County Drainage Engineer
 By L.S. Date 1-25-11

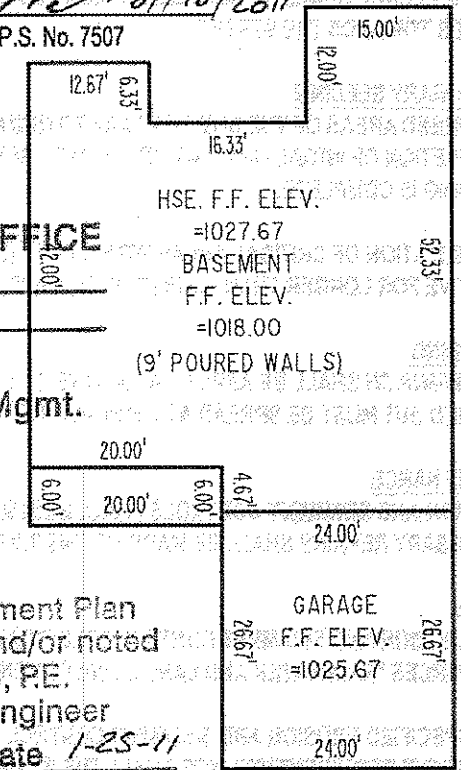

REVISIONS	BY

Barrington
 CONSULTING GROUP, INC.
 9114 TYLER BLVD., MENTOR, OHIO 44060
 PHONE 440.205.1260 FAX 440.205.1262
 www.BarringtonCGI.com

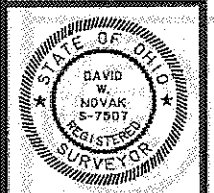

SITE PLAN
 S/L 1 RAINBOW DR., CONCORD TWP., OHIO 44077
 NATURE PRESERVE SOUTH VOL. 49 PG. 24
 W.R. DAWSON CONSTRUCTION

W.D.W.	W.S.O.
CHECKED	DWN
DATE	JAN. 6, 2011
SCALE	1" = 30'
JOB NO.	10106-001
SHEET	1/2
OF	SHEETS