



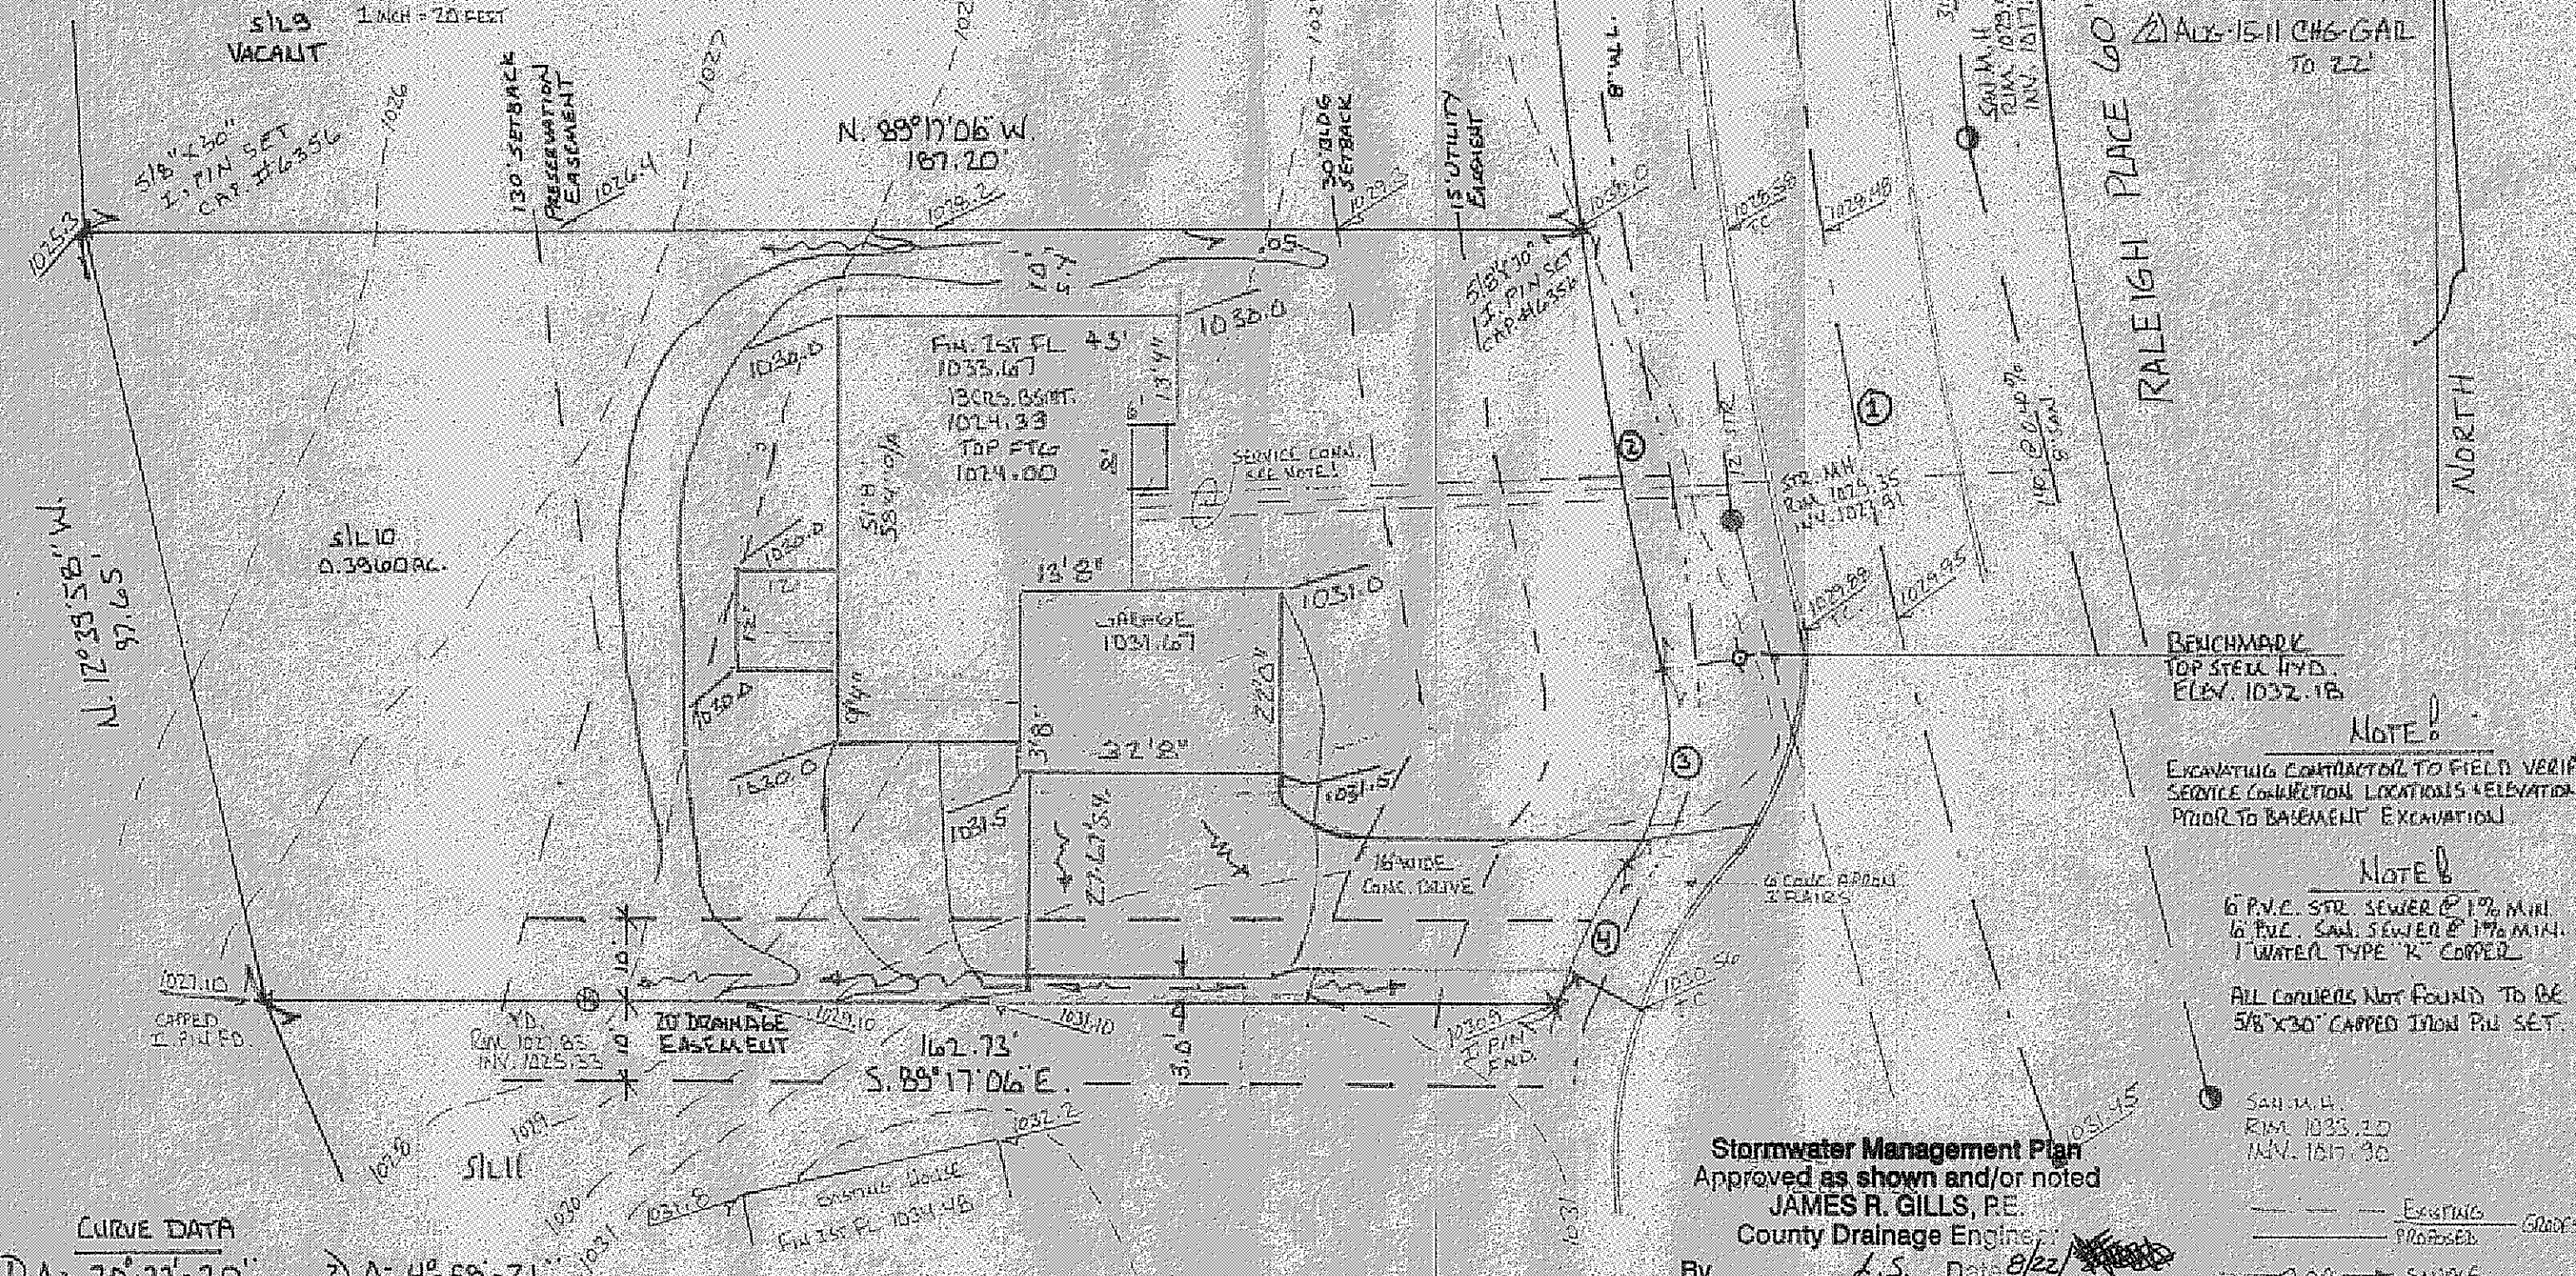

CURVE DATA

1) Δ: 20°-21'-20"	2) Δ: 4°-59'-21"
L: 213.34'	L: 54.86'
R: 600.00'	R: 630.00'
CH: 212.22'	CH: 54.84'
CB: N09°28'16" W.	CB: N10°27'09" W.
3) Δ: 47°-33'-30"	4) Δ: 17°-01'-09"
L: 24.90'	L: 19.31'
R: 30.00'	R: 65.00'
CH: 24.19'	CH: 19.24'
CB: N10°49'55" E.	CB: N26°06'06" E.

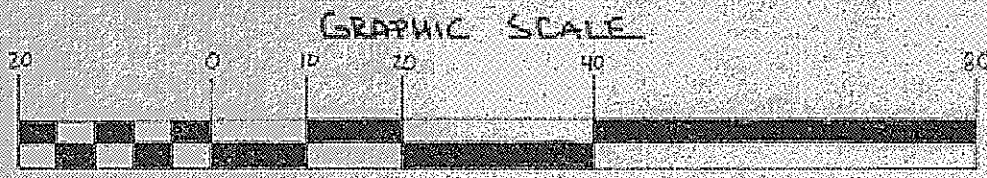

JOHN C. SYDOWIEZNY
7739 VIEWMOUNT DRIVE
PAINEVILLE OHIO 44077
440-352-7742
440-537-4111

NOTE!
CALL 2 DAYS BEFORE YOU DIG
1-800-362-2764
O.U.P.S.

Stormwater Management Plan
Approved as shown and/or noted
JAMES R. GILLS, PE.
County Drainage Engineer
By L.S. Date 8/22/2011

SITE PLAN FOR: JEFFREY MALIBIRAN	
SCALE: 1" = 20'	APPROVED BY:
DATE: JUNE 2011	DRAWN BY: FJH
BEING SUBLOT 10 IN THE 18TH CENTURY VILLAGE SUBDIVISION RECORDED IN PLAT VOL. 50 PG. 22 L.C.R.P.	
TOWNSHIP OF CONCORD - COUNTY OF LANE - STATE OF OHIO	
JOB # 11-4086	DRAWING NUMBER: 11-3031

REVISIONS
1) JUL-27-11 MADE HSE 3' SOUTH
2) AUG-15-11 CHG GALL TO 22'

NOTE!
EXCAVATING CONTRACTOR TO FIELD VERIFY SERVICE CONNECTION LOCATIONS & ELEVATIONS PRIOR TO BASEMENT EXCAVATION

NOTE!
6" P.V.C. STR. SEWER @ 1% MIN.
6" P.V.C. SANI. SEWER @ 1% MIN.
1" WATER TYPE "R" COPPER
ALL CORNERS NOT FOUND TO BE 5/8" X 30" CAPPED IRON PIN SET.

SAN. MAN. RIM 1033.20 INV. 1017.90
6" P.V.C. APPROX. 2 FEET
BENCHMARK TOP STEEL HYD. ELEV. 1032.18