


2P #3126

Grading Plan Approved
as shown and/or noted
THOMAS P. GILLES, P.E.
Lake County Engineer

By JWK 10-18-76

R & O RAILROAD CO.

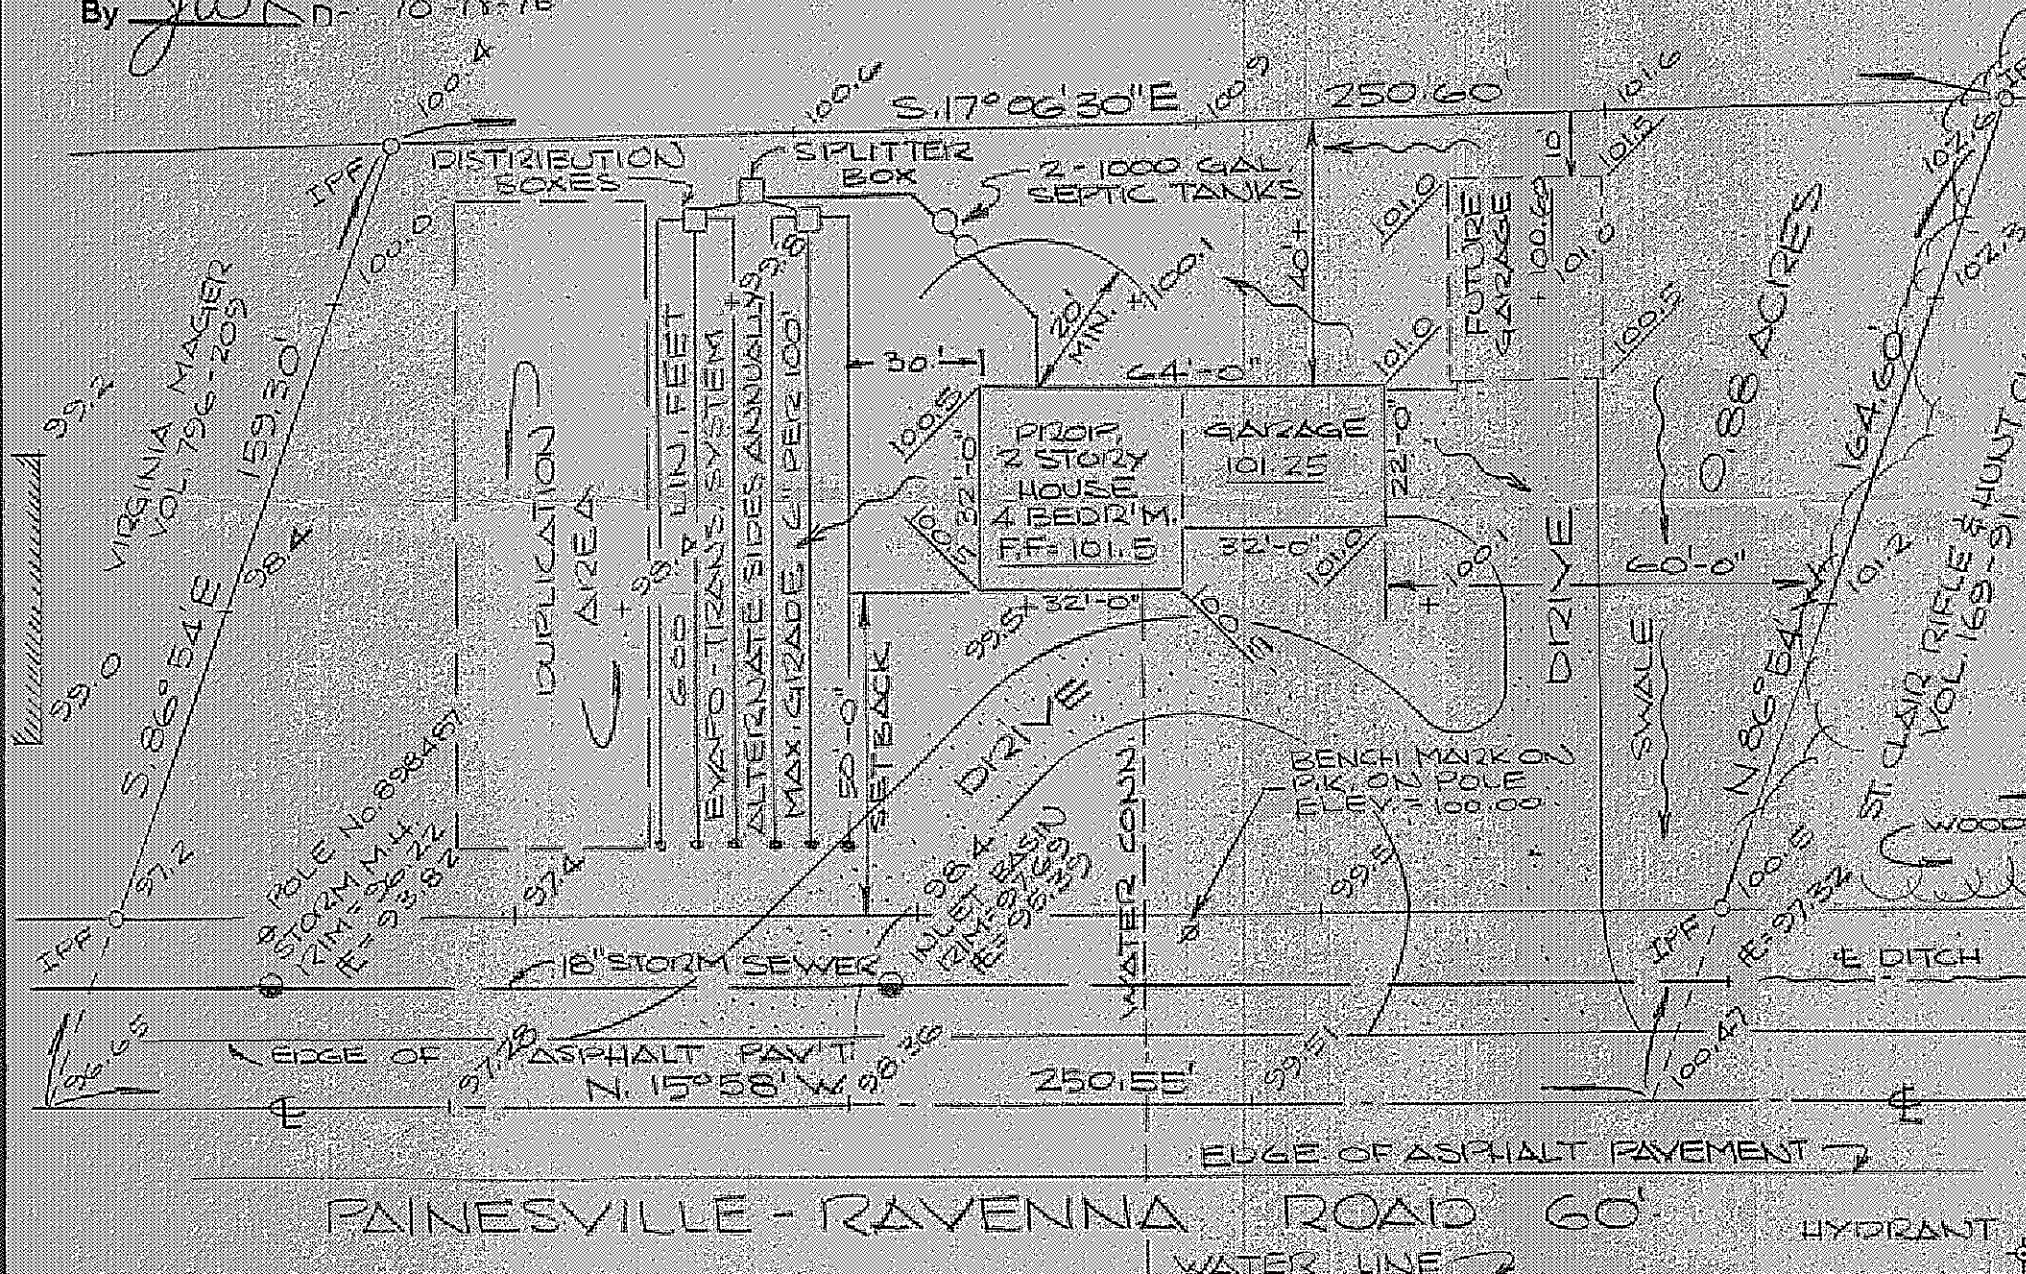

SITE PLAN

CONCORD TOWNSHIP LAKE COUNTY, OHIO

FOR ROBERT BOOTH, JR.
CLIENT OWNER
P.O. BOX 148 PAINESVILLE, OHIO 44077
ADDRESS STREET CITY ZIP

SUBDIVISION	NAME	LOT	TRACT
		269	61
SUB LOT NO.	STREET	VOLUME	PAGE
		8-15C-19-20	RAVENNA RD
		PERM PARCEL	STREET

LEGEND

SANITARY MANHOLE	WATER VALVE (GAS)
STORM MANHOLE	WATER METER (GAS)
INLET OR CATCH BASIN	AS BUILT ELEVATION
HYDRANT	INDICATES DIRECTION OF SURFACE DRAINAGE
EXISTING CONTOURS	
PROPOSED CONTOURS	
EXIST. ELEV.	PROPELEV.

DESIGN CERTIFICATION

THIS PLAT WAS PREPARED BY ME, AND IS CORRECT TO THE BEST OF MY KNOWLEDGE AND BELIEF

Elmer J. Hester
REGISTERED SURVEYOR NO. 4785

"AS BUILT" CERTIFICATION

I HEREBY CERTIFY THAT THE CIRCLED GRADES ARE EXISTING FINISH GRADES CHECKED IN FIELD ON _____, 19____, AND THAT SURVEY IS CORRECT TO THE BEST OF MY KNOWLEDGE AND BELIEF.

REGISTERED SURVEYOR NO.

PLAN PREPARED

COLPETZER - WOODS CONSULTANTS INC.
CONSULTING ENGINEERS & SURVEYORS
180 S. STATE STREET
PAINESVILLE, OHIO 44077
TEL: 357-7569

REVISIONS			DRAWN BY	SCALE	DRAWING NUMBER
NO	DATE	BY			
1	10-13-76	T.H.	CHK'D	DATE 10-8-76	76-236
2			CREW CHIEF	APPD	

6501 RAVENNA Rd.