

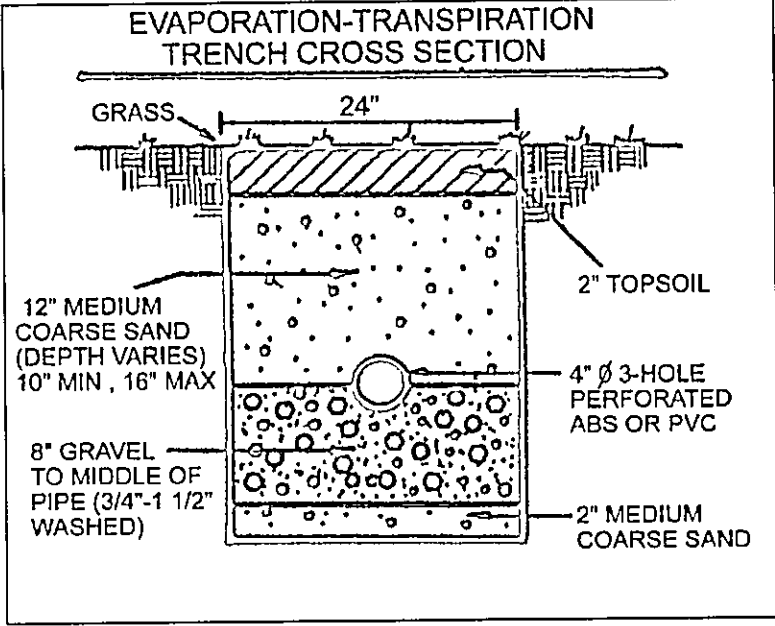


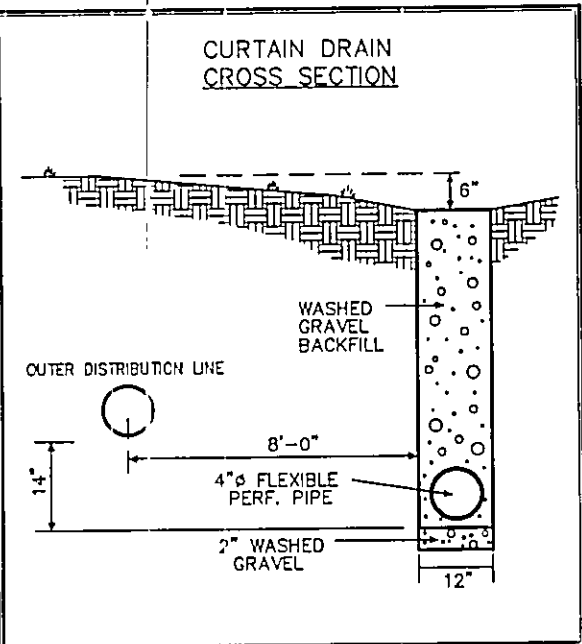

28.00'	44.00'	30.00'	24.00'	24.00'
	1ST FF-		GAR FF-	
	BSMT FF-		UNEX	
	2 BDRM			
	UNEX			
	44.00'	30.00'		

SCALE 1"=20'

RAVENNA ROAD - 60'

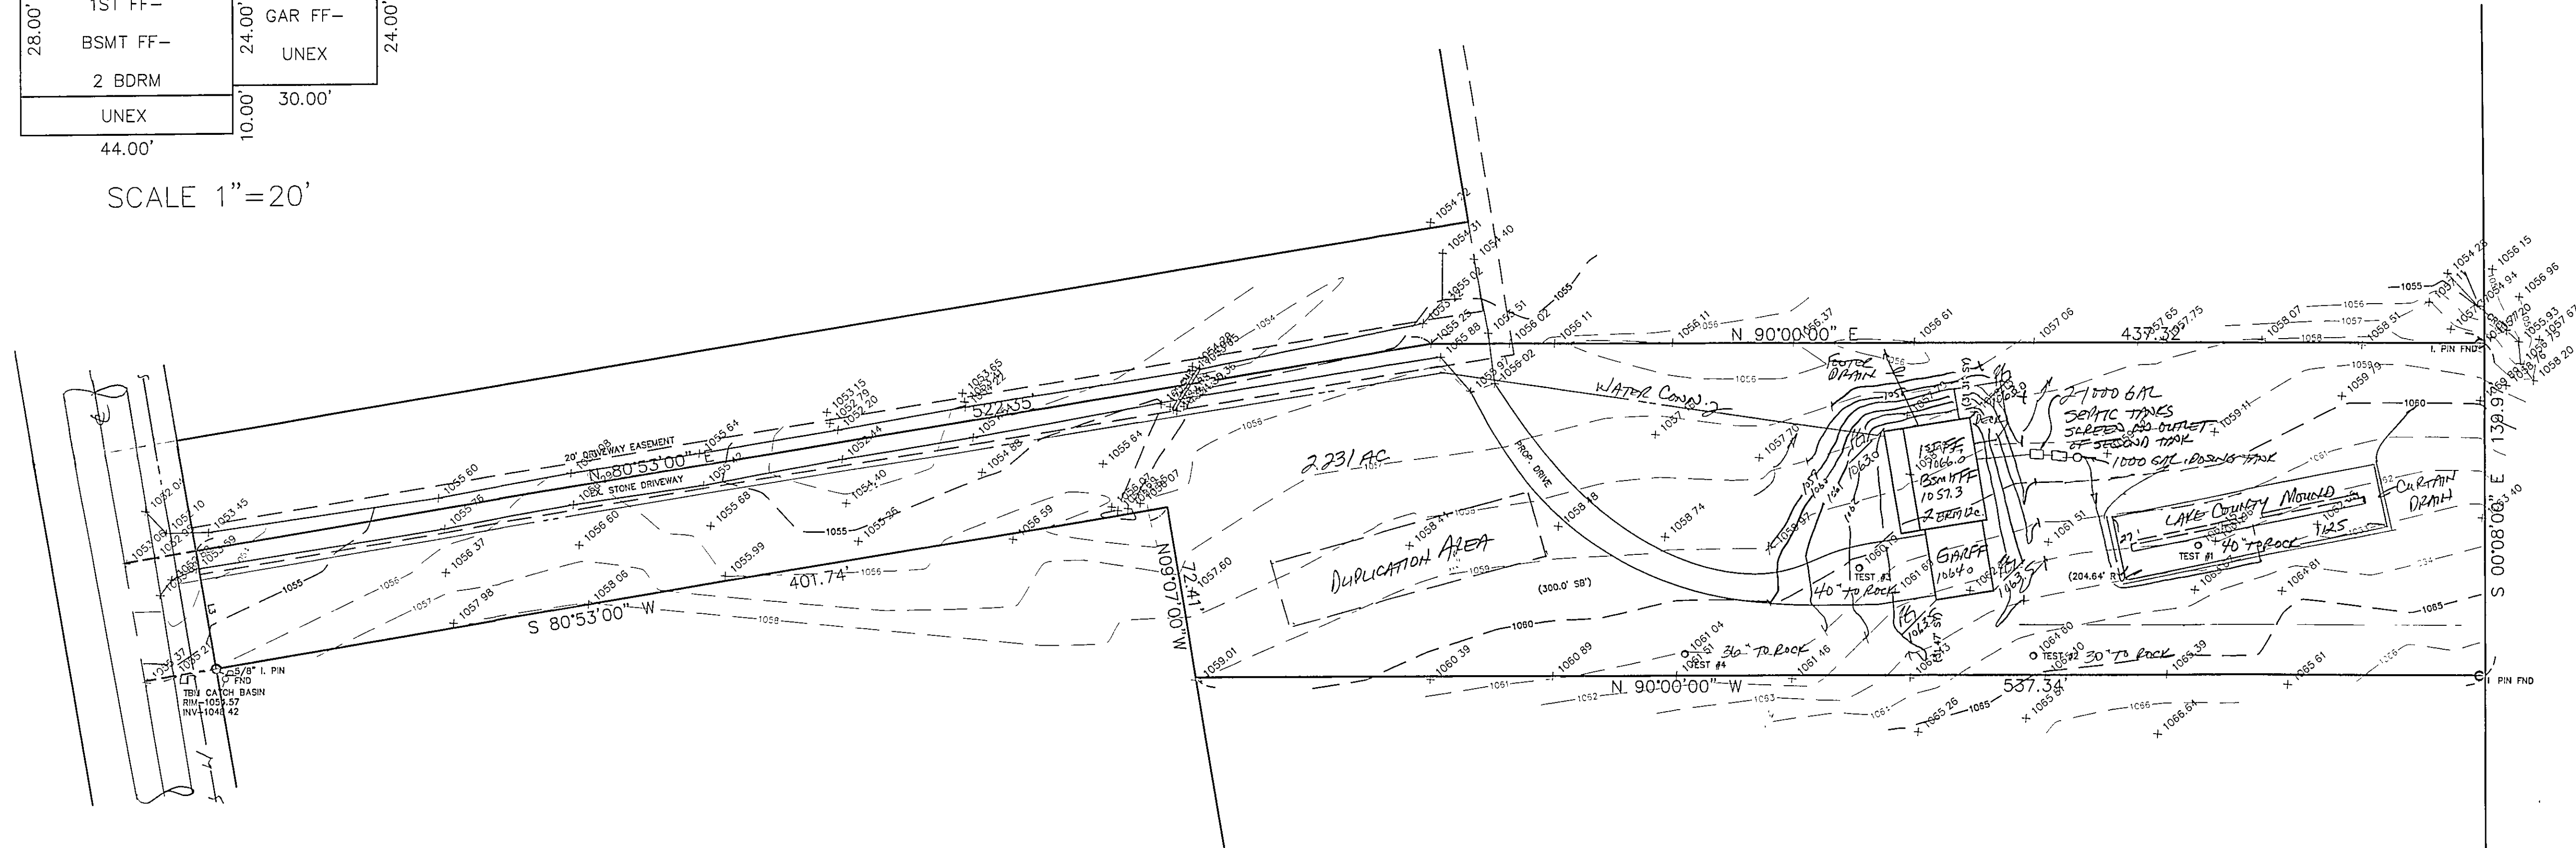

This project is exempt from ESC Plan Review Date 7-2-2003 Lake SWCD


"I, the undersigned hereby certify that this topography indicated by 6", 1" or 2" contours, and elevations shown hereon represent an actual field survey made by me on the 14th day of JUNE, 2003 and that the elevations were taken at appropriate intervals and that as of that date they existed as indicated hereon."

Name: [Signature] Reg. No. 6243

BM CATCH BASIN ELEV=1054.57

LLR = 2.7

EXISTING UTILITIES NOTE: THE SIZE AND LOCATION, BOTH HORIZONTAL AND VERTICAL, OF THE UNDERGROUND UTILITIES SHOWN HEREON, HAVE BEEN OBTAINED BY A SEARCH OF AVAILABLE RECORDS. VERIFICATION BY FIELD OBSERVATION HAS BEEN CONDUCTED WHERE PRACTICAL, HOWEVER, BABCOCK, JONES AND ASSOCIATES, INC. DOES NOT GUARANTEE THE COMPLETENESS NOR ACCURACY THEREOF.

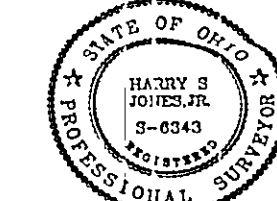

REV NO.	DESCRIPTION	DATE	BY	CHK'D

Grading Plan Approved as shown and/or noted JAMES R. GILLS, P.E. Lake County Engineer

By: [Signature] Date: 7/3/03





Discharge Footer Drain to defined drainage channel

BABCOCK, JONES AND ASSOCIATES, INC
CIVIL ENGINEERS - SURVEYORS - LAND PLANNERS
PAINESVILLE OHIO 44077

DATE	6/19/03
DESIGN BY	HJ
DRAWN BY	NS
APPROVED BY	HJ

SITE PLAN FOR CEDARCRAFT LOG HOMES
CONVOCED TOWNSHIP LAKE COUNTY STATE OF OHIO

SCALE	1"=40'
JOB NO	03-147
SHEET	1
OF	2

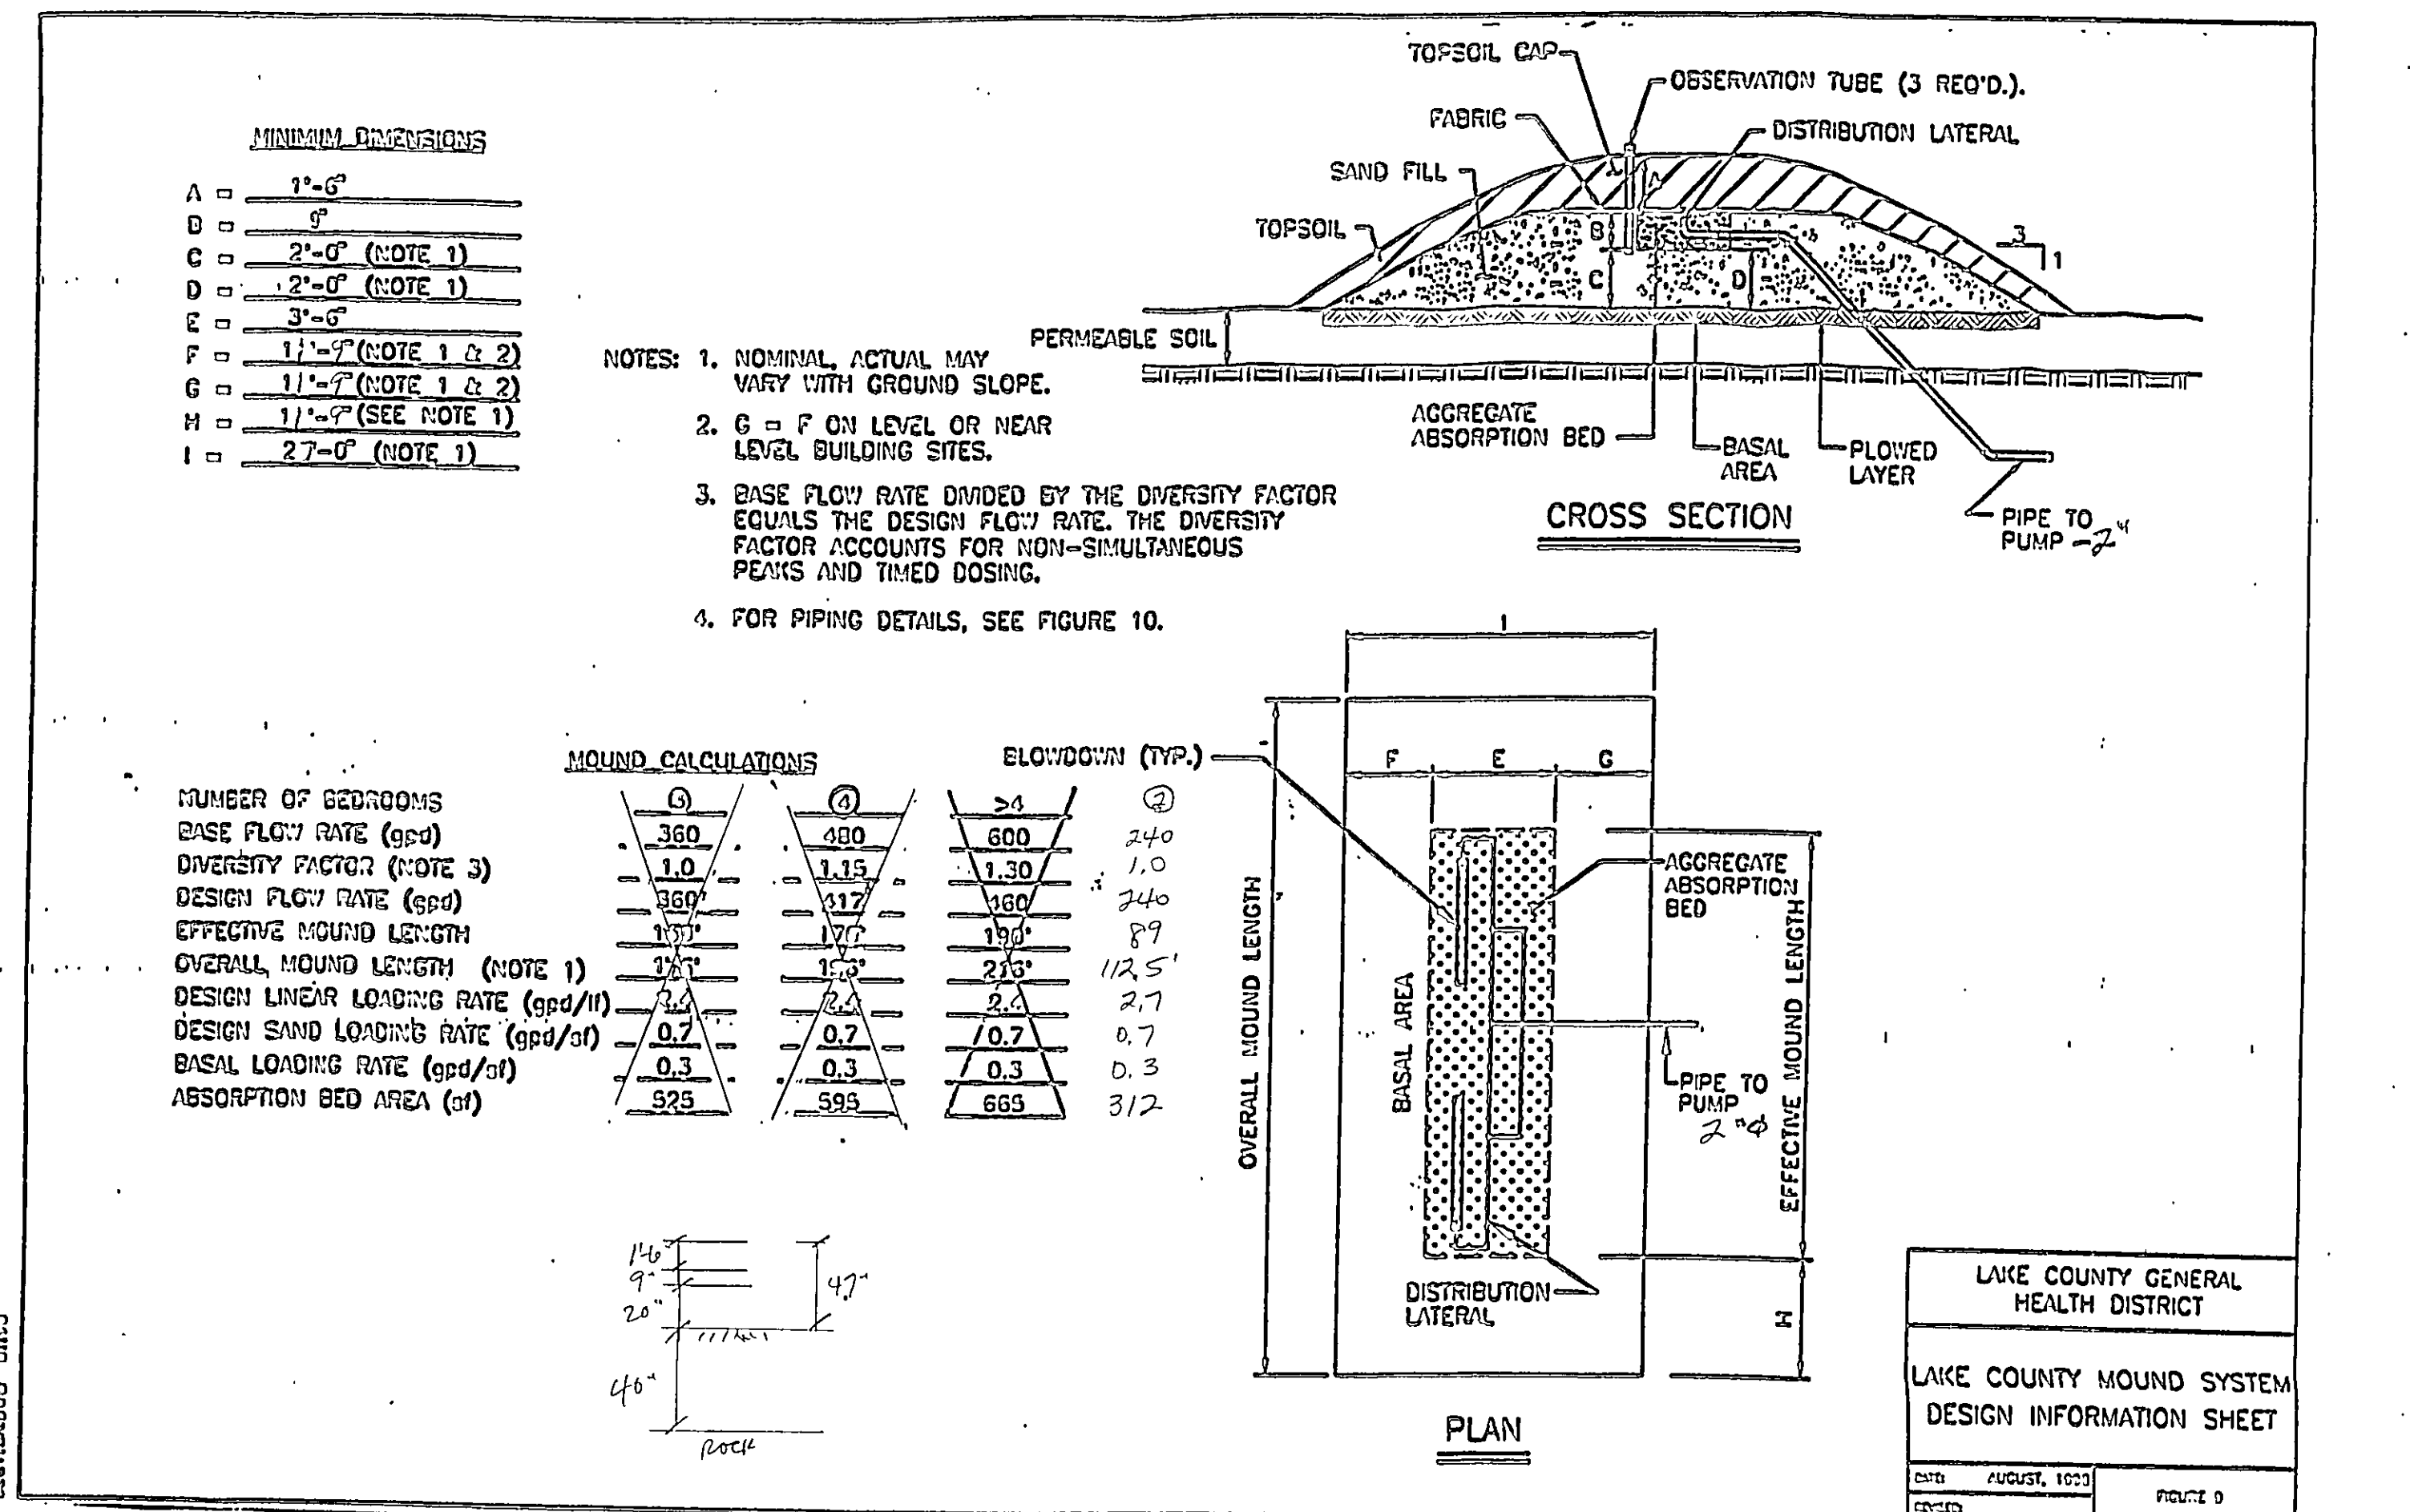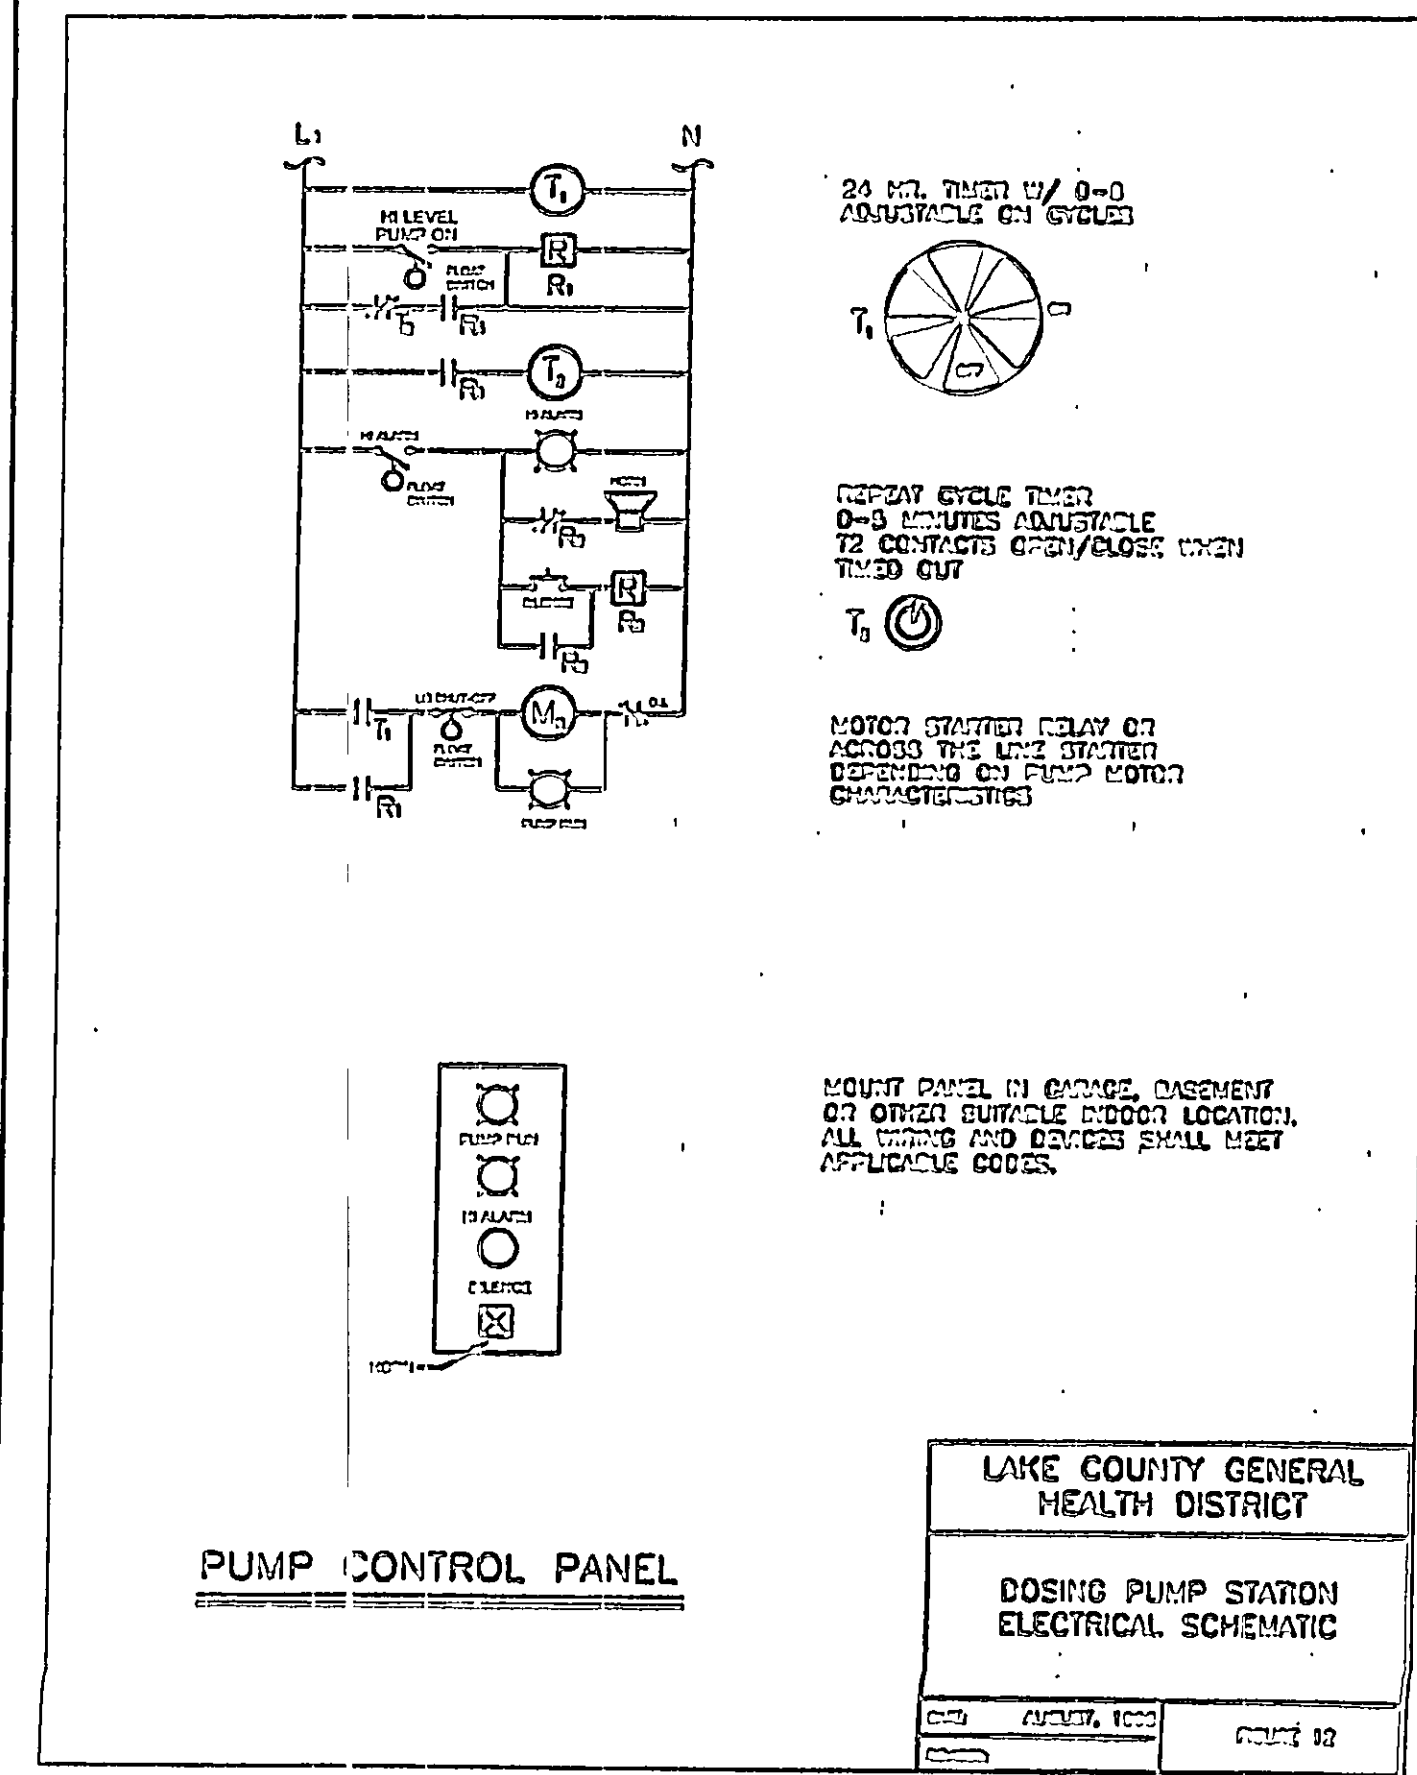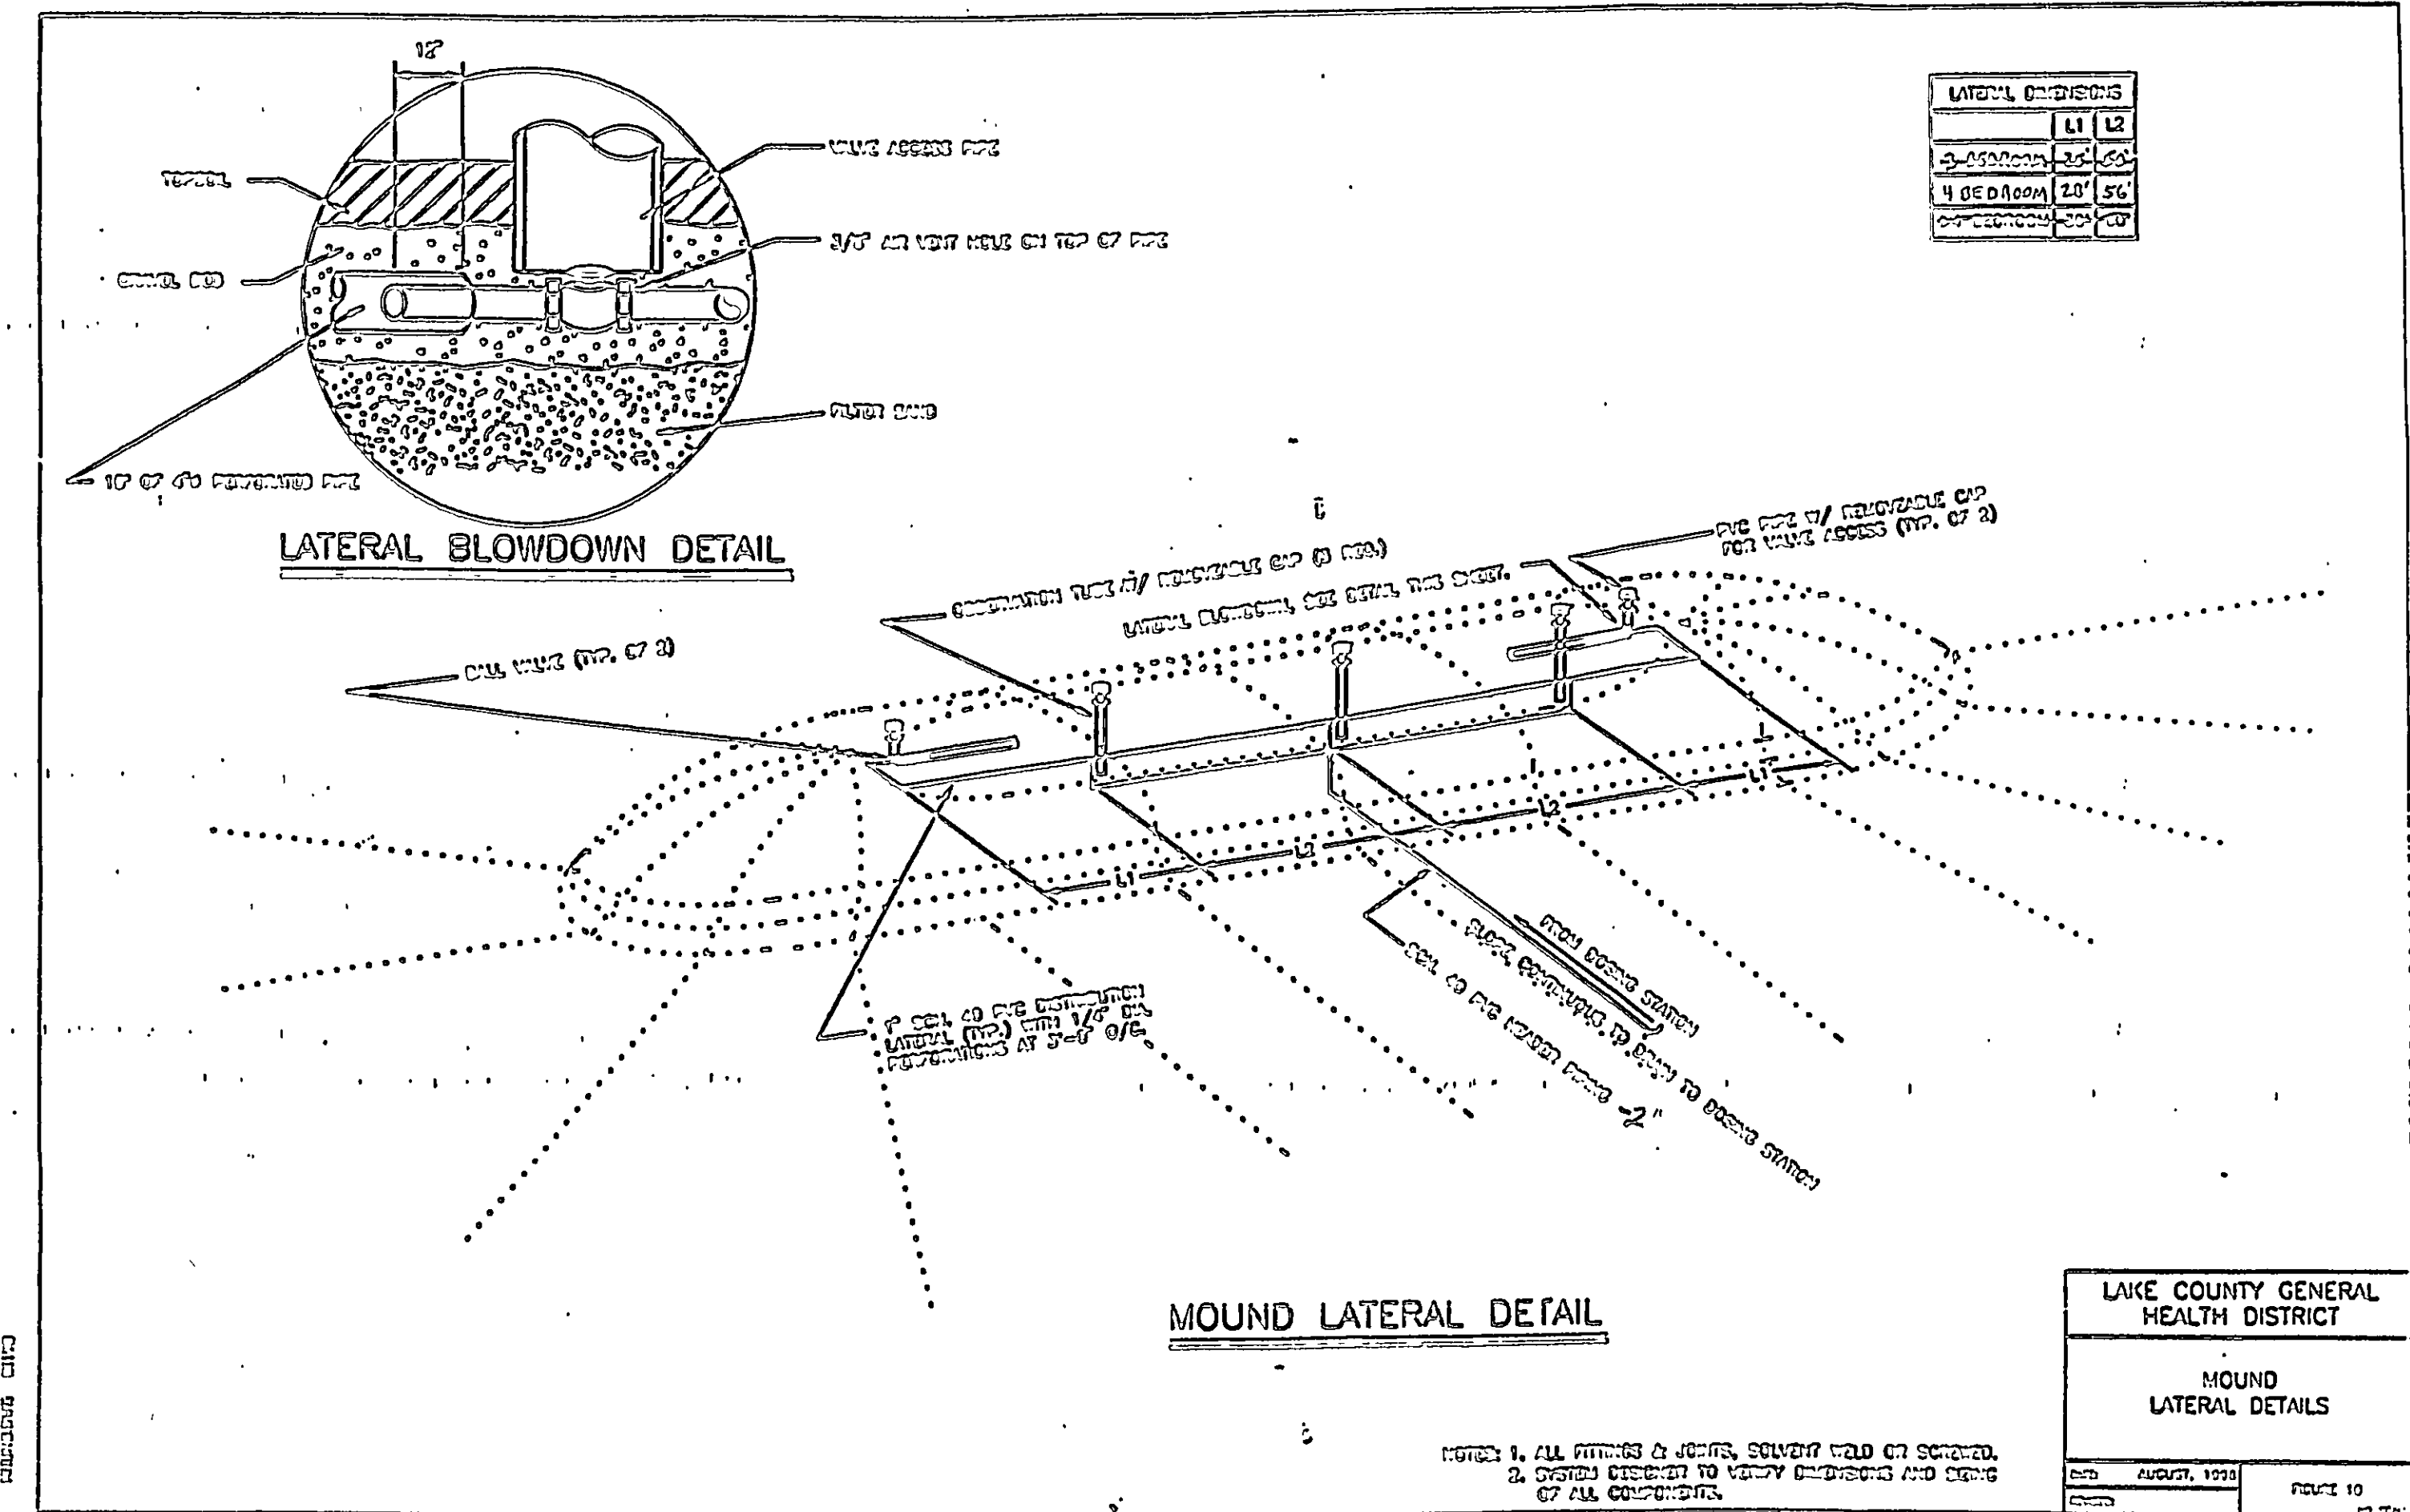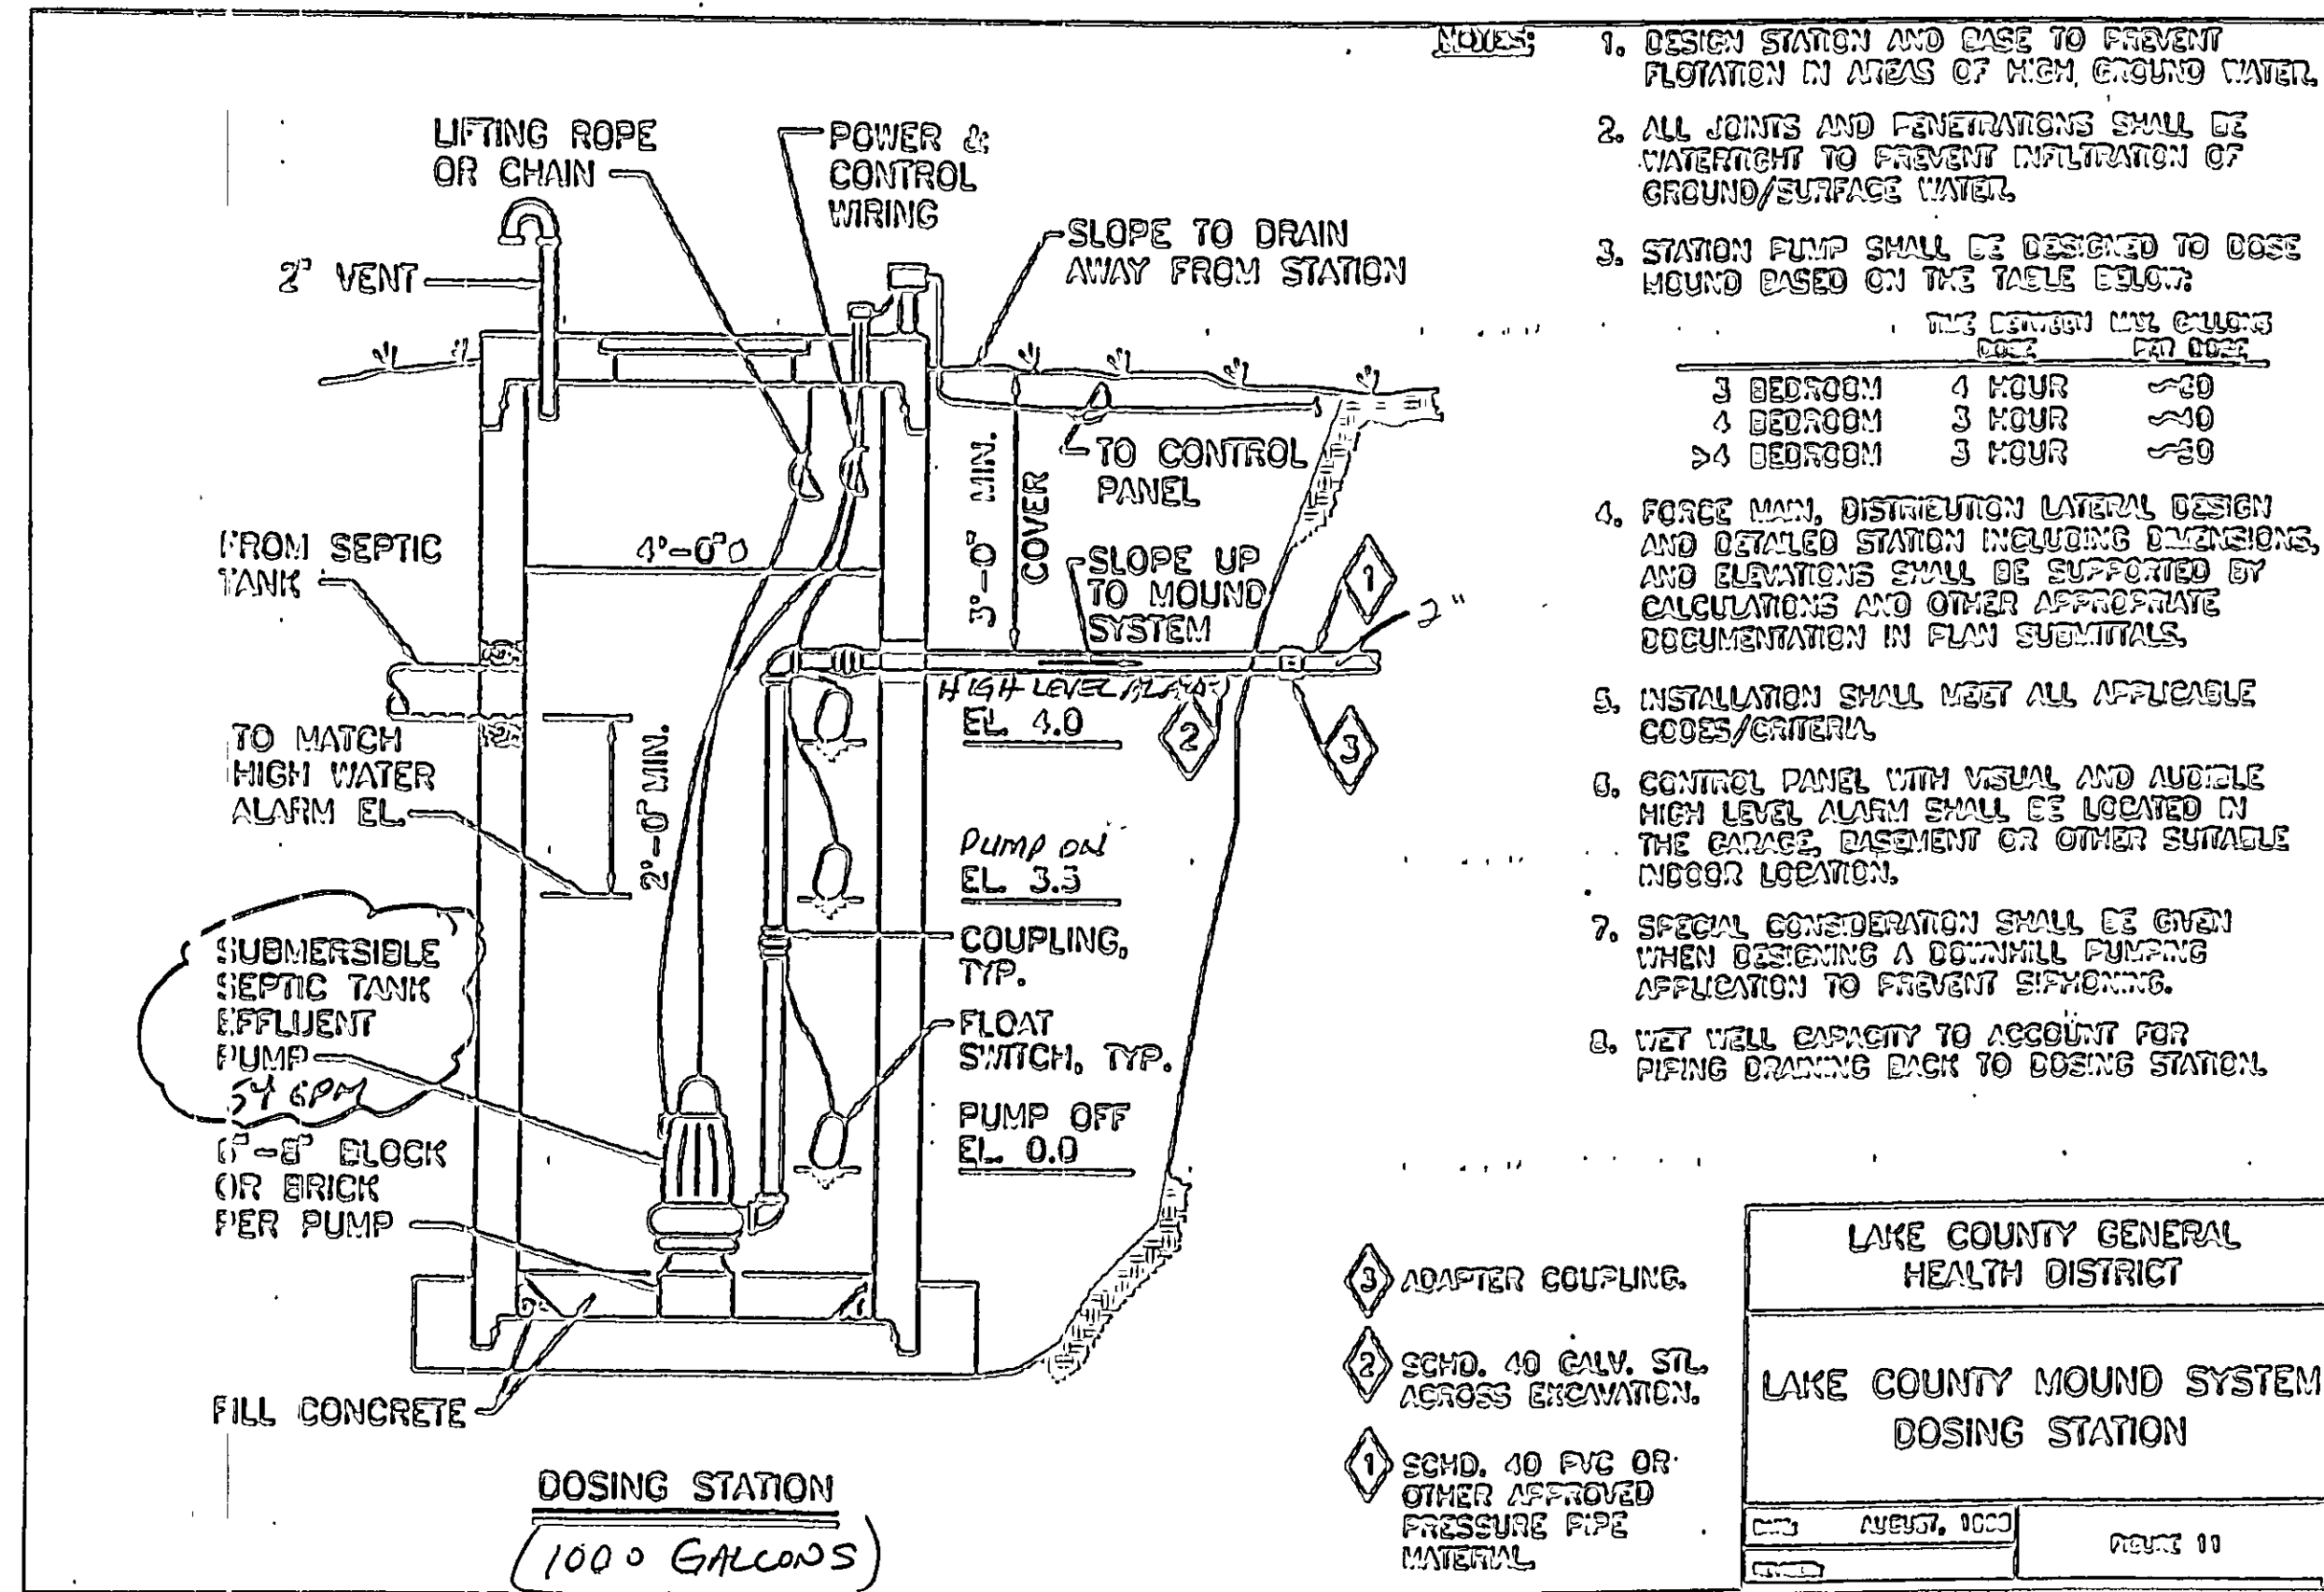

REV. NO.	DESCRIPTION	DATE	BY	CHECKED