

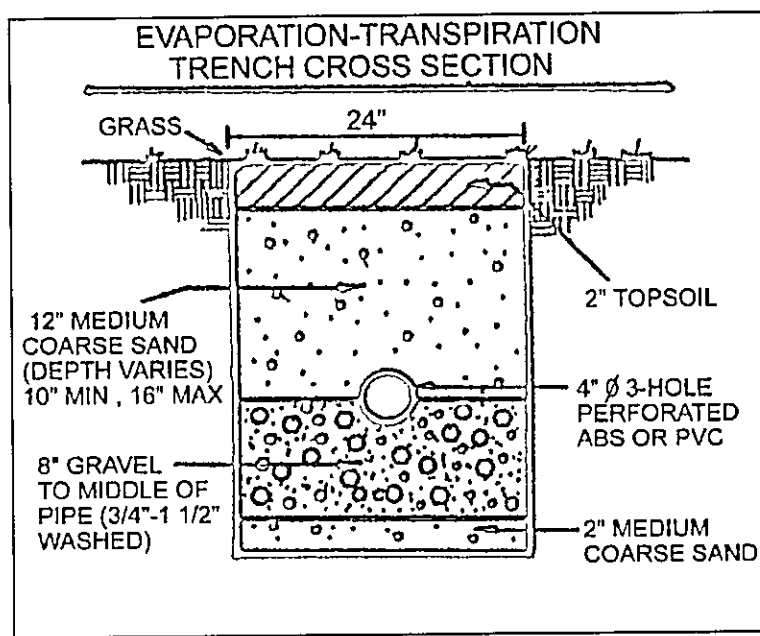


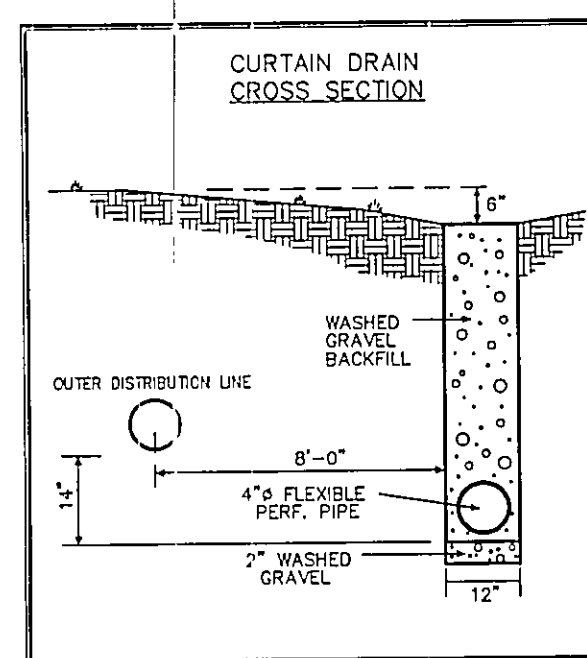

28.00'	44.00'	12.0'	30.00'	24.00'
	1ST FF-		GAR FF-	
	BSMT FF-		UNEX	
	2 BDRM			
	UNEX	10.00'	30.00'	
	44.00'			

SCALE 1"=20'

RAVENNA ROAD - 60'

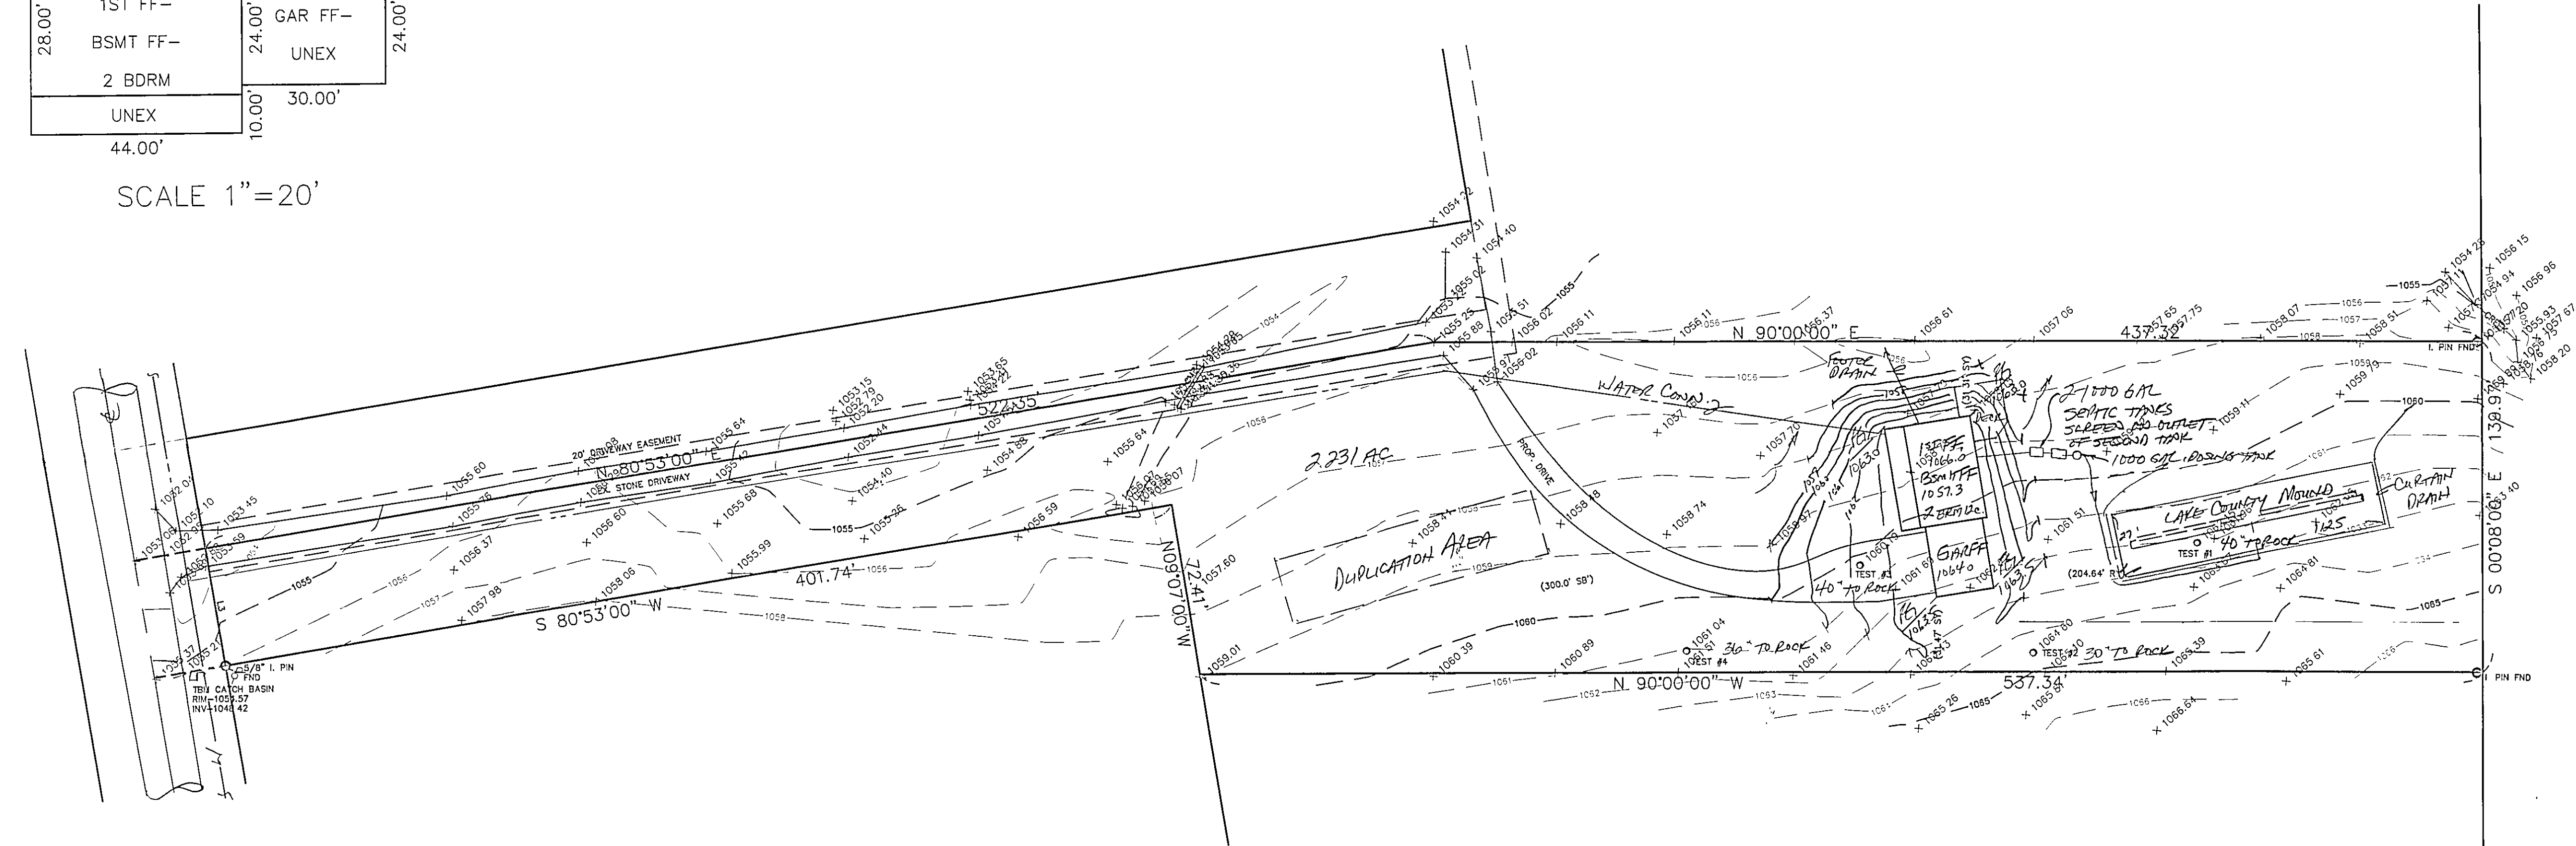

This project is exempt from ESC Plan Review Date 7-2-2003 Lake SWCD


"I, the undersigned hereby certify that this topography indicated by 6", 1" or 2" contours, and elevations shown hereon represent an actual field survey made by me on the 17th day of JUNE, 2003 and that the elevations were taken at appropriate intervals and that as of that date they existed as indicated hereon."

Name: [Signature] Reg. No. 6243

BM CATCH BASIN ELEV-1054.57

LLR = 2.7

EXISTING UTILITIES NOTE: THE SIZE AND LOCATION, BOTH HORIZONTAL AND VERTICAL, OF THE UNDERGROUND UTILITIES SHOWN HEREON, HAVE BEEN OBTAINED BY A SEARCH OF AVAILABLE RECORDS. VERIFICATION BY FIELD OBSERVATION HAS BEEN CONDUCTED WHERE PRACTICAL, HOWEVER, BABCOCK, JONES AND ASSOCIATES, INC. DOES NOT GUARANTEE THE COMPLETENESS NOR ACCURACY THEREOF.

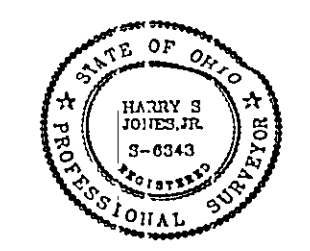

REV NO.	DESCRIPTION	DATE	BY	CHK'D

Grading Plan Approved as shown and/or noted JAMES R. GILLS, P.E. Lake County Engineer By: [Signature] Date: 7/3/03 Discharge Footer Drain to defined drainage channel

BABCOCK, JONES AND ASSOCIATES, INC CIVIL ENGINEERS - SURVEYORS - LAND PLANNERS PAINESVILLE OHIO 44077

DATE 6/19/03 DESIGN BY HJ DRAWN BY NS APPROVED BY HJ

SITE PLAN FOR CEDARCRAFT LOG HOMES CONCORD TOWNSHIP LAKE COUNTY STATE OF OHIO

SCALE 1"=40' JOB NO 03-147 SHEET 1 OF 2