



ZONING PERMIT #0445-9333
 ISSUED 4/14/99
 SUBJECT TO APPROVAL BY:
 Lake County Sanitary Eng. ☐
 Lake County Eng. ☒
 Lake County Eng. ☒
 Lake County Eng. ☒

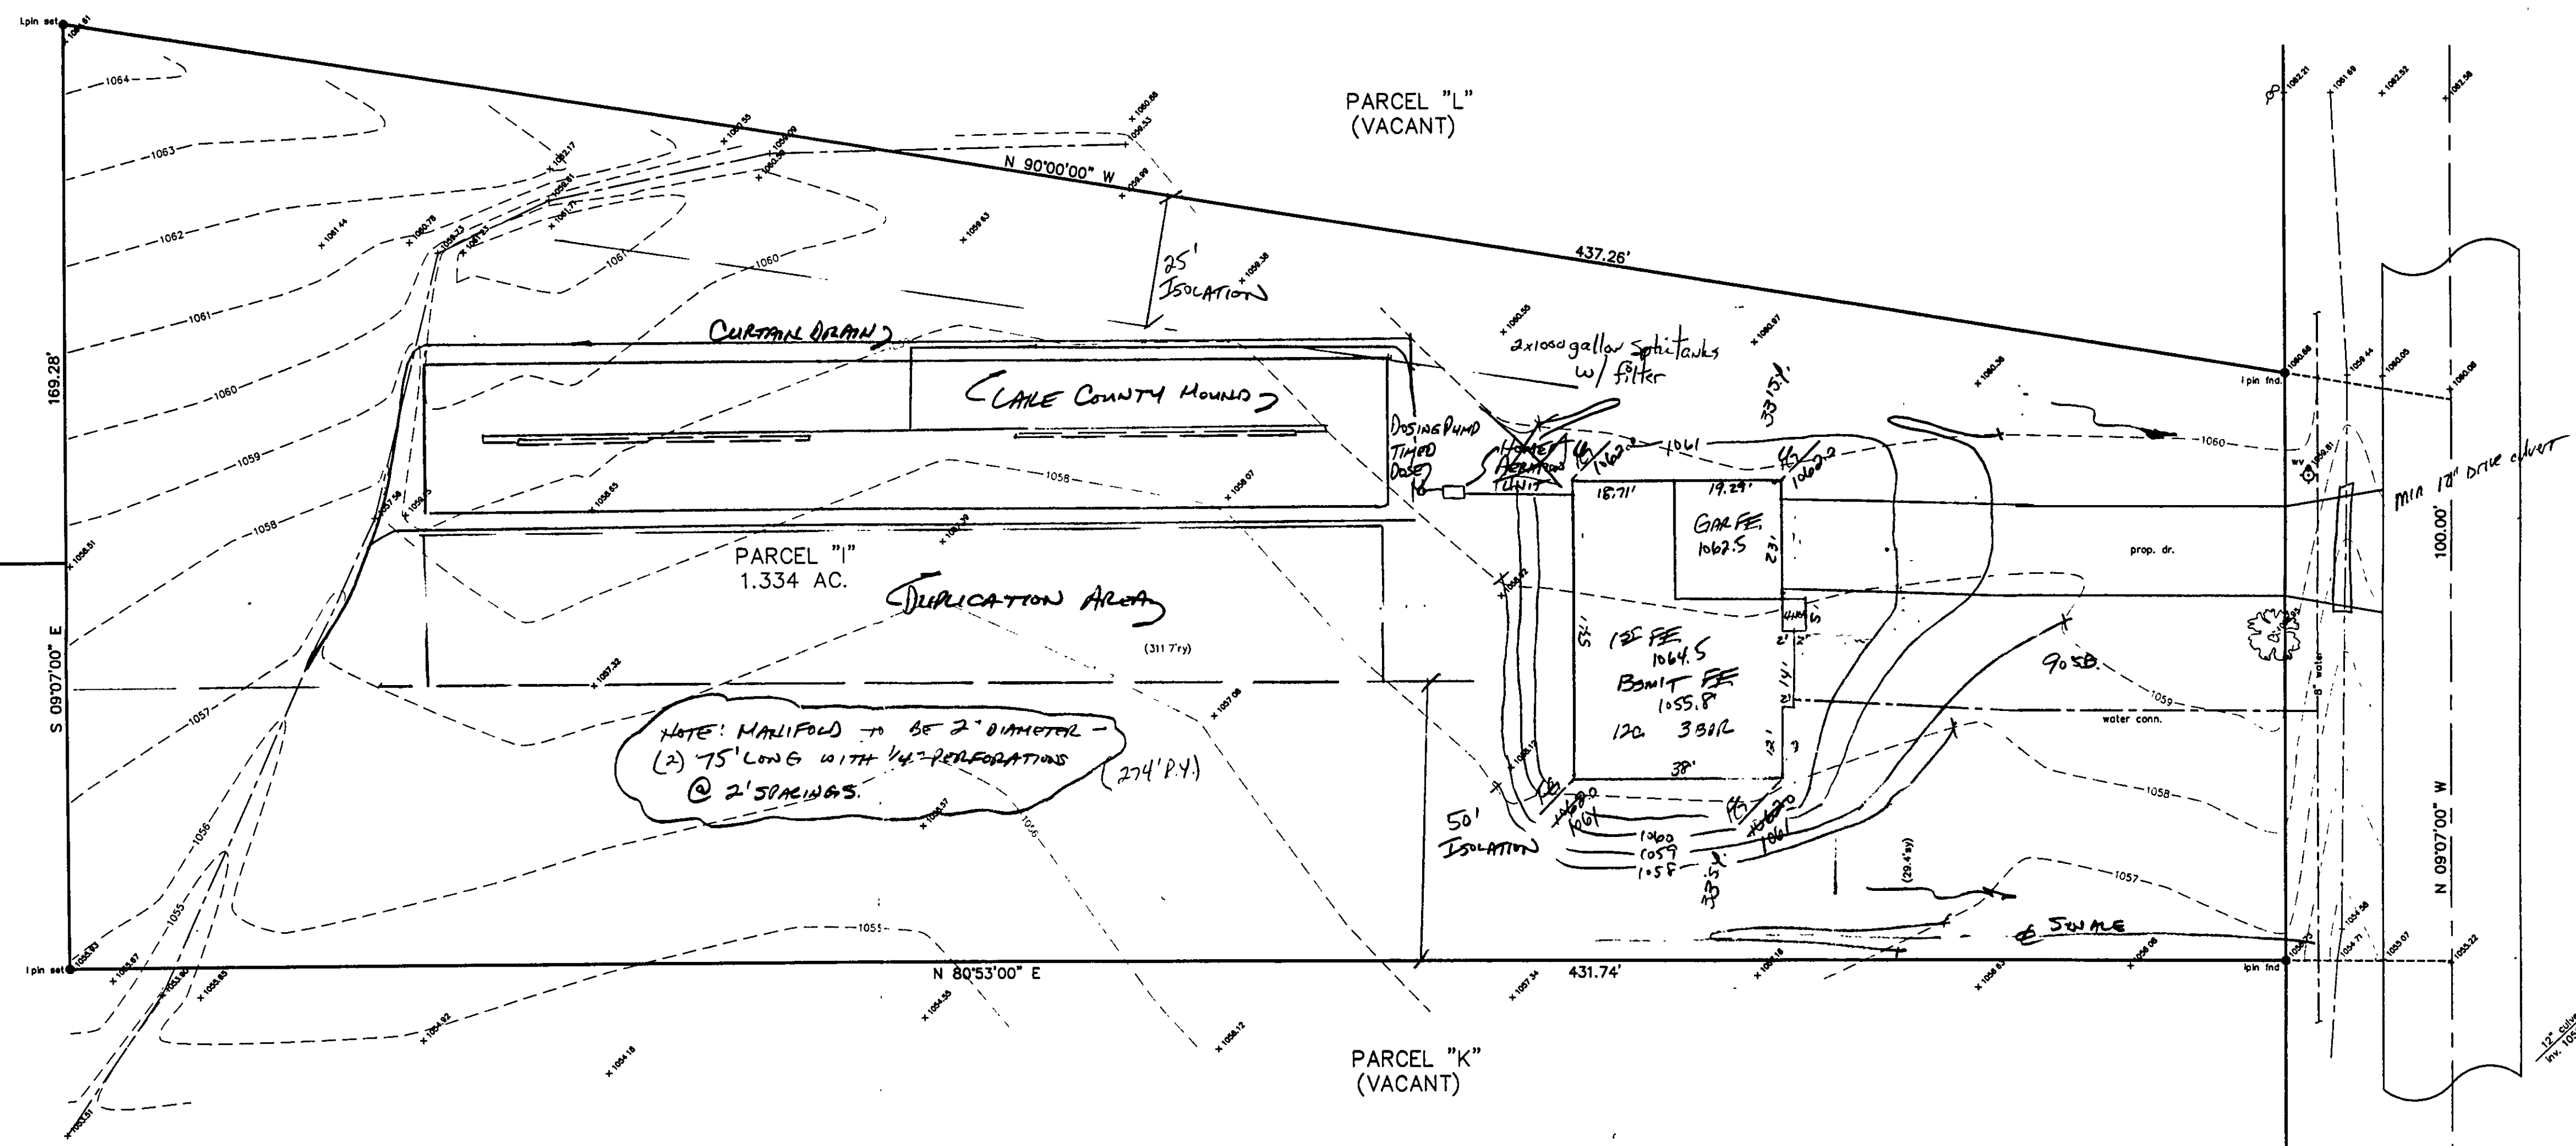

REVIEWED AND ACCEPTED
 LAKE COUNTY GENERAL
 HEALTH DISTRICT
 Date 4-12-99 BY *[Signature]*

SEWAGE DISPOSAL PERMIT MUST BE
 OBTAINED BY A LAKE COUNTY LICENSED
 INSTALLER BEFORE INSTALLATION IS
 STARTED

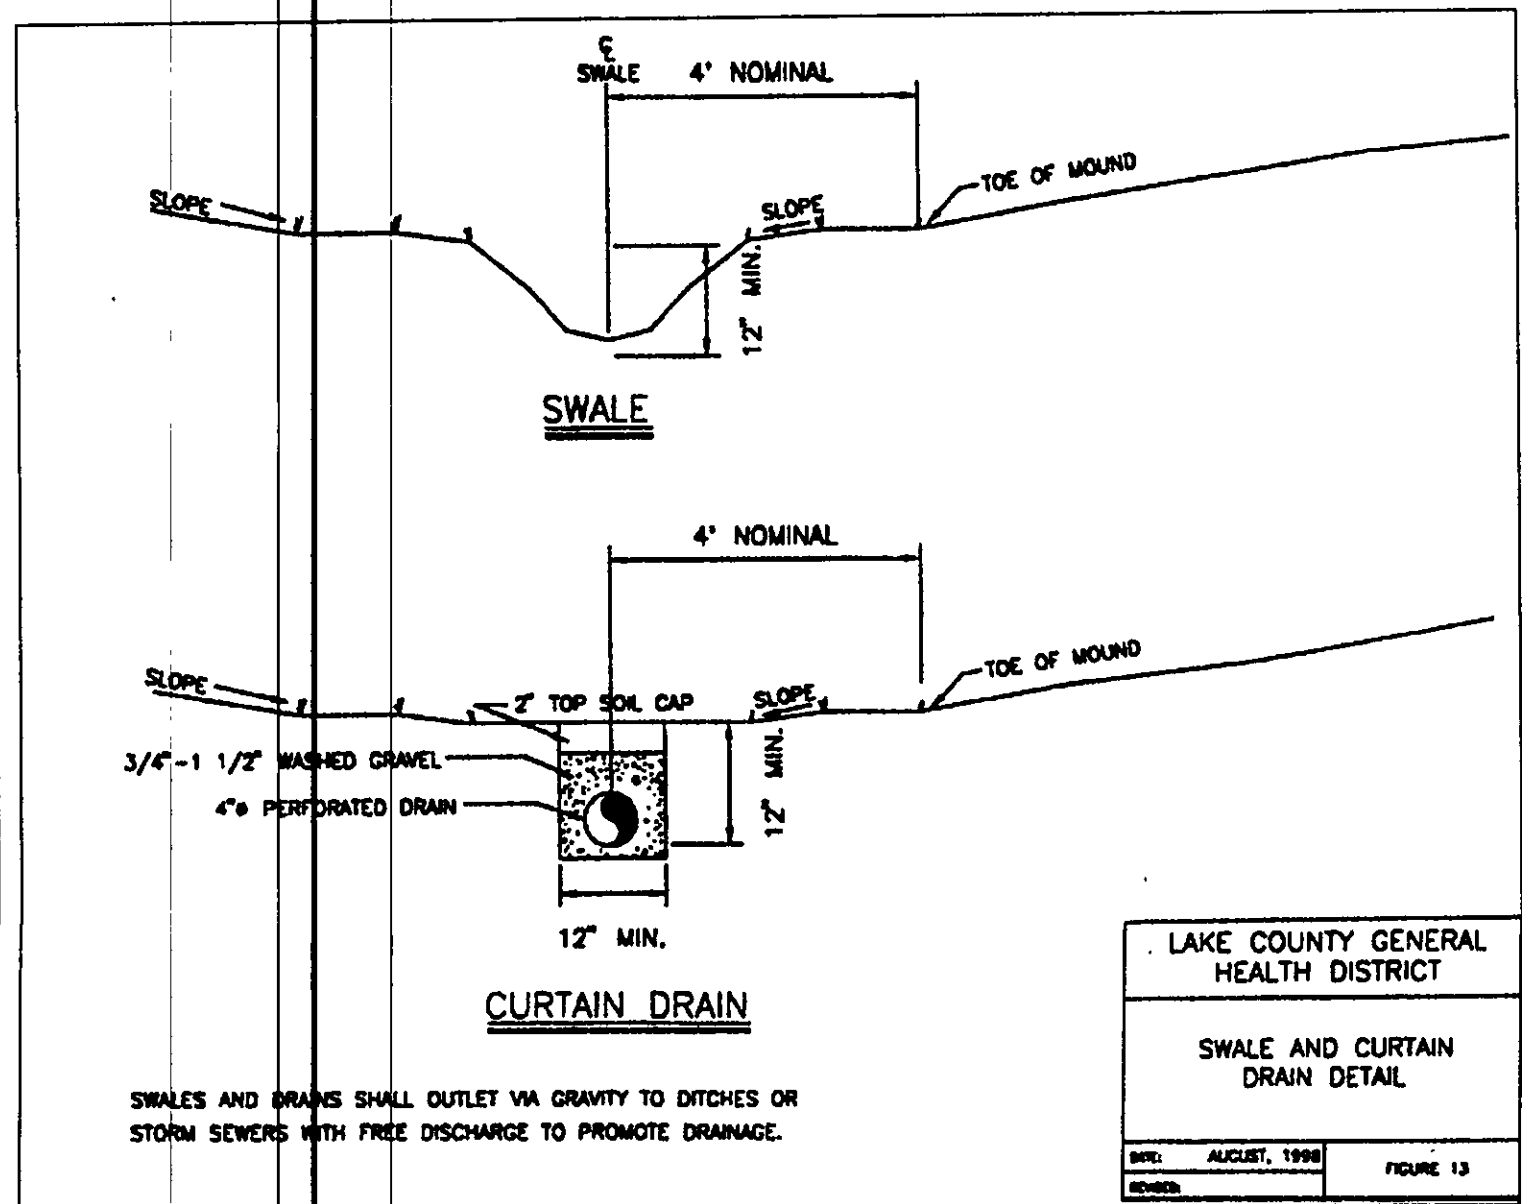

"I, the undersigned hereby certify that
 this topography indicated by 6", 1", or 2'
 contours, and elevations shown hereon
 represent an actual field survey made by
 me on the 21st day of Jan., 1999
 and that the elevations were taken at
 appropriate intervals and that as of that
 date they existed as indicated hereon."

[Signature] #6343
 Name Reg. No.

TBM-TOP OF HYDRANT
 ELEV=1062.46

Grading Plan Approved
 as shown and/or noted
 THOMAS P. GILLES, P.E.
 Lake County Engineer



REV. NO.	DESCRIPTION	DATE	BY	CHK'D
1	REVISION MOUND LOCATION	3-25-99	HT	HT
2	MANIFOLD & PIPE SPACINGS	4-1-99	HT	HT
3	REVISION MANIFOLD	4-12-99	HT	HT

bj BABCOCK, JONES AND ASSOCIATES, INC
 CIVIL ENGINEERS - SURVEYORS - LAND PLANNERS
 PAINESVILLE OHIO 44077

DATE 1/22/99
 DESIGN BY H.J.
 DRAWN BY T.R.
 APPROVED BY H.J.

SITE PLAN
 FOR
 JEANNIE RICE
 8047 RAVENNA RD
 CONCORD TOWNSHIP LAKE COUNTY

SCALE: 1"=20'
 JOB NO 98-180-1
 SHEET 1 OF 2

RAVENNA ROAD - 60'