
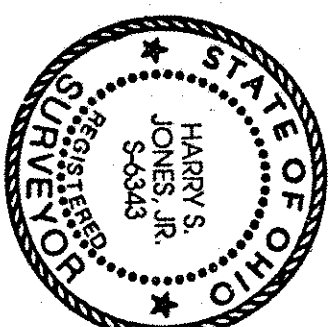


Grading Plan Approved
as shown and/or noted
THOMAS P. GILLES, P.E.
Lake County Engineer
By 6/17 Date 6/28/93
Swale as shown

ROOF DRAINS
SHALL DISCHARGE
TO SPLASH BLOCKS.

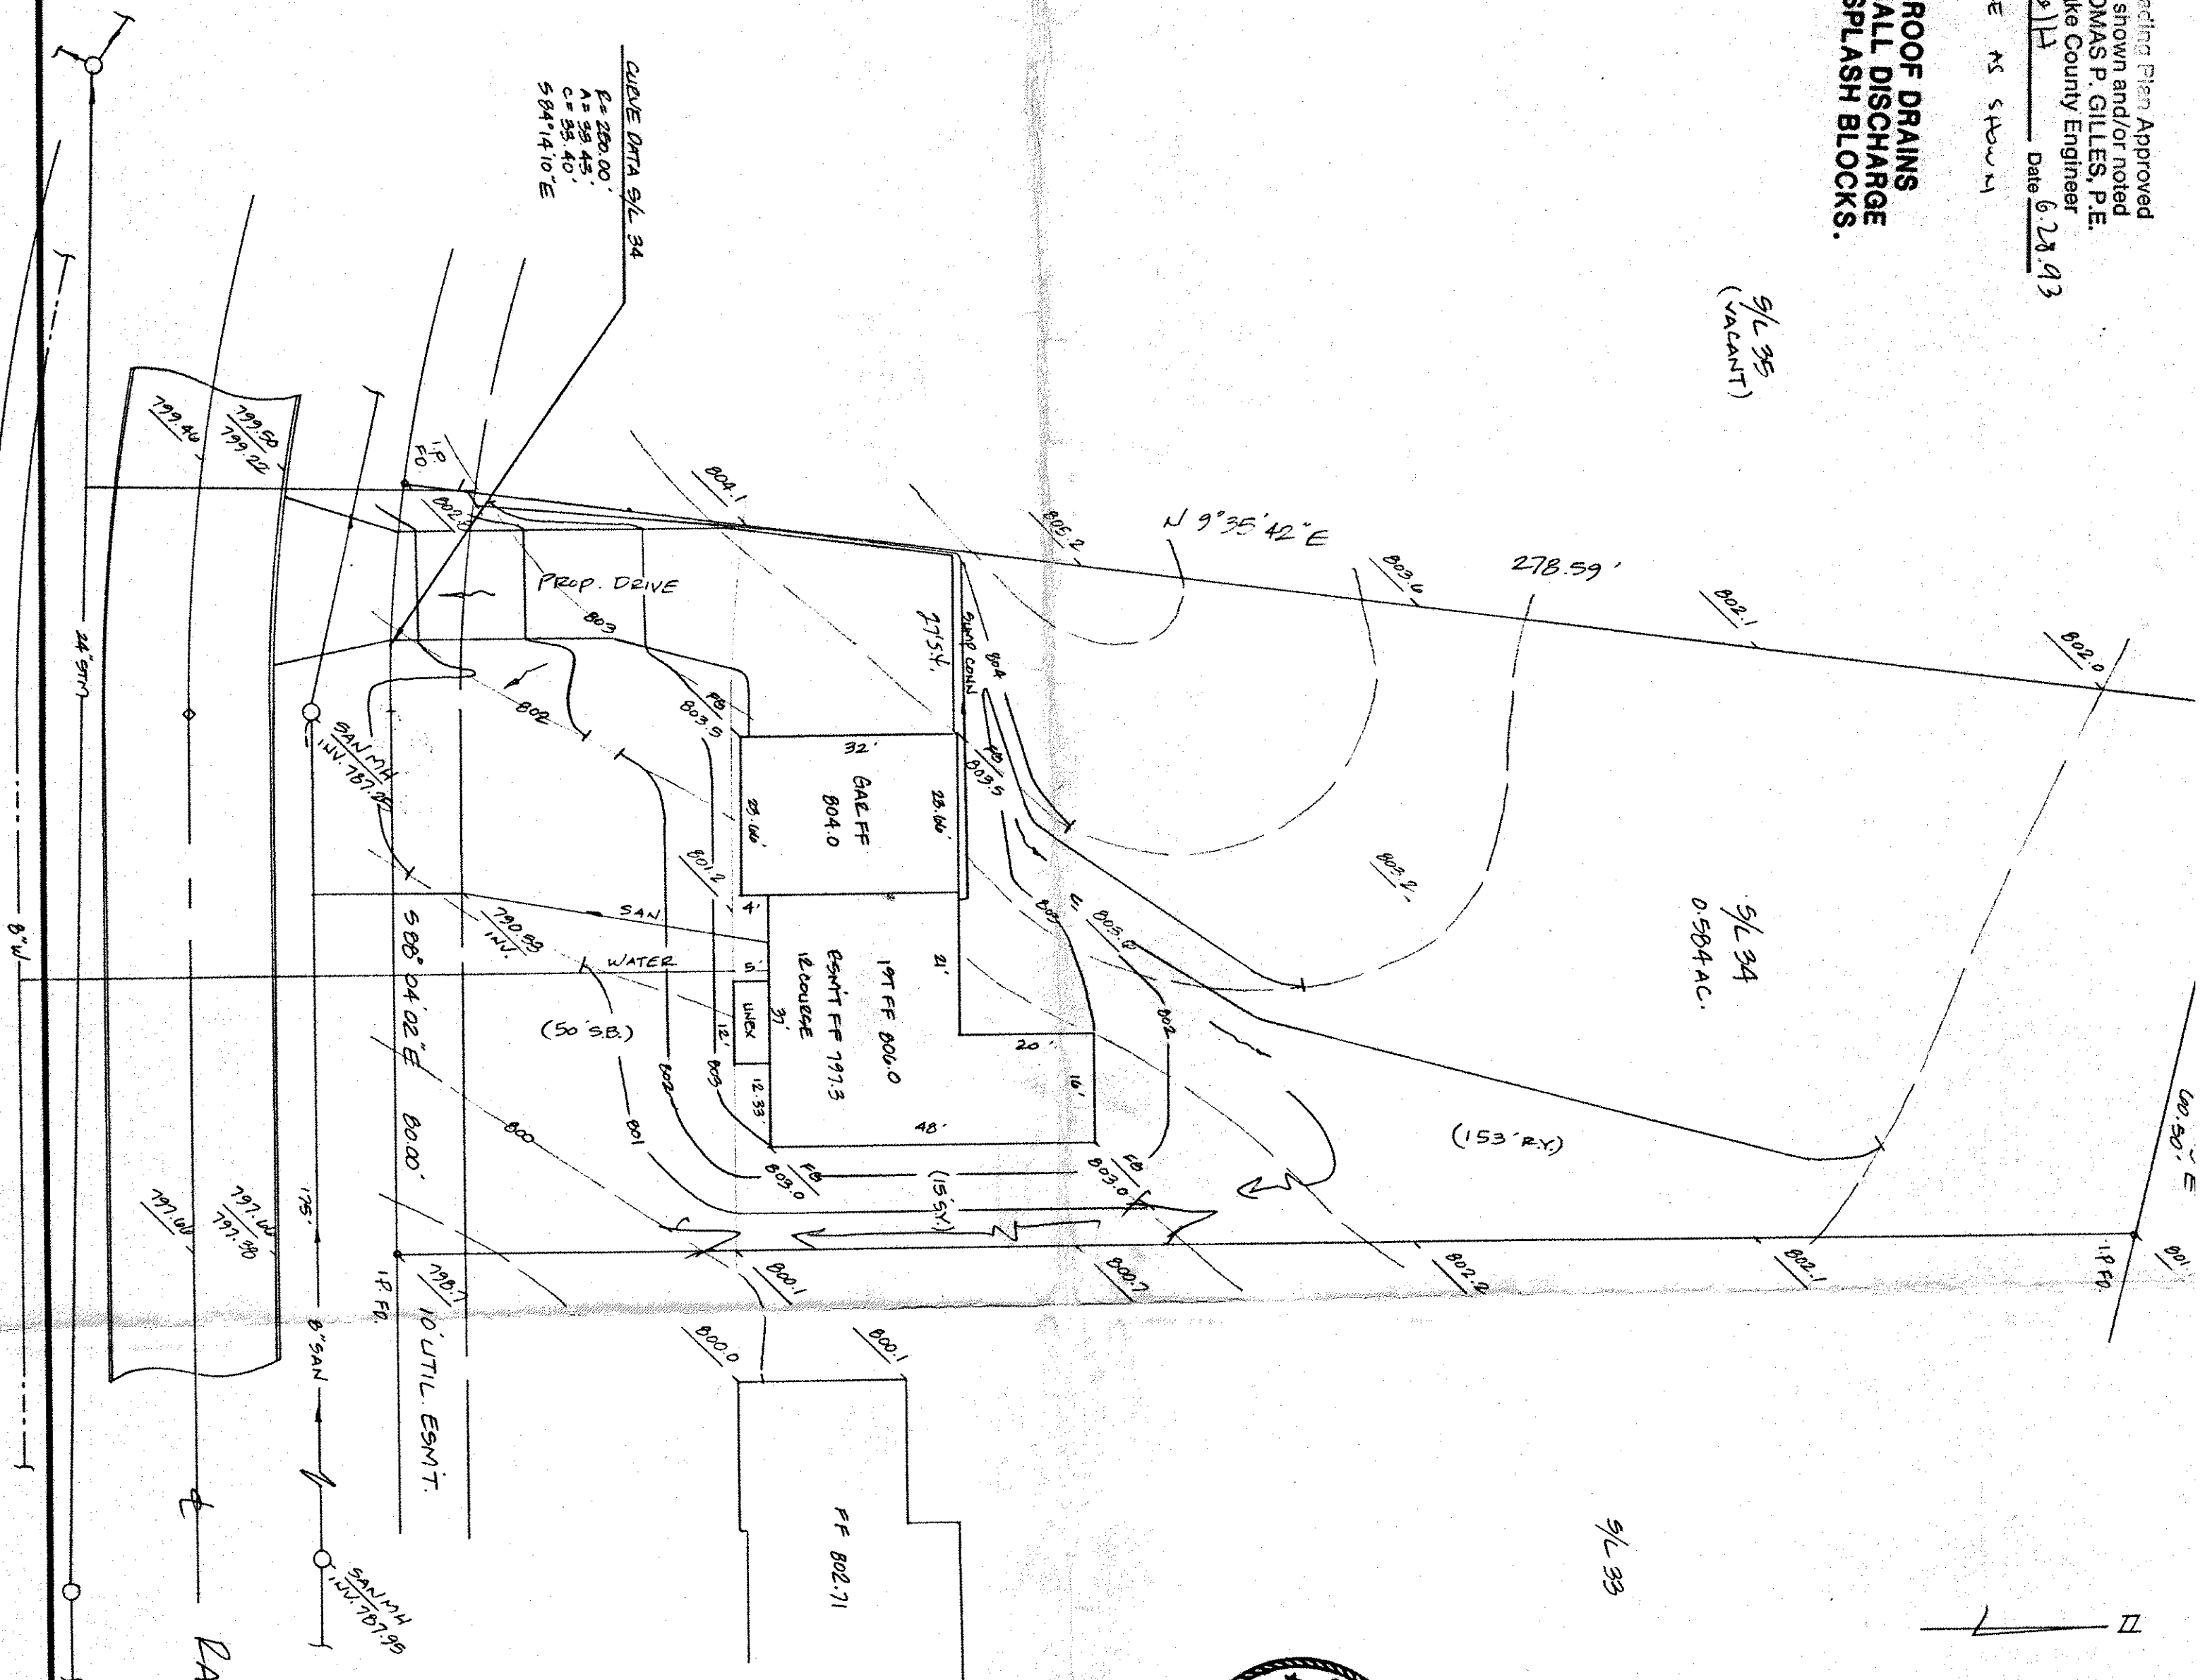

SITE PLAN

CONCORD TWP., LAKE COUNTY, OHIO

for: **MALKAMALI BUILDERS**

ADDRESS: _____ STREET: _____ CITY: _____ ZIP: _____

VOLUME OF CHANGED SUB		LOT	TRACT
SUBDIVISION	NAME	VOLUME	PAGE
34	18-27	34	18-27
SUBLOT NO.	NAME	PERM. PARCEL NO.	STREET
34	RAVENWOOD LN		

LEGEND

SANITARY MANHOLE	WATER VALVE (GAS)
STORM MANHOLE	WATER METER (GAS)
INLET OR CATCH BASIN	AS BUILT ELEVATION
HYDRANT	INDICATES DIRECTION OF SURFACE DRAINAGE
EXISTING CONTOURS	
PROPOSED CONTOURS	
EXIST. ELEV.	100.0
PROP. ELEV.	100.0

REMARKS

ALL BOUNDARY DATA SHOWN WAS OBTAINED FROM (DEEDS, RECORDED SUBDIVISION PLAT OR OTHER PUBLIC RECORDS)
LOCATIONS AS SHOWN OF ADJACENT WELLS AND SEPTIC TANKS OBTAINED FROM LAKE COUNTY HEALTH DEPARTMENT

DESIGN CERTIFICATION

THIS PLAT WAS PREPARED BY ME, AND IS CORRECT TO THE BEST OF MY KNOWLEDGE AND BELIEF.
NAME: HARRY S. JONES, JR. SURVEYOR REGISTRATION NO. S-5343

CHECK LIST

NO. OF BEDROOMS		WATER MAIN SIZE LOCATION	
DIMENSIONS		SAN. SEWER SIZE, % GR. LOC.	
BEARINGS		SAN. MH. CAST. ELEV. INV. ELEV.	
TIE TO NEAREST STREET		SAN. CONN. SIZE, LOC. DEPTH, LOC.	
SUBLOT NO. PARCEL NO.		STORM SEWER SIZE, LOC. DEPTH, LOC.	
SURROUNDING OWNERS		STORM MH. CAST. ELEV. INV. ELEV.	
BLDG. DIMENSIONS FIN. GR.		PLATT TYPE GRADE CURVES	
BLDG. TIES PL. R. GRADES		GAS LINE LOC. SIZE PRESSURE	
APPROX TYPE WIDTH THICKNESS		SEPTIC TANK LOCATION & DUPLICATION AREA	
SIDEWALK TYPE DIA. LENGTH		WELL LOCATION	
CULVERT TYPE DIA. LENGTH		ISOLATION RADII FROM WELL	
ROCK OUTCROPPINGS			

PLAN PREPARED BY:

BABCOCK • JONES & ASSOCIATES, INC.
PAINESVILLE, OHIO

REVISIONS		DRAWN BY		SCALE		DATE		PHONE NO.	
NO.	DATE	BY		1" = 20'		6-16-93		357-1811	
1									
2									
3									
4									
5									

"AS BUILT" CERTIFICATION

I, HEREBY CERTIFY THAT THE CIRCLED GRADES ARE EXISTING FINISH GRADES CHECKED IN THE FIELD ON _____, 19____ AND ARE CORRECT TO THE BEST OF MY KNOWLEDGE AND BELIEF.

REGISTERED SURVEYOR _____ REG. NO. _____

TEMP. BENCHMARK: LHM SAN MH 9/L 35
ELEV. = 801.21

ZONING PERMIT #0693-7537
ISSUED 6-22-93
SUBJECT TO APPROVAL BY:
☐ Lake County Sanitary Eng.
☒ Lake County Eng. Dept.
☐ Lake County Planning Comm.
☒ Lake County Bldg. Dept.

RAVENWOOD LN. - 00'