


800	2	NEARBY BOAT CHARGES IN SOLID GREEN. CALL IN REASON. <i>WASH. 100 TO 6000</i>	INV. 793.84	135-12 STA. ● 2.00K	41157	10
795					W. ● 2.00K	R
790						

CABLE TO ALL WATER AND SANITARY LINES.

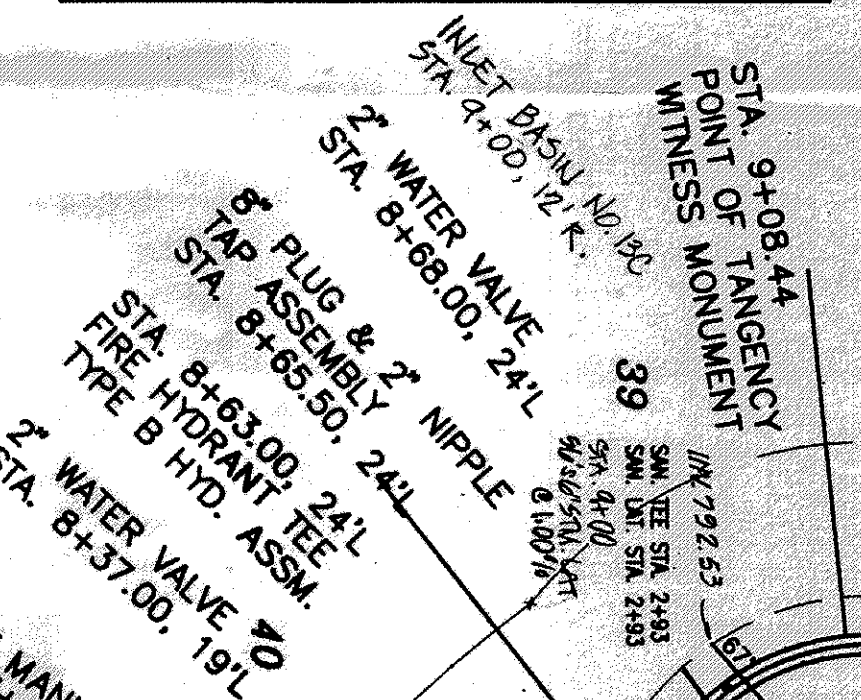

805	STA. 9+08.44
	POINT OF TANGENCY
	WITNESS MONUMENT
800	INLET BLVD. NO. 90
	STA. 4+00.12 R.
	2" WATER VALVE
	STA. 8+68.00. 24" L
795	2" WATER VALVE
	STA. 8+68.00. 24" L
	2" NIPPLE
	STA. 8+68.00. 24" L
	2" PLUG & 2" ASSEMBLY
	STA. 8+65.50. 24" L
	2" ASSEMBLY
	STA. 8+61.00. 24" L
	2" HYDRANT TEE
	STA. 8+57.00. 19" L
790	TYPE B HYD. ASSM.
	2" WATER VALVE
	STA. 8+37.00. 19" L

[illegible][illegible]

...EEVE

STA. 8+08.44
POINT OF TANGENCY
WITNESS MONUMENT
IN# 792.63
39
STA. 8+00.12 K-
INLET BASIN NO. 100
2" WATER VALVE, 24" L
STA. 8+68.00, 24" L
2" PLUG & 2" NIPPLE
STA. 8+65.50, 24" L
8" ASSEMBLY
STA. 8+63.00, 24" L
TRAFFIC FORMING
TYPE B HYD. ASSM.
2" WATER VALVE
STA. 8+37.00, 19" L
INLET MANHOLE
STA. 7+
NOTE: 2"x1" TEE
1" CURB STOP AND BOX
(94E-2 1/4)
SUBLOTS 39 THRU 35



1	ADDED UTILITY PUCT LOCATION	10-2-92	DS
2	ADDED NEW PUMP DRAIN OF SLURROT NO.33	5-12-93	DS

DESIGN BY:	C.B.
CHECKED BY:	—
APPROVED BY:	—

RAVENWOOD LANE 60'

PLAN & PROFILE

VERT. CURV. 1" = 5'	FORM NO.
92206	
SHEET NO.	OF

1" = 5'	CONTRACT NO.	922206	SHEET NO.	OF
---------	--------------	--------	-----------	----