

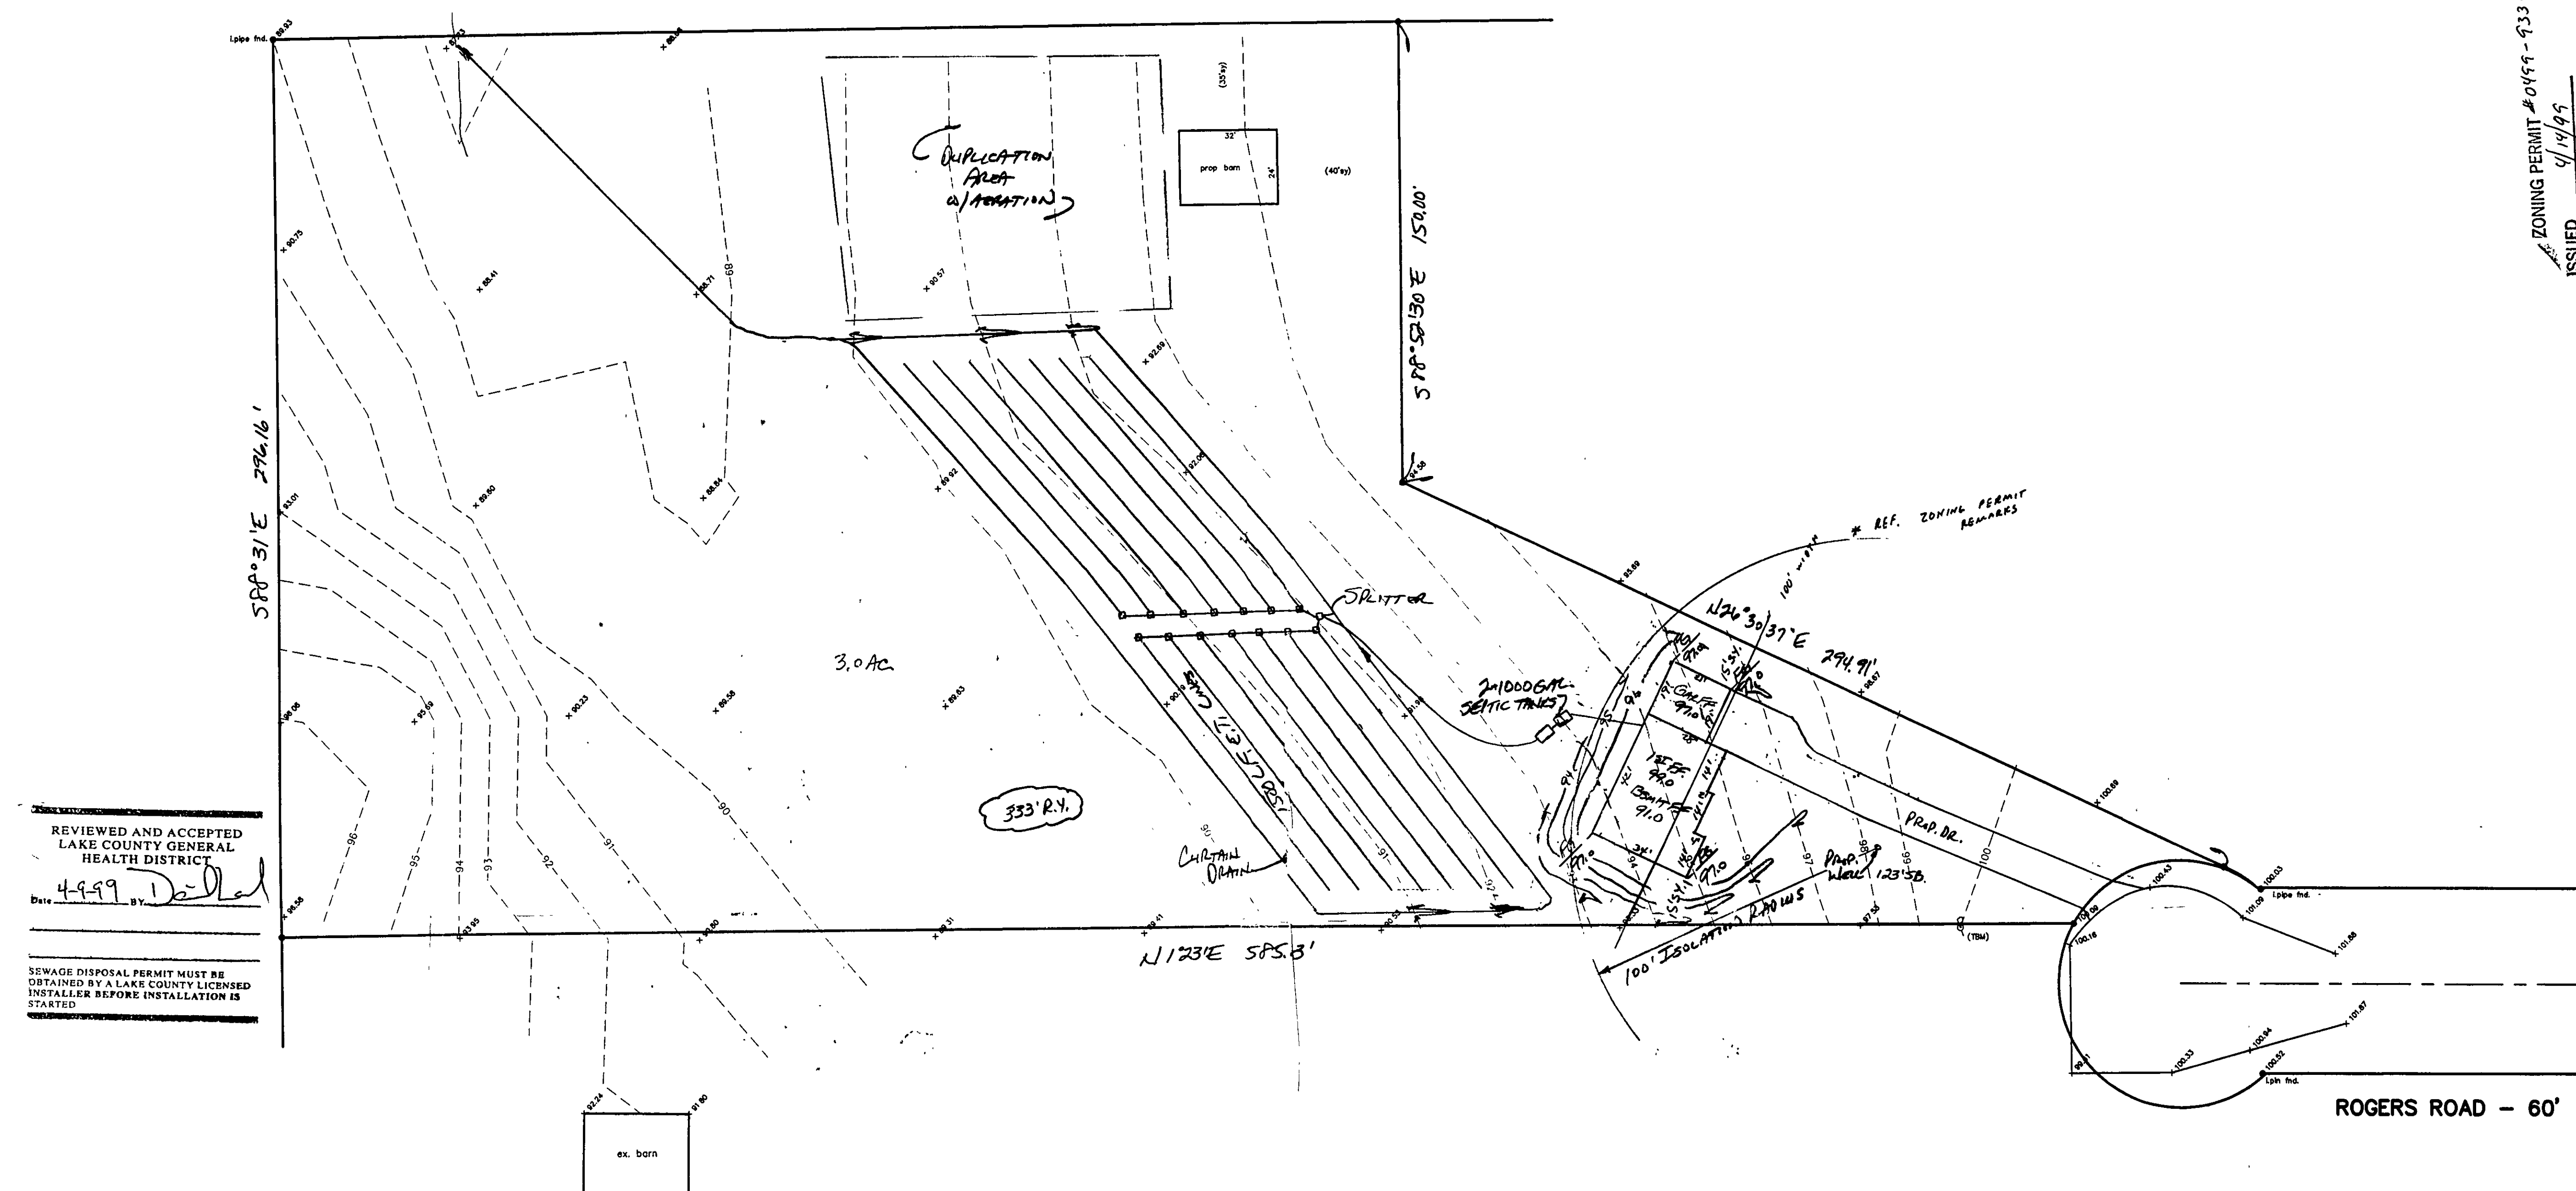
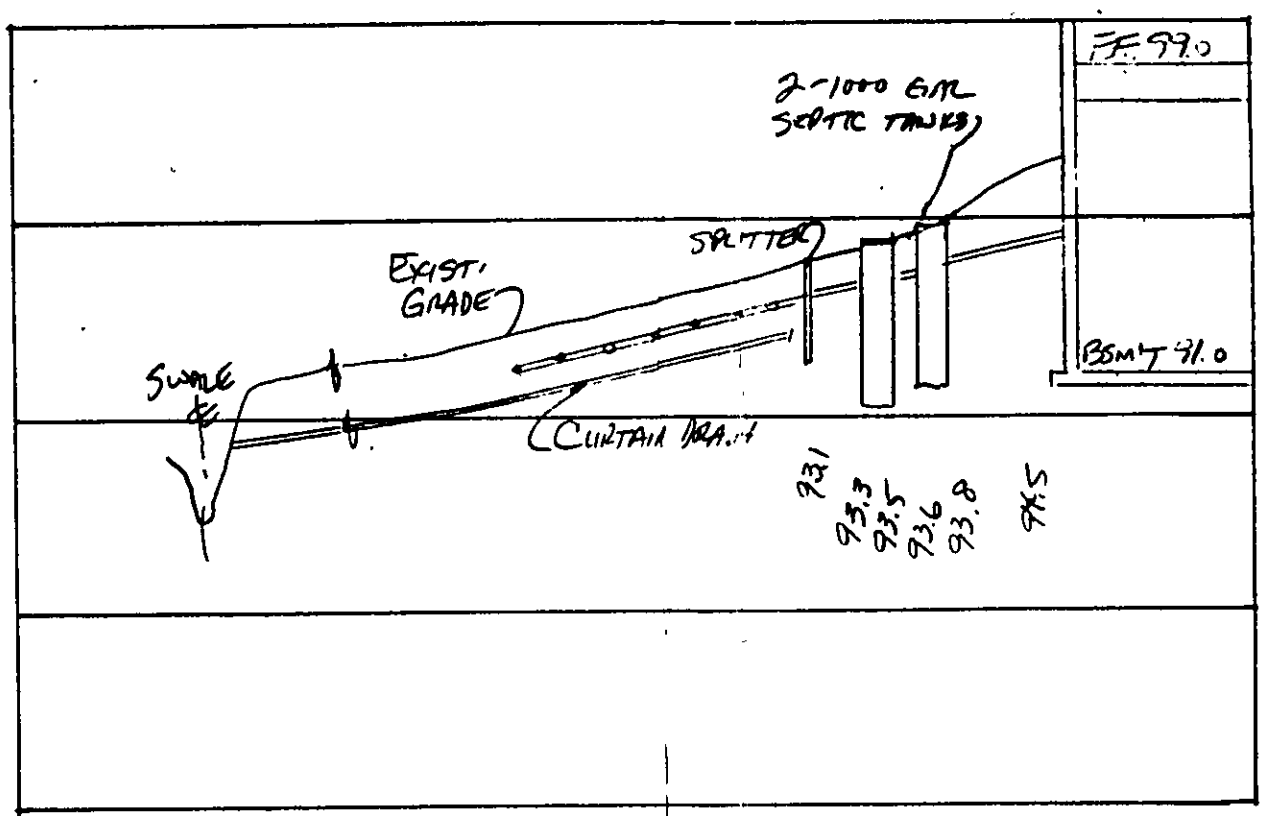


ZONING PERMIT #0499-9332
 ISSUED 4/14/99
 SUBJECT TO APPROVAL BY:
 Lake County Sanitary Eng. ☐
 Lake County Planning Comm. ☒
 Lake County Bldg. Dept. ☒

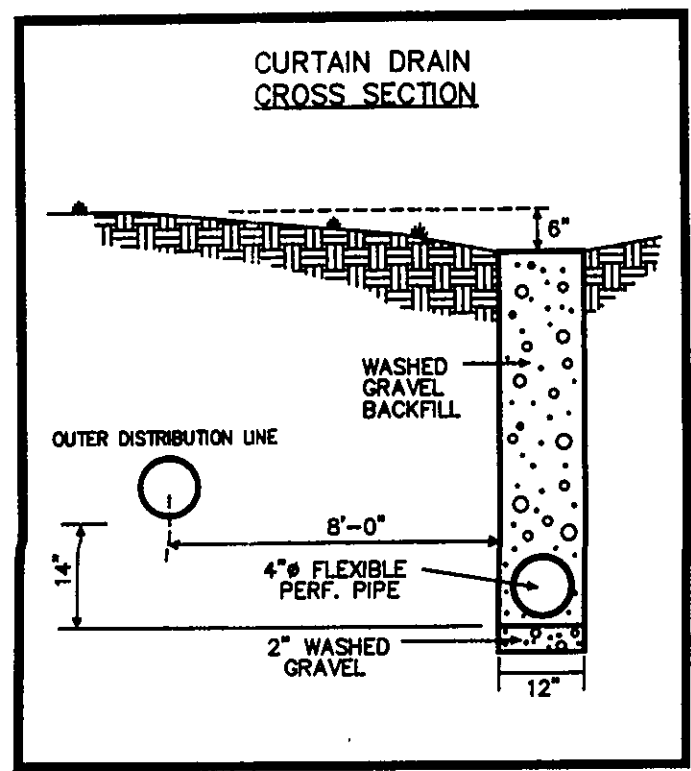

REVIEWED AND ACCEPTED
 LAKE COUNTY GENERAL
 HEALTH DISTRICT
 Date 4-9-99 BY [Signature]
 SEWAGE DISPOSAL PERMIT MUST BE
 OBTAINED BY A LAKE COUNTY LICENSED
 INSTALLER BEFORE INSTALLATION IS
 STARTED

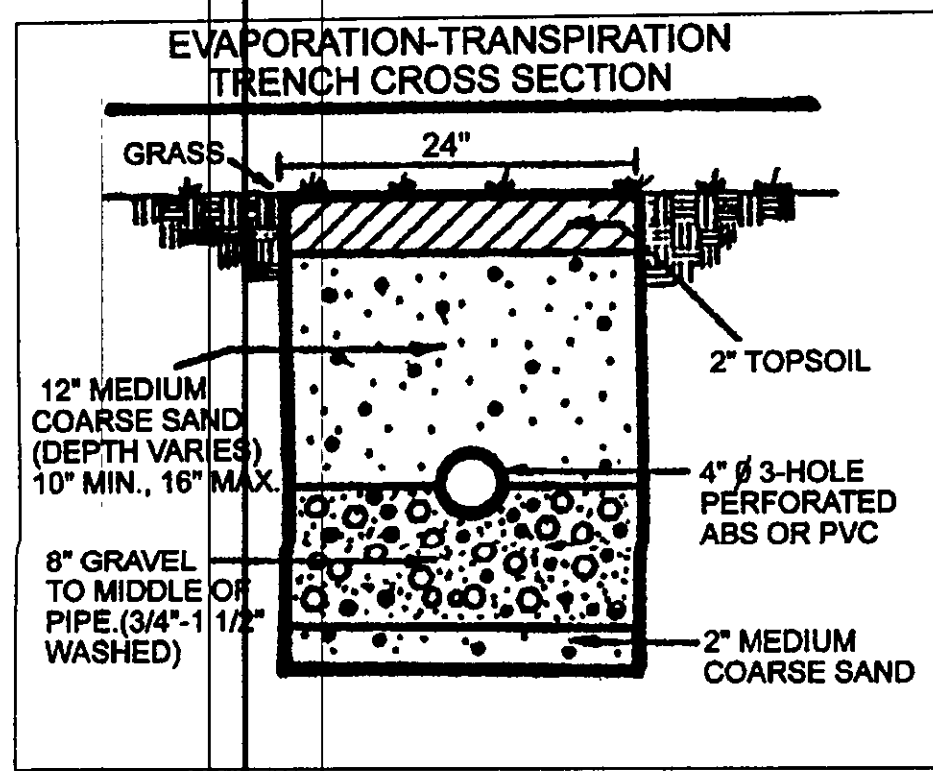


HYDRAULIC PROFILE
 HORIZ. 1"=30' VERT. 1"=5'

"I, the undersigned hereby certify that this topography indicated by 6", 1", or 2" contours, and elevations shown hereon represent an actual field survey made by me on the 16th day of June, 1999 and that the elevations were taken at appropriate intervals and that as of that date they existed as indicated hereon."

Thomas P. Gilles #6313
 Name Reg. No.

TBM-NAIL IN POWER POLE
 ELEV.=100.00

Grading Plan Approved
 as shown and/or noted
 THOMAS P. GILLES, P.E.
 Lake County Engineer

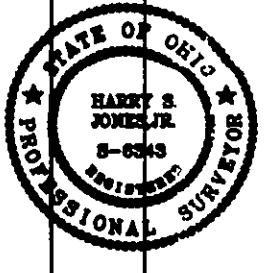

REV. NO.	DESCRIPTION	DATE	BY	CHK'D
1	REVISED HOUSE & SEPTIC			

bj BABCOCK, JONES AND ASSOCIATES, INC
 CIVIL ENGINEERS - SURVEYORS - LAND PLANNERS
 PAINESVILLE OHIO 44077

DATE 3/22/99
 DESIGN BY H.J.
 DRAWN BY T.R.
 APPROVED BY H.J.

SITE PLAN
 FOR
 ROBERT RAINES

CONCORD TOWNSHIP

LAKE COUNTY

SCALE 1"=30'
 JOB NO 99-043
 SHEET 1 OF 1