


SCALE 1=20

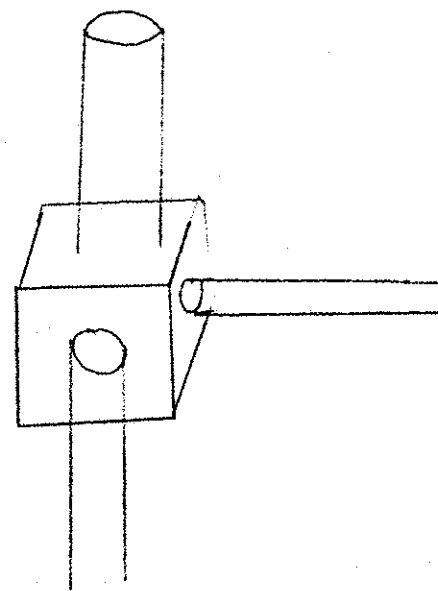

Tanks outlet - 95.0
SPLITTER BOX - 94.0

SPLITTER BOX.

T/CTG. 96.0
INLET. 95.5
OUTLET. 91.3.

94.0

outlet 89

House Fitter Drain
96.0

SEPTIC
TANKS

CURTAIN Drain & Swall
ON THREE SIDES

80' LF- 4" Distribution Line
(1000 Lin Ft. TOTAL)

9315

1005