

CONCORD TOWNSHIP, LAKE COUNTY, OHIO

for: KAY JONES CLIENT

ADDRESS	CITY	ZIP
LOT _____ TRACT _____ VOLUME _____ PAGE _____ PERM. PARCEL NO. _____ STREET _____		

LEGEND	
	SANITARY MANHOLE
	STORM MANHOLE
	INLET OR CATCH BASIN
	HYDRANT
	EXISTING CONTOURS
	PROPOSED CONTOURS
	EXIST. ELEV. 100.0
	PROP. ELEV. 100.0
	WATER VALVE (GAS)
	WATER METER (GAS)
	AS BUILT ELEVATION
	INDICATES DIRECTION OF SURFACE DRAINAGE
	

	REMARKS
	ALL BOUNDARY DATA SHOWN WAS OBTAINED FROM (DEEDS, RECORDED SUBDIVISION PLAT OR OTHER PUBLIC RECORDS)
	LOCATIONS AS SHOWN OF ADJACENT WELLS AND SEPTIC TANKS OBTAINED FROM LAKE COUNTY HEALTH DEPARTMENT

THIS PLAT WAS PREPARED BY ME, AND IS CORRECT
TO THE BEST OF MY KNOWLEDGE AND BELIEF.

[illegible]

NO. OF BEDROOMS
DIMENSIONS
BEARINGS
TIE TO NEAREST STREET
SUBLOT NO. PARCEL NO.
SURROUNDING OWNERS
BLOG. DIMENSIONS FIN. GR.
BLOG. TIES F.L.R. GRADER
APRON TYPE WIDTH THICKNESS
SIDEWALK TYPE WIDTH THICKNESS
CULVERT TYPE DIA. LENGTH
ROCK OUTCROPPINGS

REVISIONS		PLAN PREPARED BY:	
NO.	DATE	BY	
1			
2			
3			
4			
5			

BABCOCK • JONES & ASSOCIATES, INC.

PAINESVILLE, OHIO

PHONE NO. 357-1811

DRAWING NO. *88-075-11*

DRAWN BY <i>BJ</i>	SCALE 1" = 20'	PHONE NO. 357-1811	
CHECK'D. <i>BJ</i>	DATE <i>10/10/88</i>	DRAWING NO.	
CREW CHIEF <i>WJ</i>	APP'D. <i>WJ</i>		

"AS BUILT" CERTIFICATION

I, HEREBY CERTIFY THAT THE CIRCLED GRADES ARE EXISTING
FINISH GRADES CHECKED IN THE FIELD ON _____, 19____,
AND ARE CORRECT TO THE BEST OF MY KNOWLEDGE AND BELIEF.

REGISTERED SURVEYOR REG. NO.

Grading Plan Approved
as shown and/or noted
THOMAS P. GILLES, P.E.

110.11
#6311

SECRET

Date 10/10/89 10-10-89

.....

THE UNIVERSITY OF CHICAGO

Lake County

THE UNIVERSITY OF CHICAGO


Large Group Planning Room

LAKE CO. ILL.

Lake County Bldg. Dept.

3

Piero S. Marano

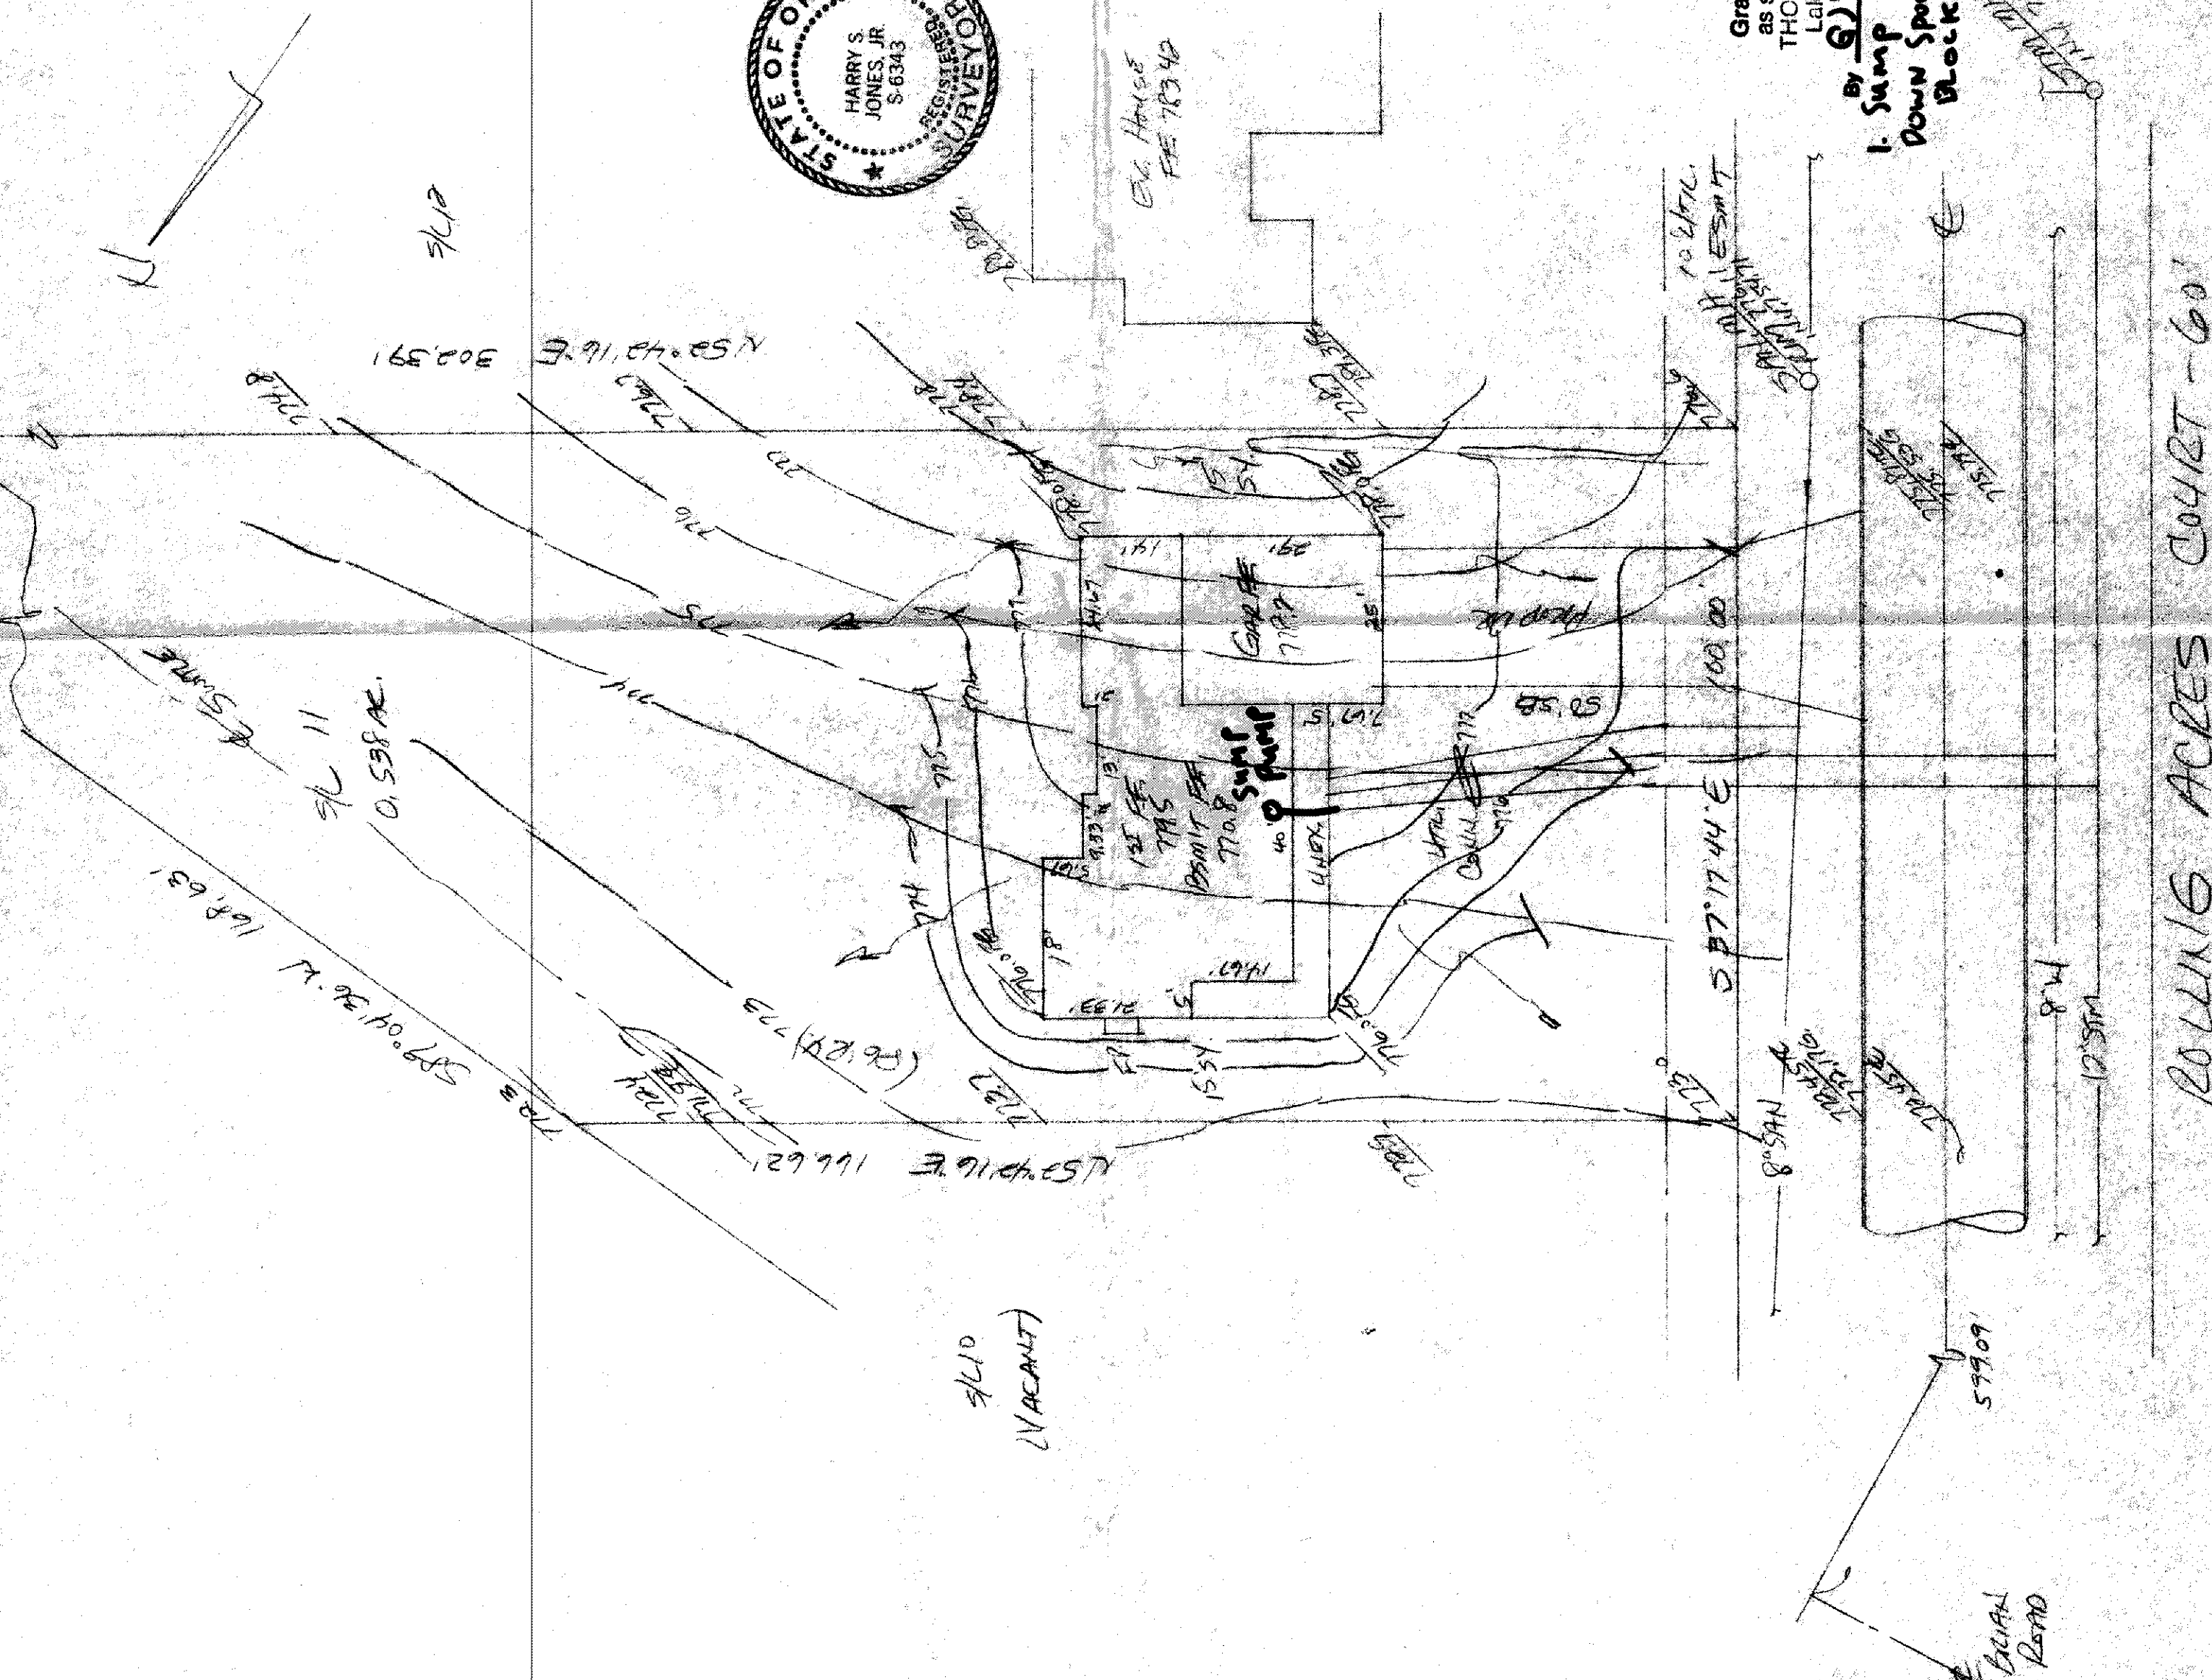

20.44X16 ACRES