

SITE PLAN

BARCO TOOLSHED, LAKE COUNTY, OHIO

for: R.L. MOORE BUILDERS

CLIENT OWNER

Engineering Plan Approved
by and/or noted
S.P. GILLES, P.E.
County Engineer
Date 10/13/88
Note: No tie to street
sewer from footer
as per requirements.

ADDRESS	STREET	CITY	ZIP
LOT _____ TRACT _____ SUBDIVISION <u>10-37</u> NAME _____ VOLUME _____ PAGE _____ SHEET NO. <u>1</u> PERM. TARGET NO. _____ STREET _____			

LEGEND SANITARY MANHOLE ---●--- STORM MANHOLE ---●--- INLET OR CATCH BASIN ---●--- HYDRANT ---●--- EXISTING CONTOURS ---●--- PROPOSED CONTOURS ---●--- EXIST. ELEV. <u>5'-10.00</u> PROP. ELEV. <u>5'-10.00</u>		WATER VALVE (GAS) ---●--- WATER METER (GAS) ---●--- AS BUILT ELEVATION ---●--- INDICATES DIRECTION OF SURFACE DRAINAGE
---	--	---

REMARKS

ALL BOUNDARY DATA SHOWN WAS OBTAINED FROM (IDEAS, RECORDED SUBDIVISION PLAT OR OTHER PUBLIC RECORDS)

LOCATIONS AS SHOWN OF ADJACENT WELLS AND SEPTIC TANKS OBTAINED FROM LAKE COUNTY HEALTH DEPARTMENT

DESIGN CERTIFICATION

THIS PLAT WAS PREPARED BY ME, AND IS CORRECT TO THE BEST OF MY KNOWLEDGE AND BELIEF

NAME Harry S. Jones, Jr. SURVEYOR REGISTRATION NO. 5-6343

CHECK LIST

NO. OF BEDROOMS	WATER MAIN SIZE, LOCATION
NO. OF BATHS	SEWER MAIN SIZE, LOCATION
NO. OF KITCHENS	SEWER MAIN, CAST. ELEV., INV. ELEV.
NO. OF LIVING AREAS	SEWER MAIN, SIZE, LOC. DEPTH
NO. OF DINING AREAS	STORM MAIN, CAST. ELEV., INV. ELEV.
NO. OF GARAGES	STORM MAIN, SIZE, LOC. DEPTH
NO. OF PORCHES	PAV. TYPE, GRADE CURNS
NO. OF DRIVEWAYS	GAS LINE LOC. SIZE, PRESSURE
NO. OF PATIOS	SEPTIC TANK LOCATION & CAPACITATION AREA
NO. OF DECKS	WELL LOCATION
NO. OF FENCES	ISOLATION RADIUS FROM WELL
NO. OF ROCK OUTCROPPINGS	

PLAN PREPARED BY:

BABCOCK • JONES & ASSOCIATES, INC.

PAINESVILLE, OHIO

NO.	DATE	BY	SCALE	DATE	PHONE NO.
1	10/12/88	HT	1" = 20'	10/13/88	357-1811
2					
3					
4					
5					

CREW: CHIEF GD APP'D. HT DRAWING NO. 88-075-7

"AS BUILT" CERTIFICATION

I, HEREBY CERTIFY THAT THE CIRCLED GRADES ARE EXISTING FINISH GRADES CHECKED IN THE FIELD ON 19 AND ARE CORRECT TO THE BEST OF MY KNOWLEDGE AND BELIEF.


REGISTERED SURVEYOR REG. NO.

72071 - 1214 S.W. 714

ELEV. = 734.59

10-13-88

#6001

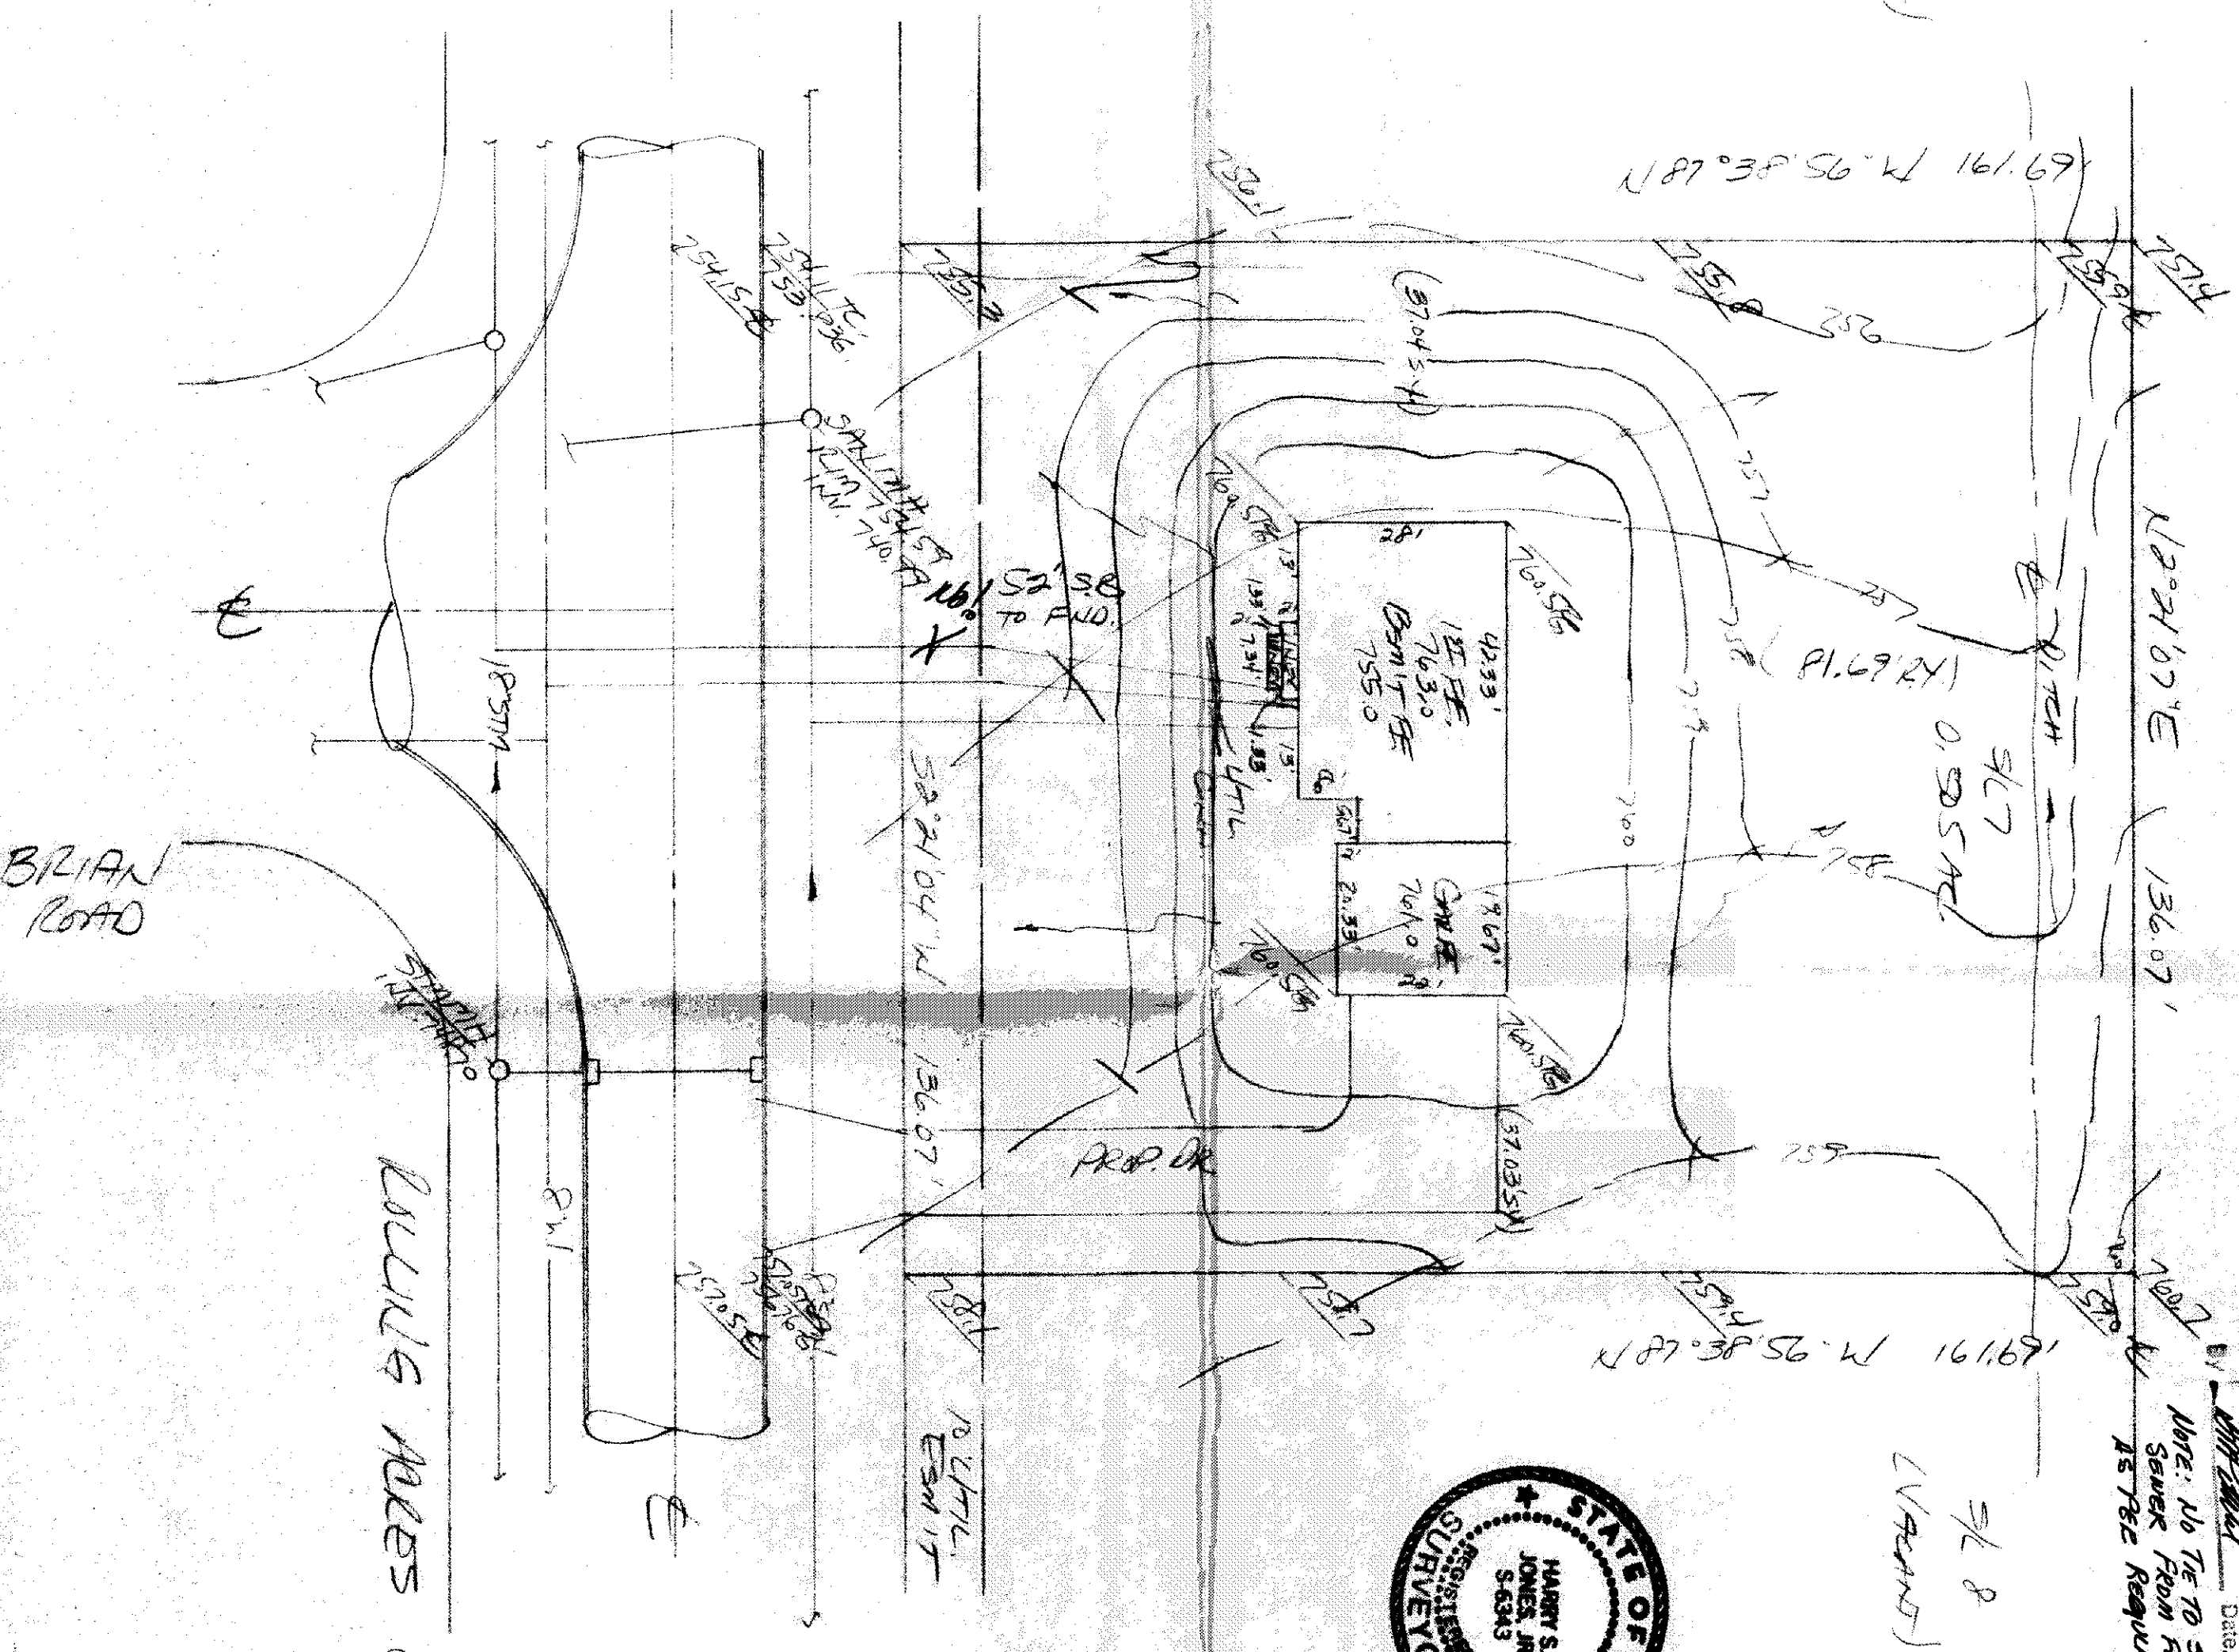

Tom R. Warrans