

SITE PLAN

COLUMBIA TOWNSHIP, LAKE COUNTY, OHIO

for: LAY HOMES

OWNER

ADDRESS STREET CITY ZIP

HEALY PLANNING SUB
SUBDIVISION 18-39 NAME
VOL. NO. 18-39
PAGE 18-39
SUBLOT NO. 18-39
PERM. PARCEL NO. 18-39
STREET 18-39

LEGEND

SANITARY MANHOLE
STORM MANHOLE
INLET OR CATCH BASIN
HYDRAULIC
EXISTING CONTOURS
PROPOSED CONTOURS
EXIST. ELEV. 100.0
PROP. ELEV. 100.0

REMARKS

ALL BOUNDARY DATA SHOWN WAS OBTAINED FROM (IDEOS, RECORDED
SUBDIVISION PLAT OR OTHER PUBLIC RECORDS)
LOCATIONS AS SHOWN OF ADJACENT WELLS AND SEPTIC TANKS OBTAINED FROM
LAKE COUNTY HEALTH DEPARTMENT

DESIGN CERTIFICATION

THIS PLAT WAS PREPARED BY ME, AND IS CORRECT
TO THE BEST OF MY KNOWLEDGE AND BELIEF

NAME SURVEYOR REGISTRATION NO.

CHECK LIST

NO. OF BEDROOMS
DIMENSIONS
SAN. SEWER SIZE & GR. LOC.
SAN. MH. CAST. ELEV. INV. ELEV.
SAN. CONN. SIZE, LOC. DEPTH
STORM SEWER SIZE & GR. LOC.
STORM MH. CAST ELEV. INV. ELEV.
PAV'T TYPE, GRADE, CURBS
SEPTIC TANK LOCATION & CAPACITATION AREA
WELL LOCATION
ISOLATION RADIUS FROM WELL

PLAN PREPARED BY:

BABCOCK • JONES & ASSOCIATES, INC.

PAINESVILLE, OHIO

NO.	DATE	BY
1	10/1/88	HB
2	10/1/88	HB
3	10/1/88	HB
4	10/1/88	HB
5	10/1/88	HB

"AS BUILT" CERTIFICATION

I, HEREBY CERTIFY THAT THE CIRCLED GRADES ARE EXISTING
FINISH GRADES CHECKED IN THE FIELD ON 19
AND ARE CORRECT TO THE BEST OF MY KNOWLEDGE AND BELIEF.

REGISTERED SURVEYOR


REG. NO.

71577 - RIM SHAL 17.74

6762 - 776.11

forming permit
0036

NOTE: PROPOSED SWALE
CLEAR OF SUBLOTS
NO. 1 TO NO. 12 TO
BE ADJUTED TO
RETAINING BASIN
PER APPROVED
GRADING PLAN
PER L.C. ENGINEER,
(VACANT)

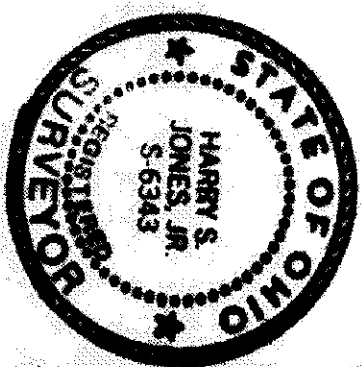

Grading Plan Approved
as shown and/or noted
THOMAS P. GILLES, P.E.
Lake County Engineer
Date 10/1/88

ROLLIN'S ACRES COURT - 60'

