

SITE PLAN


Colcord Township, Lake County, Ohio

for: SHARPE CONSTRUCTION

ADDRESS: _____ STREET: _____ CITY: _____ ZIP: _____

LEGEND
 LOT: _____ TRACT: _____
 VOLUME: _____ PAGE: _____
 SHEET NO. 43 SOUTH CHARIOT STREET

REMARKS
 ALL BOUNDARY DATA SHOWN WAS OBTAINED FROM IDEM, INCORPORATED
 SUBDIVISION PLAT ON OTHER PUBLIC RECORDS
 LOCATIONS AS SHOWN OF ADJACENT WELLS AND SEPTIC TANKS OBTAINED FROM
 LAKE COUNTY HEALTH DEPARTMENT

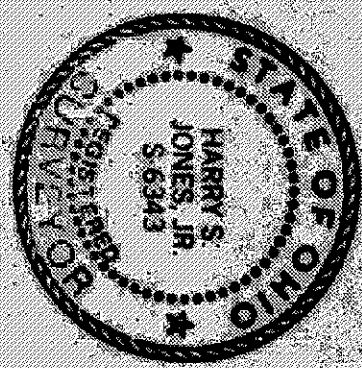

DESIGN CERTIFICATION

THIS PLAN WAS PREPARED BY ME, AND IS CORRECT
 TO THE BEST OF MY KNOWLEDGE AND BELIEF

NAME: Harry S. Jones, Jr. REGISTRATION NO. 63943

CHECKLIST

NO. OF RECORDS	DESCRIPTION	DATE	BY
1	WATER MAIN SIZE, LOCATION, DEPTH, ELEV. & ON, LOC.		
2	SEWER MAIN SIZE, ON, LOC.		
3	STORM SEWER SIZE, ON, LOC.		
4	EXISTING CONTOURS		
5	PROPOSED CONTOURS		
6	EXIST. ELEV.		

PLAN PREPARED BY: BABCOCK • JONES & ASSOCIATES, INC.

PAINVILLE, OHIO

NO.	DATE	BY	SCALE	PROJ. NO.
1			1" = 20'	357-1811
2				
3				
4				
5				
6				

"AS BUILT" CERTIFICATION

I, HEREBY CERTIFY THAT THE CIRCLED GRADES ARE EXISTING
 FINISH GRADES CHECKED IN THE FIELD ON _____ 19____
 AND ARE CORRECT TO THE BEST OF MY KNOWLEDGE AND BELIEF.

REGISTERED SURVEYOR

REG. NO.

T.B.M. SAN M.H. R.M. SL 49. ELE. = 978.55

46523

ZONING PERMIT

7-3-90

SUBJECT TO APPROVAL BY:

- ☐ Lake County Sanitary Eng.
- ☒ Lake County Eng. Dept.
- ☐ Lake County Planning Comm.
- ☒ Lake County Bldg. Dept.

Don J. Moreno

1. SWALE TO PROPOSED YARD DRAIN.
2. Sump Pump to Proposed YARD DRAIN.

Grading Plan Approved
 as shown and/or noted
 THOMAS P. GILLES, P.E.
 Lake County Engineer
 Date 11/1/90

SOUTH CHARIOT STREET - 60

