

Richard T. Smith, Clerk COUNTY, OHIO

for: 20th Century Construction
853 Johnson Ave. NW
 ADDRESS CLIENT OWNER
STREET CITY ZIP

SOUTH HIGHLAND AVE S
 REVISION 10-78 NAME
 14 VOL - PG
 SOUTH HIGHLAND ST
 STREET
 LOT
 VOLUME
 PERM. PARCEL NO.
 TRACT
 PAGE
 STREET

[illegible]

ALL BOUNDARY DATA SHOWN WAS OBTAINED FROM (DEEDS, RECORDED
SUBDIVISION PLAT OR OTHER PUBLIC RECORDS)
LOCATIONS AS SHOWN OF ADJACENT WELLS AND SEPTIC TANKS OBTAINED FROM
LAKE COUNTY HEALTH DEPARTMENT

THIS PLAT WAS PREPARED BY ME, AND IS CORRECT TO THE BEST OF MY KNOWLEDGE AND BELIEF.

NAME	SURVEYOR	REGISTRATION	NO

[illegible]

REVISIONS			PLAN PREPARED BY:		
NO.	DATE	BY			
1			BABCOCK • JONES & ASSOCIATES, INC.		
2			PAINESVILLE, OHIO		
3			DRAWN BY	SCALE	PHONE NO.
4			CHECKED	DATE	DRAWING NO.
5			CREW CHIEF	APP'D.	


I, HEREBY CERTIFY THAT THE CIRCLED GRADES ARE EXISTING
FINISH GRADES CHECKED IN THE FIELD ON _____, 19____
AND ARE CORRECT TO THE BEST OF MY KNOWLEDGE AND BELIEF

REGISTERED SURVEYOR	REG. NO.

TBM - 2m Seal 194H.
ELEV. = 887.99

4-19-88

Toro & Mariani

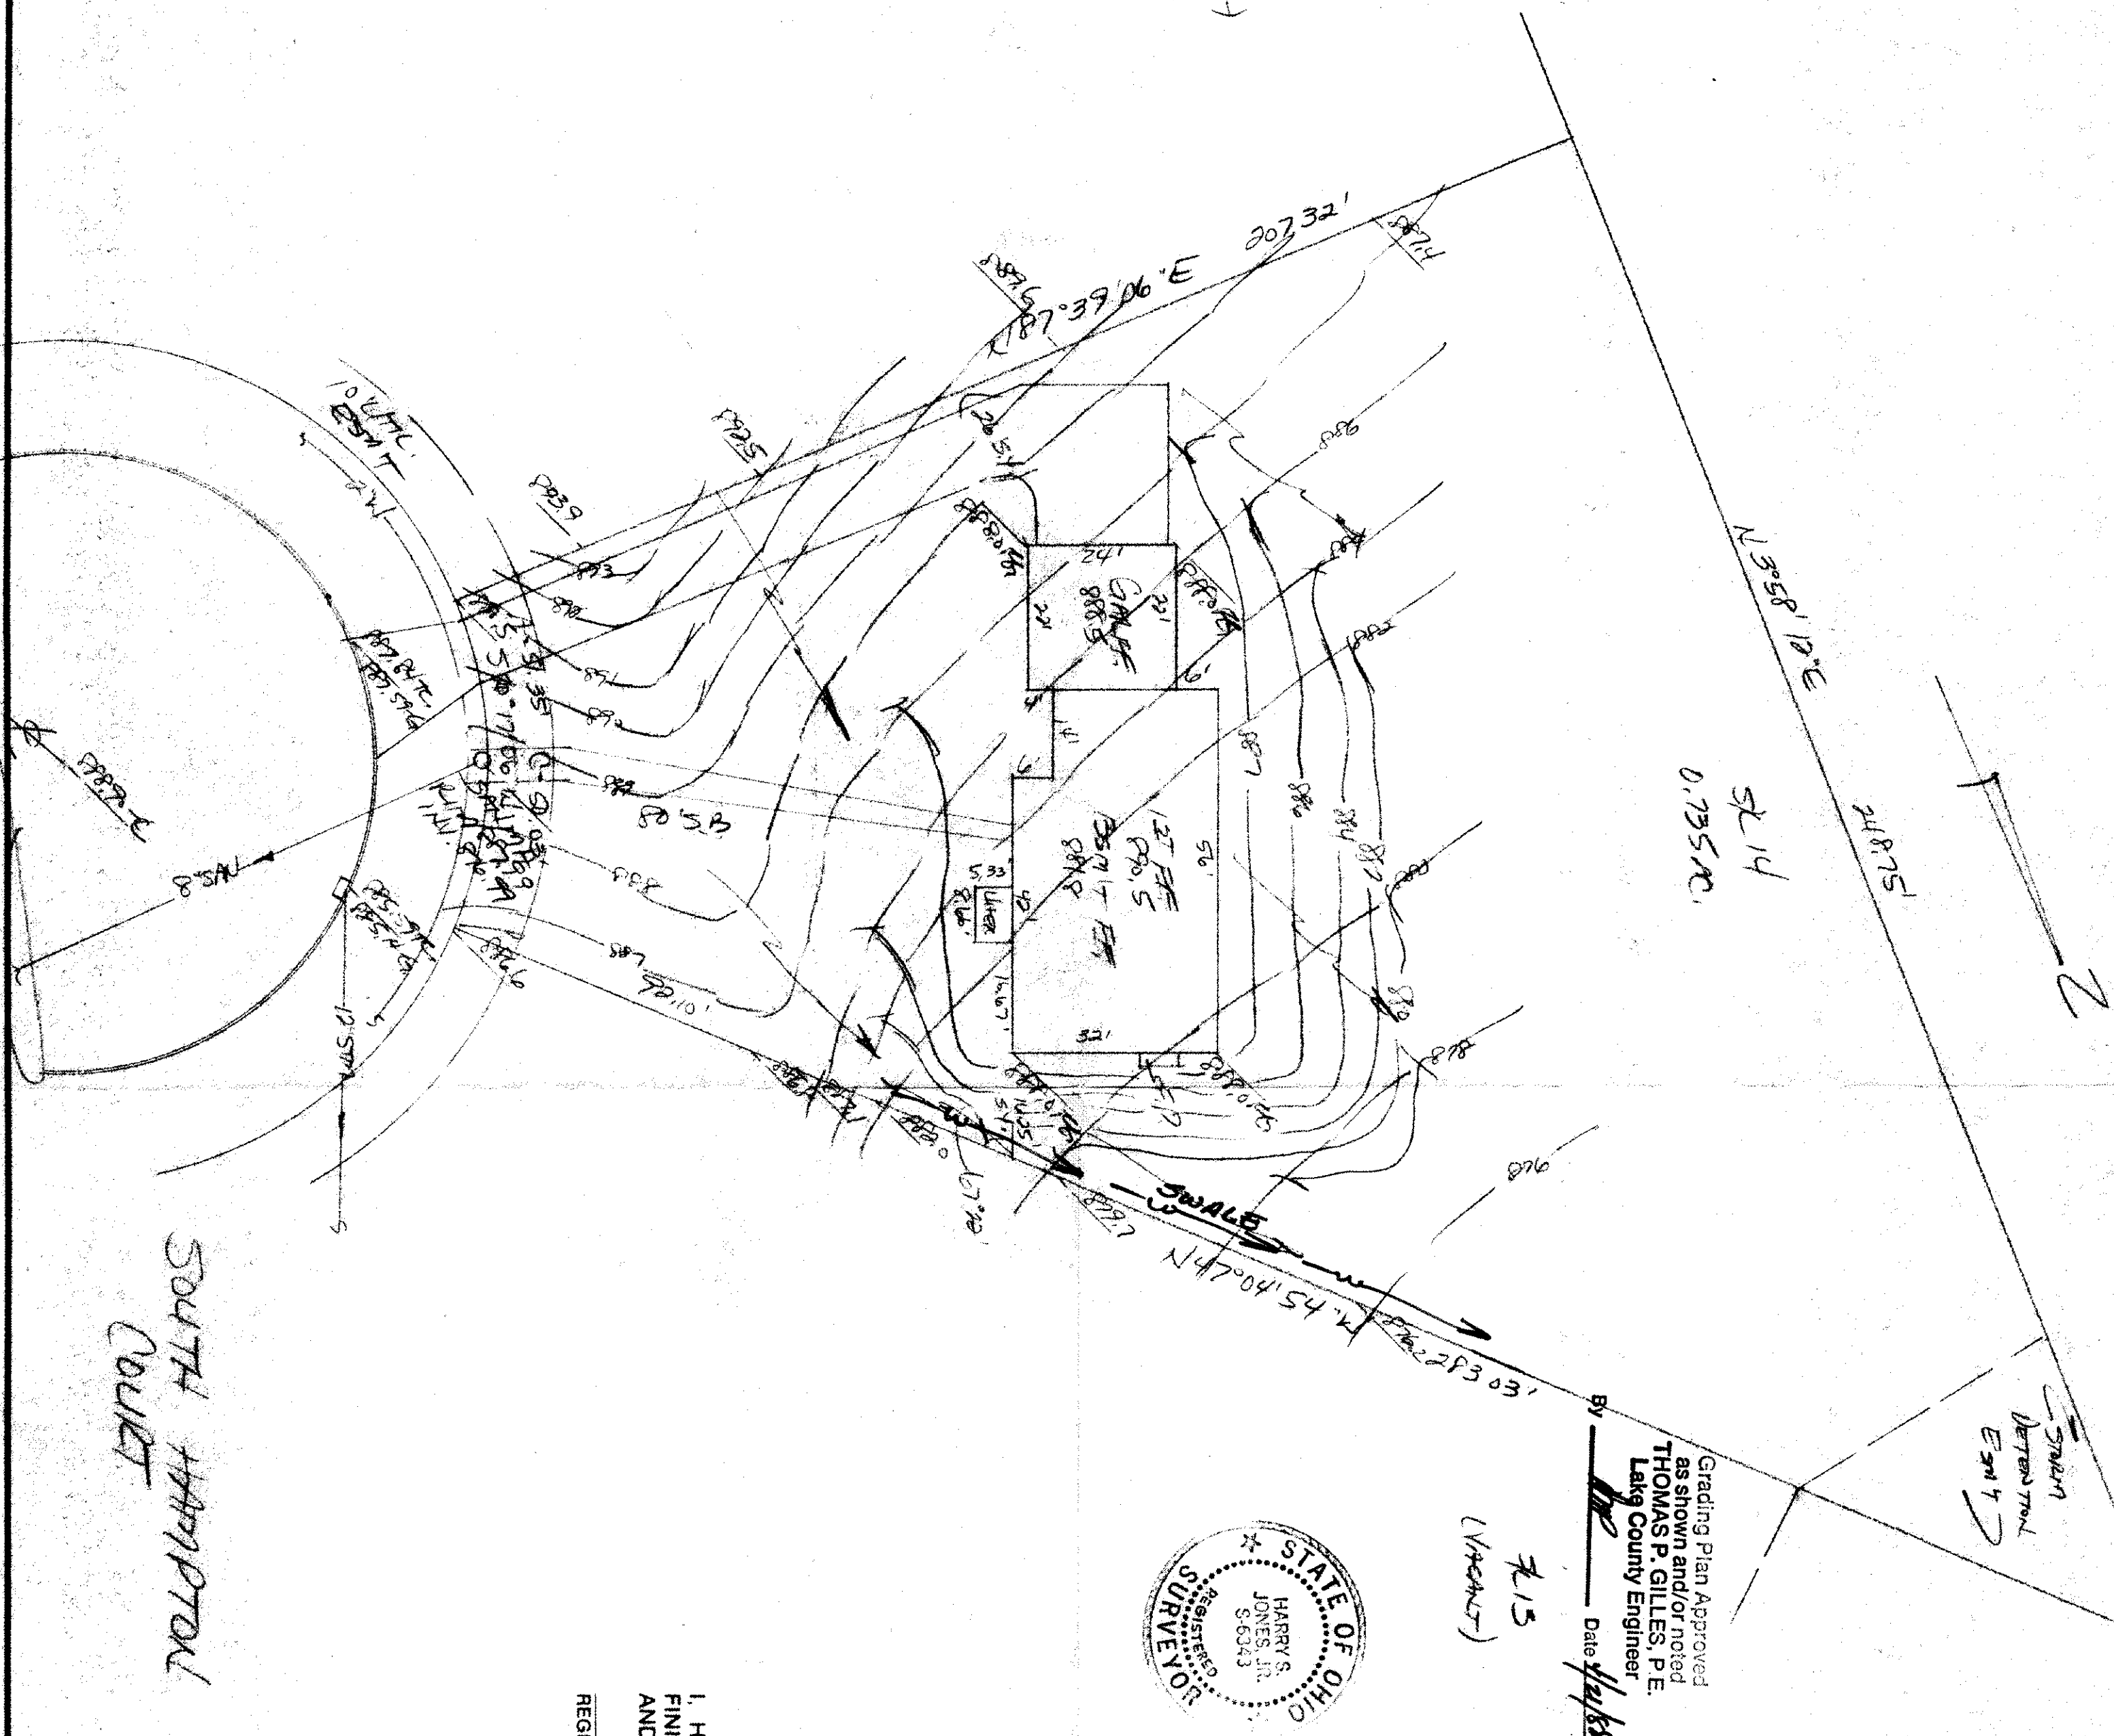

SK 14
0.735 AC

Grading Plan Approved
as shown and/or noted
THOMAS P. GILLES, P.E.
Lake County Engineer

7-15
Lynch

