

SITE PLAN

FOR THE

M.M. BOGART DEVELOPMENT CORP.
CONCORD TOWNSHIP
LAKE COUNTY, OHIO

"AS BUILT CERTIFICATION"

I hereby certify that the "as built" grades and other information provided are existing and checked in the field on 199 and are correct to the best of my knowledge and belief.


David K. Mostoller R.S. # 8949

"I, the undersigned hereby certify that this topography, indicated by 6", 1', or 2' contours, and elevations shown hereon represent an actual field survey made by me on the 24 day of May, 1990 and that the elevations were taken at appropriate intervals and that as of that date they existed as indicated hereon."

David K. Mostoller R.S. # 8949

LEGEND

- SANITARY MANHOLE
- STORM MANHOLE
- INLET OR CATCH BASIN
- HYDRANT
- EXISTING CONTOUR
- PROPOSED CONTOUR
- EAST. ELEV. $\rightarrow$ 100.0 $\leftarrow$ PROP. ELEV.
- AS BUILT ELEVATION
- DIRECTION OF DRAINAGE

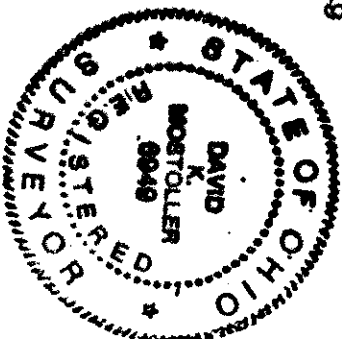

CURVE DATA

① RADIUS = 475.76'
ARC = 117.21'
DELTA = 14° 06' 58"
CHORD = 116.92'
CHORD BRG. = S 45° 56' 31" E

② RADIUS = 445.78'
ARC = 81.99'
DELTA = 10° 32' 19"
CHORD = 81.87'
CHORD BRG. = S 47° 43' 51" E

③ RADIUS =

ARC =

DELTA =

CHORD =

CHORD BRG. =

KNIGHTSBRIDGE SUBDIVISION VOL. 1, PAGE 52

N 35° 32' 39" W 129.90'

0.505 ACRES

S/L 37

S/L 36

N 51° 06' 58" E

S/L 38

CARRIAGE HILLS SUBDIVISION VOL. 13 PAGE 7

Grading Plan Approved

ISSUED 9-13-90

as shown and/or noted
THOMAS P. GILLES, P.E.
Lake County Engineer
Lake County Sanitary Eng.

By GJH
Date 9/17/90
Lake County Eng. Dept. ☒

Lake County Planning Comm. ☐

PREPARED BY:

John J. Macano

FISHER AND ASSOCIATES INC.

ENGINEERS AND CONSULTANTS

SCALE: 1" = 30'

DATE: AUGUST, 1990

