


52° 41' 41" E 114.24'

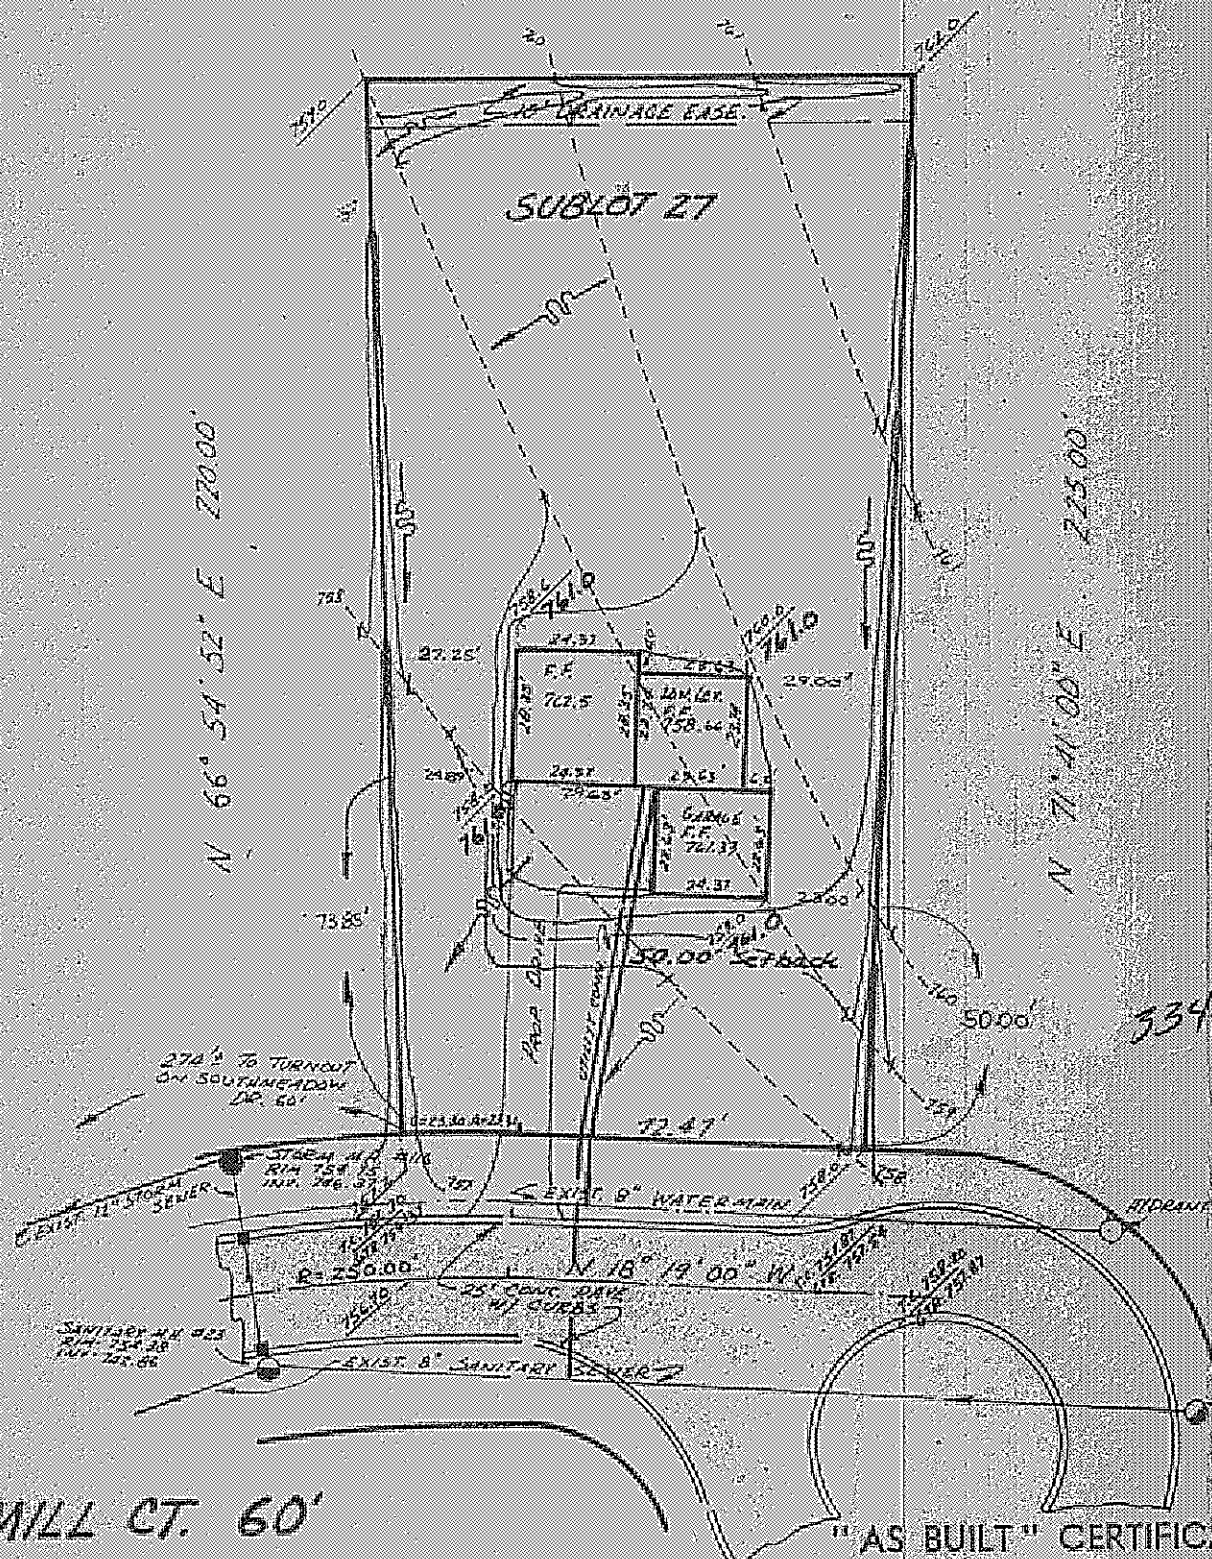

SAWMILL CT. 60'

"AS BUILT" CERTIFICATION

I, HEREBY CERTIFY THAT THE CIRCLED GRADES ARE EXISTING FINISH GRADES CHECKED IN FIELD ON 19 BY SURVEYING AND ARE CORRECT TO THE BEST OF MY KNOWLEDGE AND BELIEF.

REGISTERED SURVEYOR

REG. NO.

SITE PLAN

CONCORD

TOWNSHIP

LAKE COUNTY, OHIO

for: RYAN HOMES

CLIENT

OWNER

ADDRESS

STREET

CITY

ZIP

CONCORD HILLS SUB #1

SUBDIVISION

NAME

27

SUBLOT NO.

VOL. - PG.

SAWMILL CT.

STREET

LOT

TRACT

VOLUME

PAGE

PERM. PARCEL NO.

STREET

LEGEND

SANITARY MANHOLE

STORM MANHOLE

INLET OR CATCH BASIN

HYDRANT

EXISTING CONTOURS

PROPOSED CONTOURS

EXIST. ELEV.

100.0 PROP. ELEV.

WATER VALVE (GAS)

WATER METER (GAS)

AS BUILT ELEVATION

INDICATES

DIRECTION OF

SURFACE DRAINAGE

REMARKS

ALL BOUNDARY DATA SHOWN WAS OBTAINED FROM (DEEDS, RECORDED SUBDIVISION PLAT OR OTHER PUBLIC RECORDS).

LOCATIONS AS SHOWN OF ADJACENT WELLS AND SEPTIC TANKS OBTAINED FROM LAKE COUNTY HEALTH DEPARTMENT.

DESIGN CERTIFICATION

THIS PLAT WAS PREPARED BY ME, AND IS CORRECT TO THE BEST OF MY KNOWLEDGE AND BELIEF.

NAME

SURVEYOR

REGISTRATION NO.

CHECK LIST

NO. OF BEDROOMS
DIMENSIONS
BEARINGS
TIE TO NEAREST STREET
SUBLOT NO. PARCEL NO.
SURROUNDING OWNERS
BLDG. DIMENSIONS FIN. GR.
BLDG. TIES FLR. GRADES
APRON TYPE WIDTH THICKNESS
SIDEWALK TYPE WIDTH THICKNESS
CULVERT TYPE DIA. LENGTH
ROCK OUTCROPPINGS

WATER MAIN SIZE, LOCATION
SAN. SEWER SIZE % GR. LOC.
SAN. MH. CAST. ELEV. INV. ELEV.
SAN. CONN. SIZE, LOC. DEPTH
STORM SEWER SIZE % GR. LOC.
STORM MH. CAST. ELEV. INV. ELEV.
PAVT. TYPE GRADE CURBS
GAS LINE LOC. SIZE PRESSURE
SEPTIC TANK LOCATION & DUPLICATION AREA
WELL LOCATION
ISOLATION RADIUS FROM WELL

REVISIONS

NO.	DATE	BY
1		
2		
3		
4		
5		

PLAN PREPARED BY:

DEBEVEC-SALO & ASSOCIATES, INC.

130 EAST JACKSON ST.

PAINESVILLE, OHIO

DRAWN BY

SCALE

PHONE NO.

CHR'D.

DATE

DRAWING NO.

CREW CHIEF

APP'D.

4820-27