


NORTH 32° 23' 45" EAST 59.52'

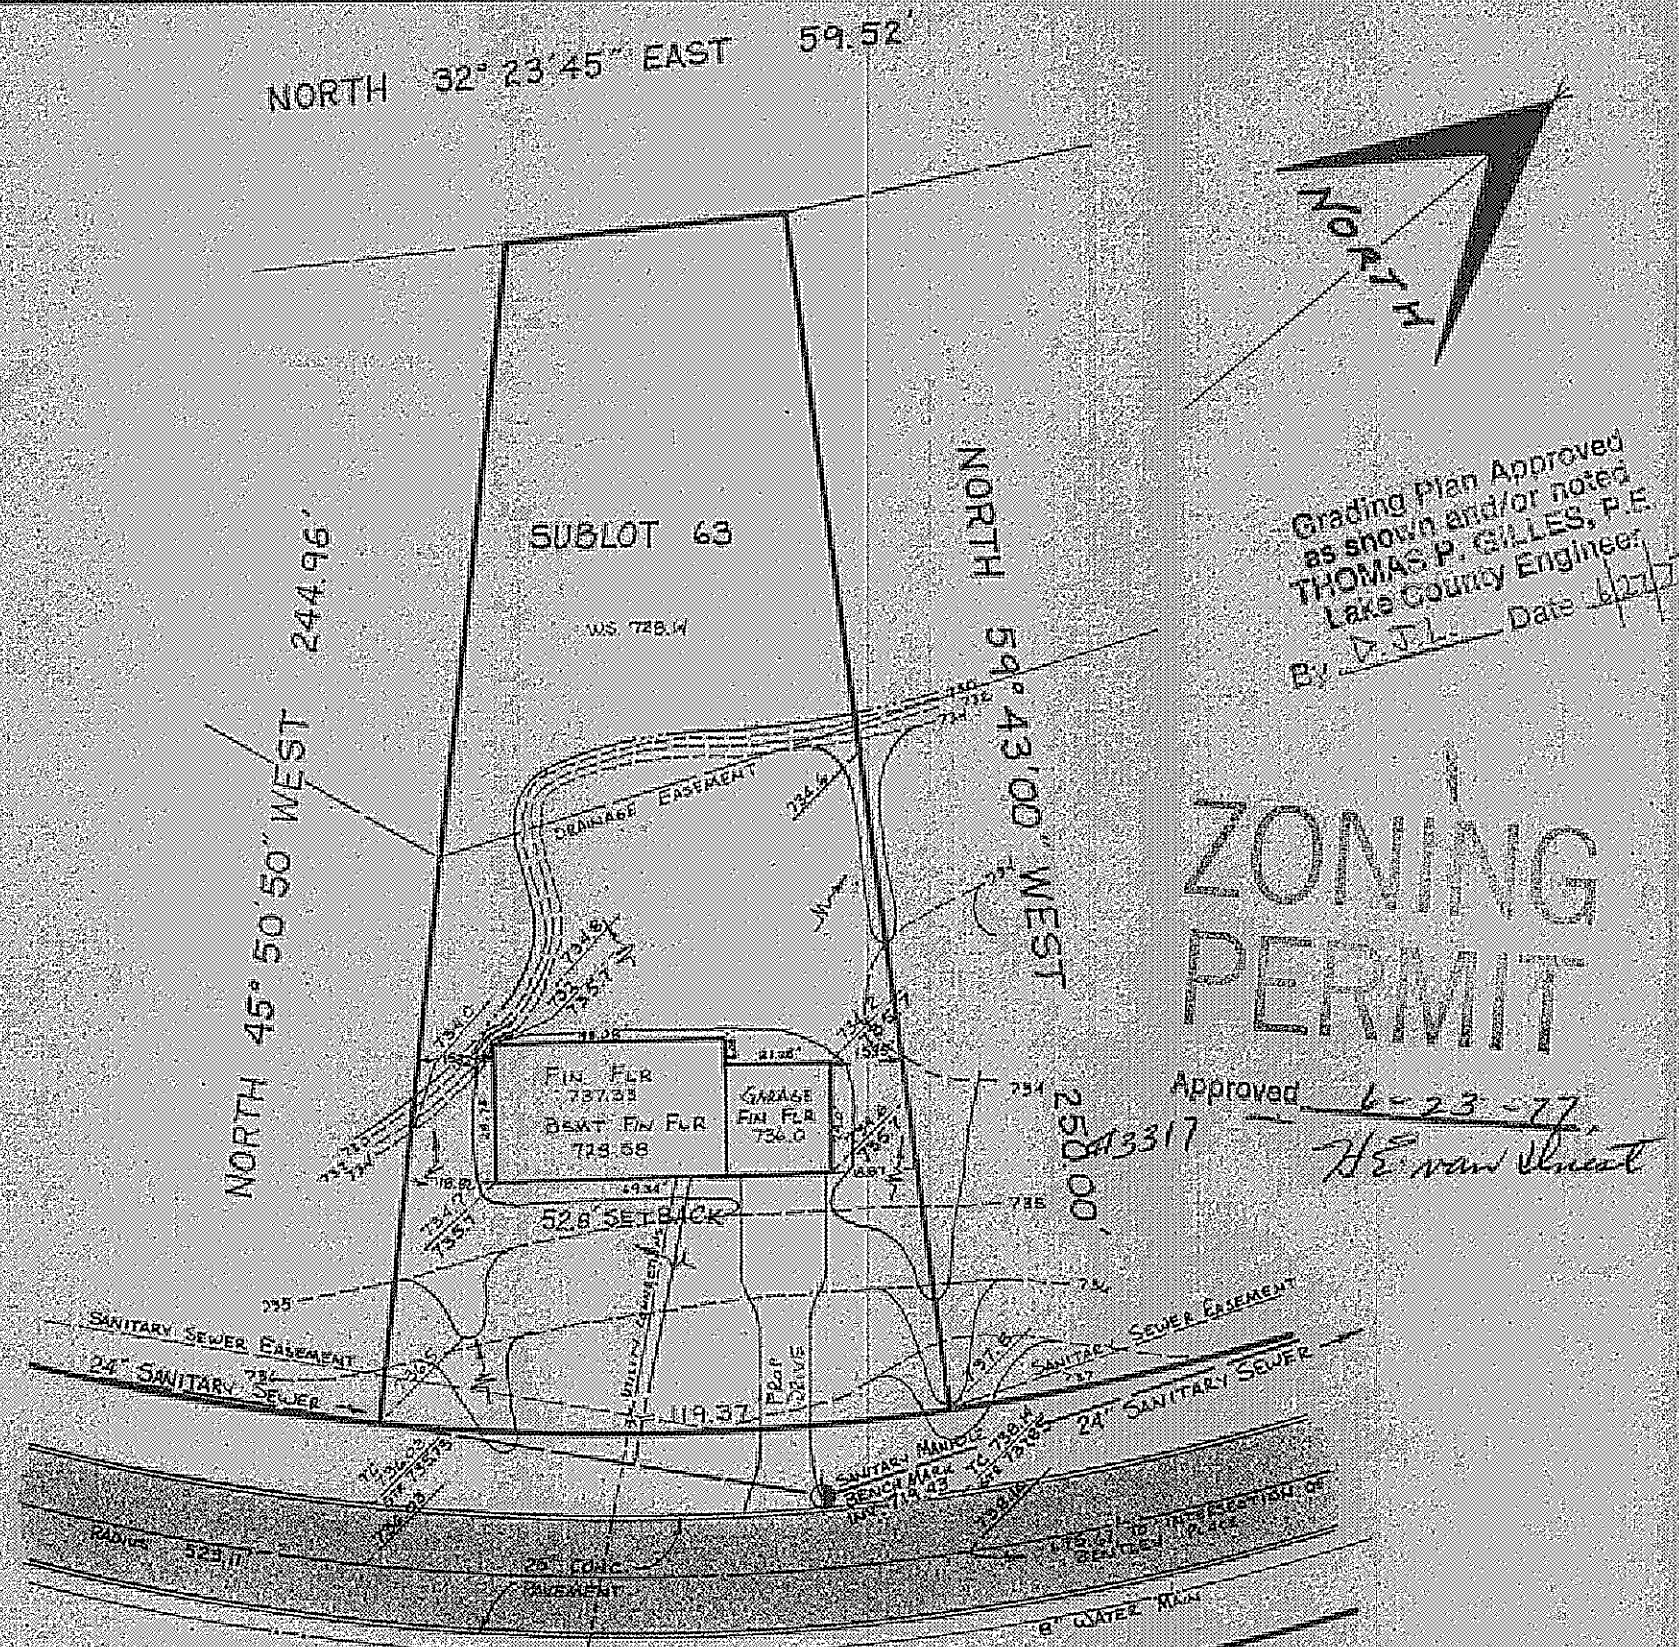

SOUTHMEADOW
DRIVE
60'

"AS BUILT" CERTIFICATION
I, HEREBY CERTIFY THAT THE CIRCLED GRADES ARE EXISTING FINISH
GRADES CHECKED IN FIELD ON 19 BY
SURVEYING AND ARE CORRECT TO THE BEST OF MY KNOWLEDGE AND BELIEF.

REGISTERED SURVEYOR

REG. NO.

SITE PLAN

CONCORD

LAKE COUNTY, OHIO

TOWNSHIP

for: **WALTERS BUILDERS**

CLIENT

OWNER

ADDRESS

STREET

CITY

ZIP

CONCORD HILLS

SUBDIVISION

NAME

63

VOL. - PG.

SUBLOT NO.

SOUTHMEADOW
STREET

LOT

TRACT

VOLUME

PAGE

PERM. PARCEL NO.

STREET

LEGEND

SANITARY MANHOLE

STORM MANHOLE

INLET OR CATCH BASIN

HYDRANT

EXISTING CONTOURS

PROPOSED CONTOURS

EXIST. ELEV.

100.0 PROP. ELEV.

WATER VALVE (GAS)

WATER METER (GAS)

AS BUILT ELEVATION

INDICATES
DIRECTION OF
SURFACE DRAINAGE

REMARKS

ALL BOUNDARY DATA SHOWN WAS OBTAINED FROM (DEEDS, RECORDED
SUBDIVISION PLAT OR OTHER PUBLIC RECORDS)

LOCATIONS AS SHOWN OF ADJACENT WELLS AND SEPTIC TANKS OBTAINED FROM
LAKE COUNTY HEALTH DEPARTMENT

DESIGN CERTIFICATION

THIS PLAT WAS PREPARED BY ME, AND IS CORRECT
TO THE BEST OF MY KNOWLEDGE AND BELIEF.

NAME

SURVEYOR

REGISTRATION NO.

CHECK LIST

NO. OF BEDROOMS

DIMENSIONS

BEARINGS

TIE TO NEAREST STREET

SUBLOT NO. PARCEL NO.

SURROUNDING OWNERS

BLDG. DIMENSIONS FIN. GR.

BLDG. TIES FL'T. GRADES

APRON TYPE WIDTH THICKNESS

SIDEWALK TYPE WIDTH THICKNESS

CULVERT TYPE DIA. LENGTH

ROCK OUTCROPPINGS

WATER MAIN SIZE, LOCATION

SAN. SEWER SIZE % GR. LOC.

SAN. MH. CAST ELEV. INV. ELEV.

SAN. CONN. SIZE, LOC. DEPTH

STORM SEWER SIZE % GR. LOC.

STORM MH. CAST ELEV. INV. ELEV.

PAV'T TYPE GRADE CURBS

GAS LINE LOC. SIZE PRESSURE

SEPTIC TANK LOCATION & DUPLICATION AREA

WELL LOCATION

ISOLATION RADIUS FROM WELL

REVISIONS

NO.	DATE	BY
1		
2		
3		
4		
5		

PLAN PREPARED BY:

DEBEVEC - SALO & ASSOCIATES, INC.

130 EAST JACKSON ST.

PAINESVILLE, OHIO

DRAWN BY
JOCIV

SCALE
1" = 40'

PHONE NO.
352 9250

CHK'D.

DATE
6-10-77

DRAWING NO.

CREW
CHIEF

APP'D.

4320-64