


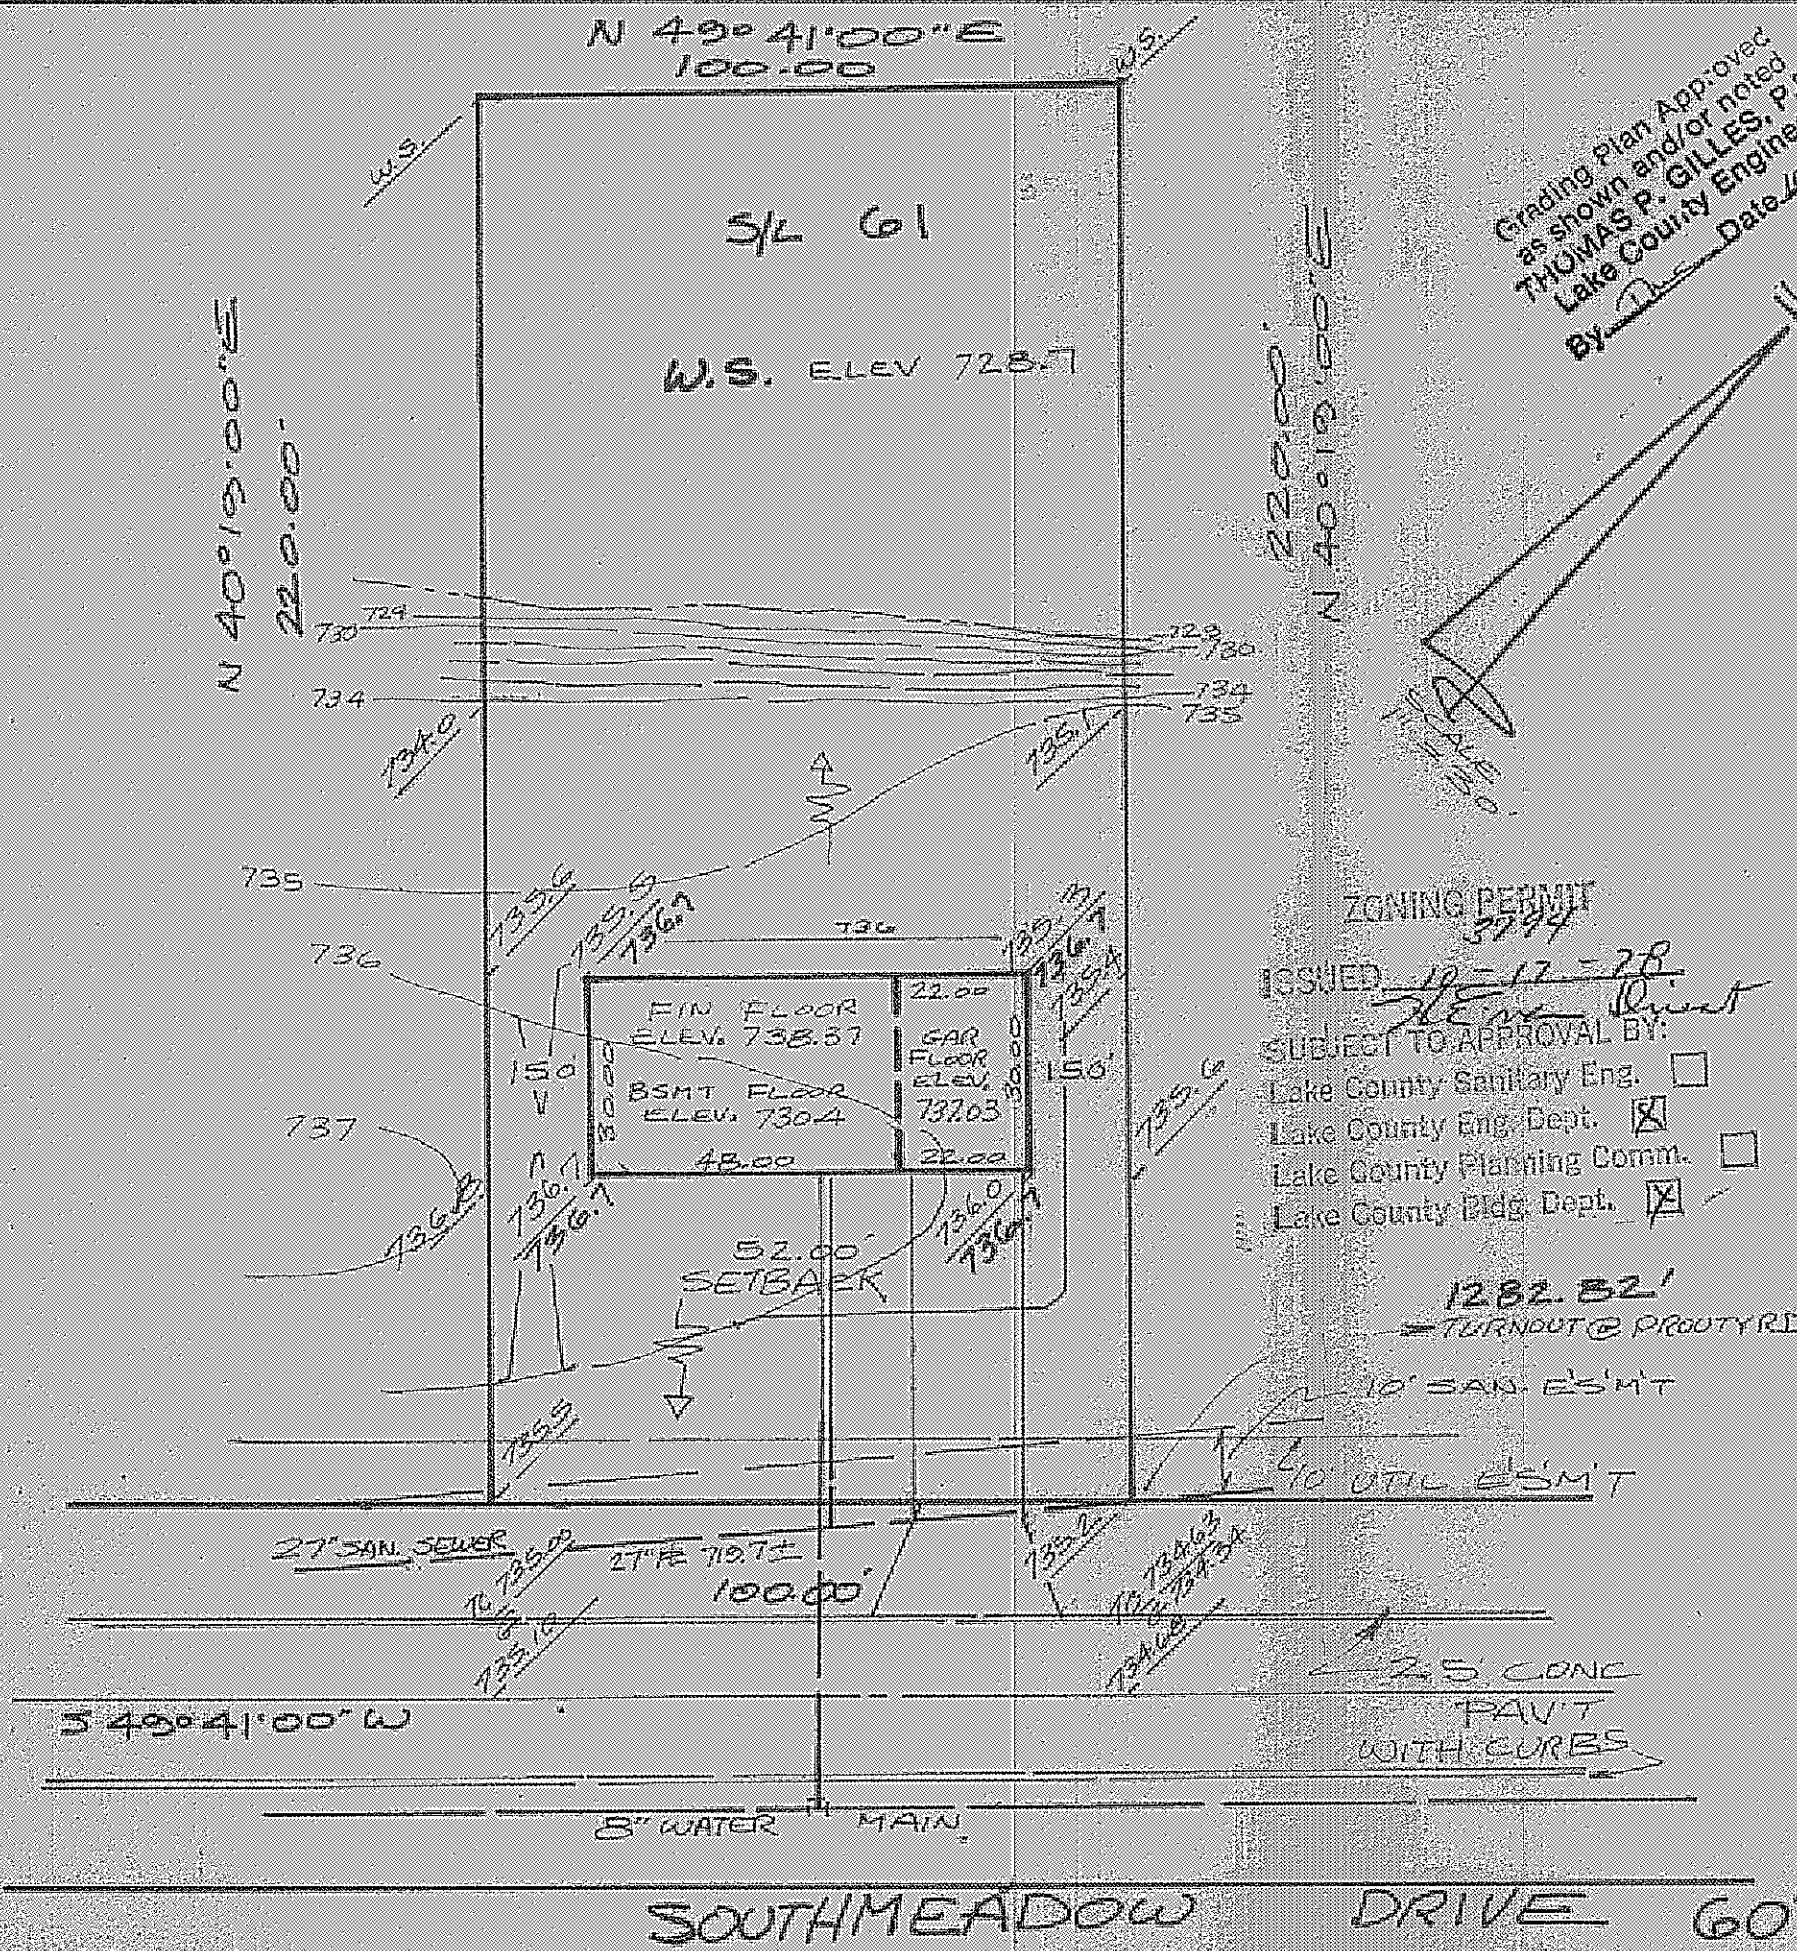

SITE PLAN

for **RALPH VICTOR**

CLIENT: **10145 HOOSE RD, MENTOR, OHIO**
 ADDRESS: **10145 HOOSE RD** STREET: **MENTOR** CITY: **OHIO**

SUBLOT NO. **61** SUBDIVISION NAME **CONCORD HILLS NO. 1** VOL. **V-37** PAGE **1**
 LOT, TRACT **CONCORD TOWNSHIP, OHIO**

REMARKS

ALL BOUNDARY DATA SHOWN WAS OBTAINED FROM (DEEDS, RECORDED SUBDIVISION PLAT OR OTHER PUBLIC RECORDS). LOCATIONS AS SHOWN OF ADJACENT WELLS AND SEPTIC TANKS OBTAINED FROM LAKE COUNTY HEALTH DEPARTMENT.

LEGEND

SANITARY MANHOLE — — — WATER VALVE (GAS) — — —
 PROPOSED CONTOURS — — — DIRECTION OF SURFACE DRAINAGE — — —
 EXIST. ELEV. — 100.0 100.0 — PROP. ELEV.

CHECK LIST


NO. OF BEDROOMS	WATER MAIN SIZE, LOCATION
DIMENSIONS	SAN. SEWER SIZE % GR. LOC.
BEARINGS	SAN. MH. CAST. ELEV. IN. ELEV.
TIE TO NEAREST STREET	SAN. CONN. SIZE, LOC. DEPTH
SUBLOT NO. PARCEL NO.	STORM SEWER SIZE % GR. LOC.
SURROUNDING OWNERS	STORM MH. CAST. ELEV. INV. ELEV.
BLDG. DIMENSIONS FIN. GR.	PAVT. TYPE GRADE CURBS
BLDG. TIES FLR. GRADES	GAS LINE LOC. SIZE PRESSURE
APRON TYPE WIDTH THICKNESS	SEPTIC TANK LOCATION & DUPPLICATION AREA
SIDEWALK TYPE WIDTH THICKNESS	WELL LOCATION
CULVERT TYPE DIA. LENGTH	ISOLATION RADIUS FROM WELL
ROCK OUTCROPPINGS	

DESIGN CERTIFICATION

THIS PLAT WAS PREPARED BY ME, AND IS CORRECT TO THE BEST OF MY KNOWLEDGE AND BELIEF. **PS # 5244**
 NAME: **Ralph Victor** SURVEYOR REGISTRATION NO. **PS # 5244**

"AS-BUILT" CERTIFICATION

I HEREBY CERTIFY THAT THE CIRCLED GRADES ARE EXISTING GRADES OBTAINED ON THE SITE ON **19** AND ARE CORRECT TO THE BEST OF MY ACKNOWLEDGMENT AND BELIEF.

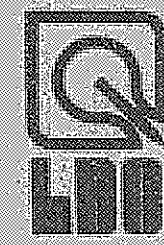

LAND DESIGN consultants, inc.
 9613 JACKSON STREET, MENTOR, OHIO 44060
 TELEPHONE (216) 951-6872 or 354-6646

1	DRAWN BY RJB	SCALE 1"=30'	DRAWING NO.
2	CHK'D. RJB	DATE 9.27.78	180-61
3	CREW CHIEF RWB	APP'D.	