


MICHAEL C. HASELOW
 Vol. 781 Pg. 318
 N. 0° 33' 30" W. 559.30'

SPEAR

ROAD 60'

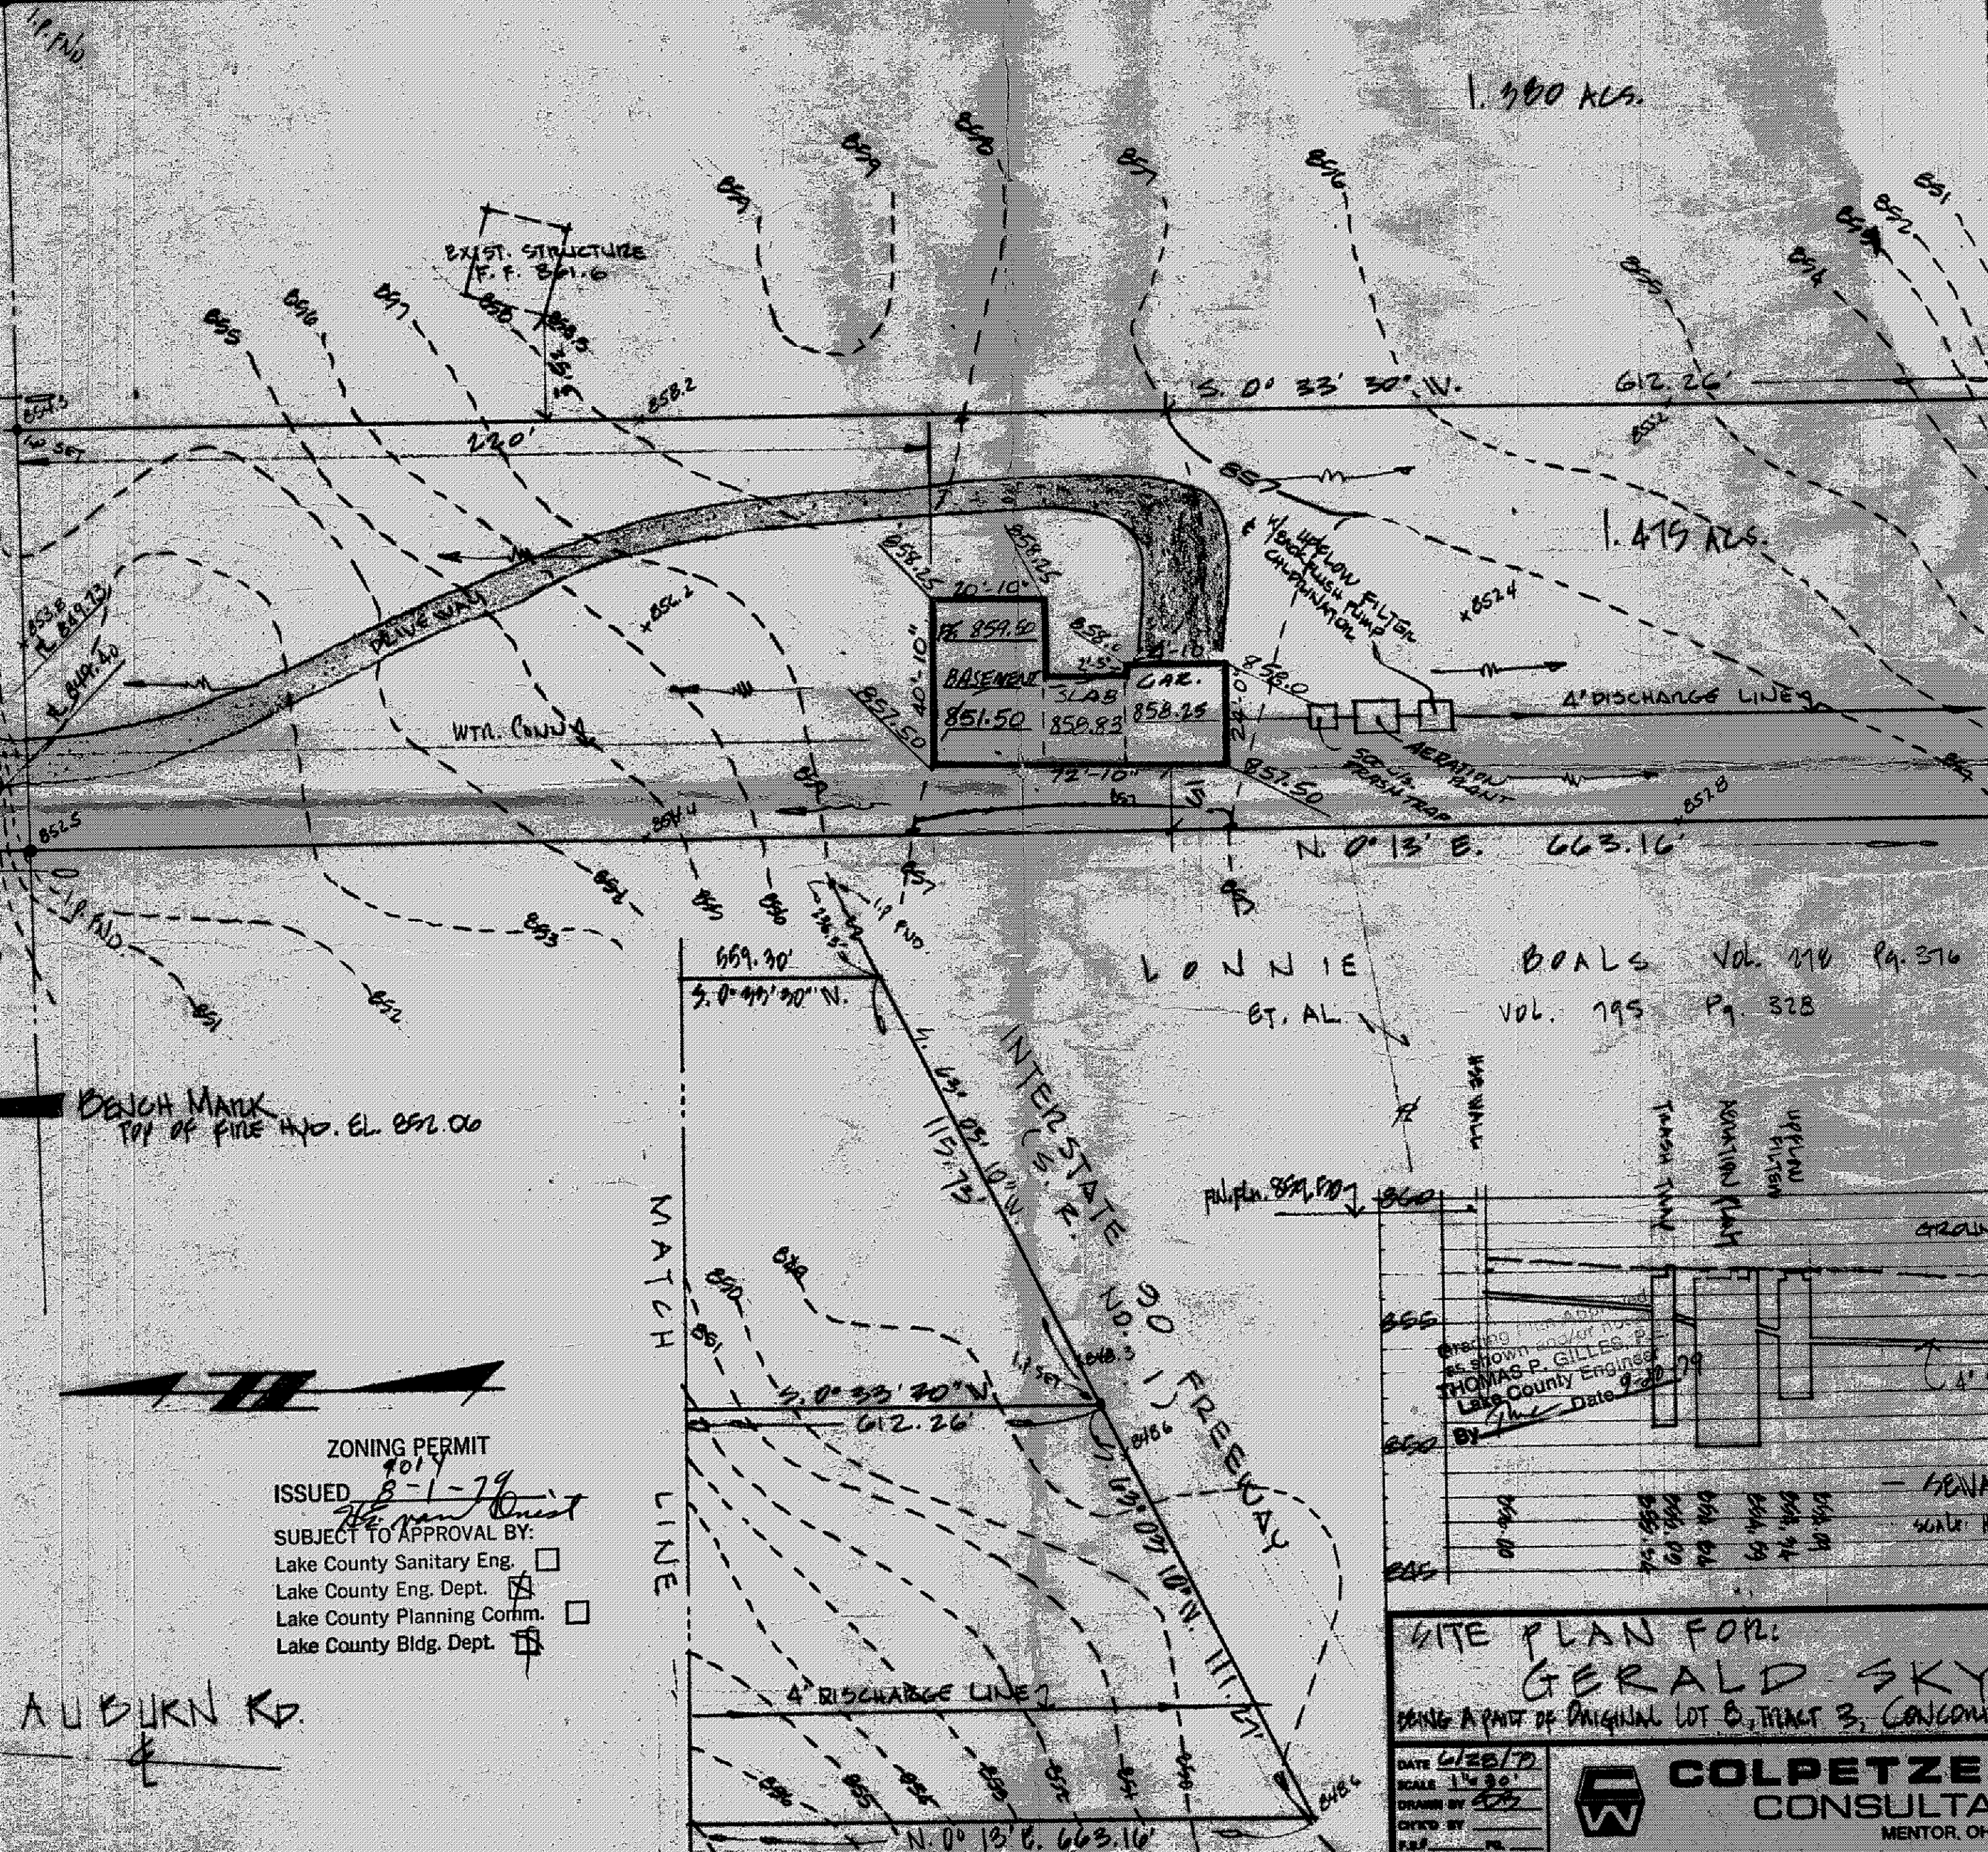


MATCH LINE

GRADING DESIGN CERTIFICATION
 THIS PLAN WAS PREPARED BY ME AND IS CORRECT TO THE BEST OF MY KNOWLEDGE.
 BY *Elmer J. Jankovic* P.S. #49

AS BUILT CERTIFICATION
 I HEREBY CERTIFY THAT THE CHANGING GRADES AND EXISTING FINISH GRADES CHECKED IN THE FIELD ON AND THAT SURVEY IS CORRECT TO THE BEST OF MY KNOWLEDGE AND BELIEF.
 BY *Elmer J. Jankovic* P.S. #49

ZONING PERMIT
 ISSUED 8-1-79
 SUBJECT TO APPROVAL BY:
 Lake County Sanitary Eng. ☐
 Lake County Eng. Dept. ☒
 Lake County Planning Comm. ☐
 Lake County Bldg. Dept. ☒

AUBURN RD.

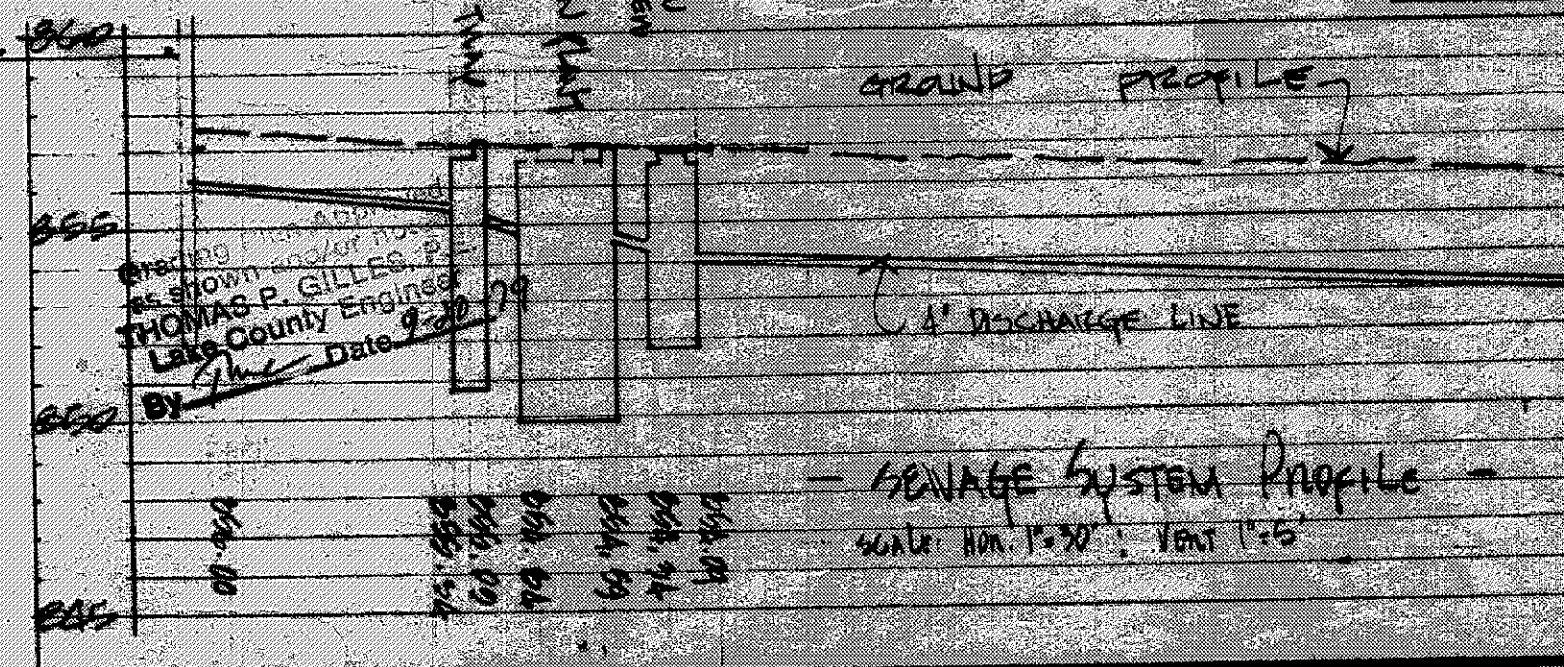

SITE PLAN FOR:
GERALD SKYTJA
 BEING A PART OF ORIGINAL LOT 8, TRACT 3, CONCORD TOWNSHIP, LAKE COUNTY, OHIO.
 DATE 6/25/79
 SCALE 1" = 30'
 DRAWN BY *THOMAS P. GILLES*
 CHECKED BY *THOMAS P. GILLES*
 DATE 8-20-79
COLPETZER WOODS CONSULTANTS, INC.
 MENTOR, OHIO 44060