
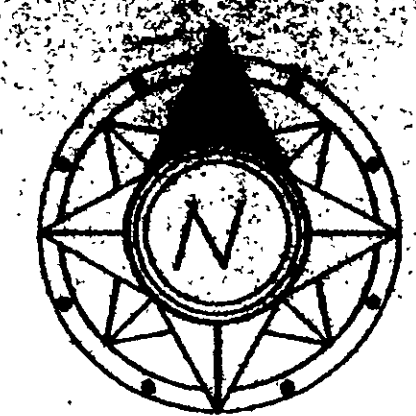


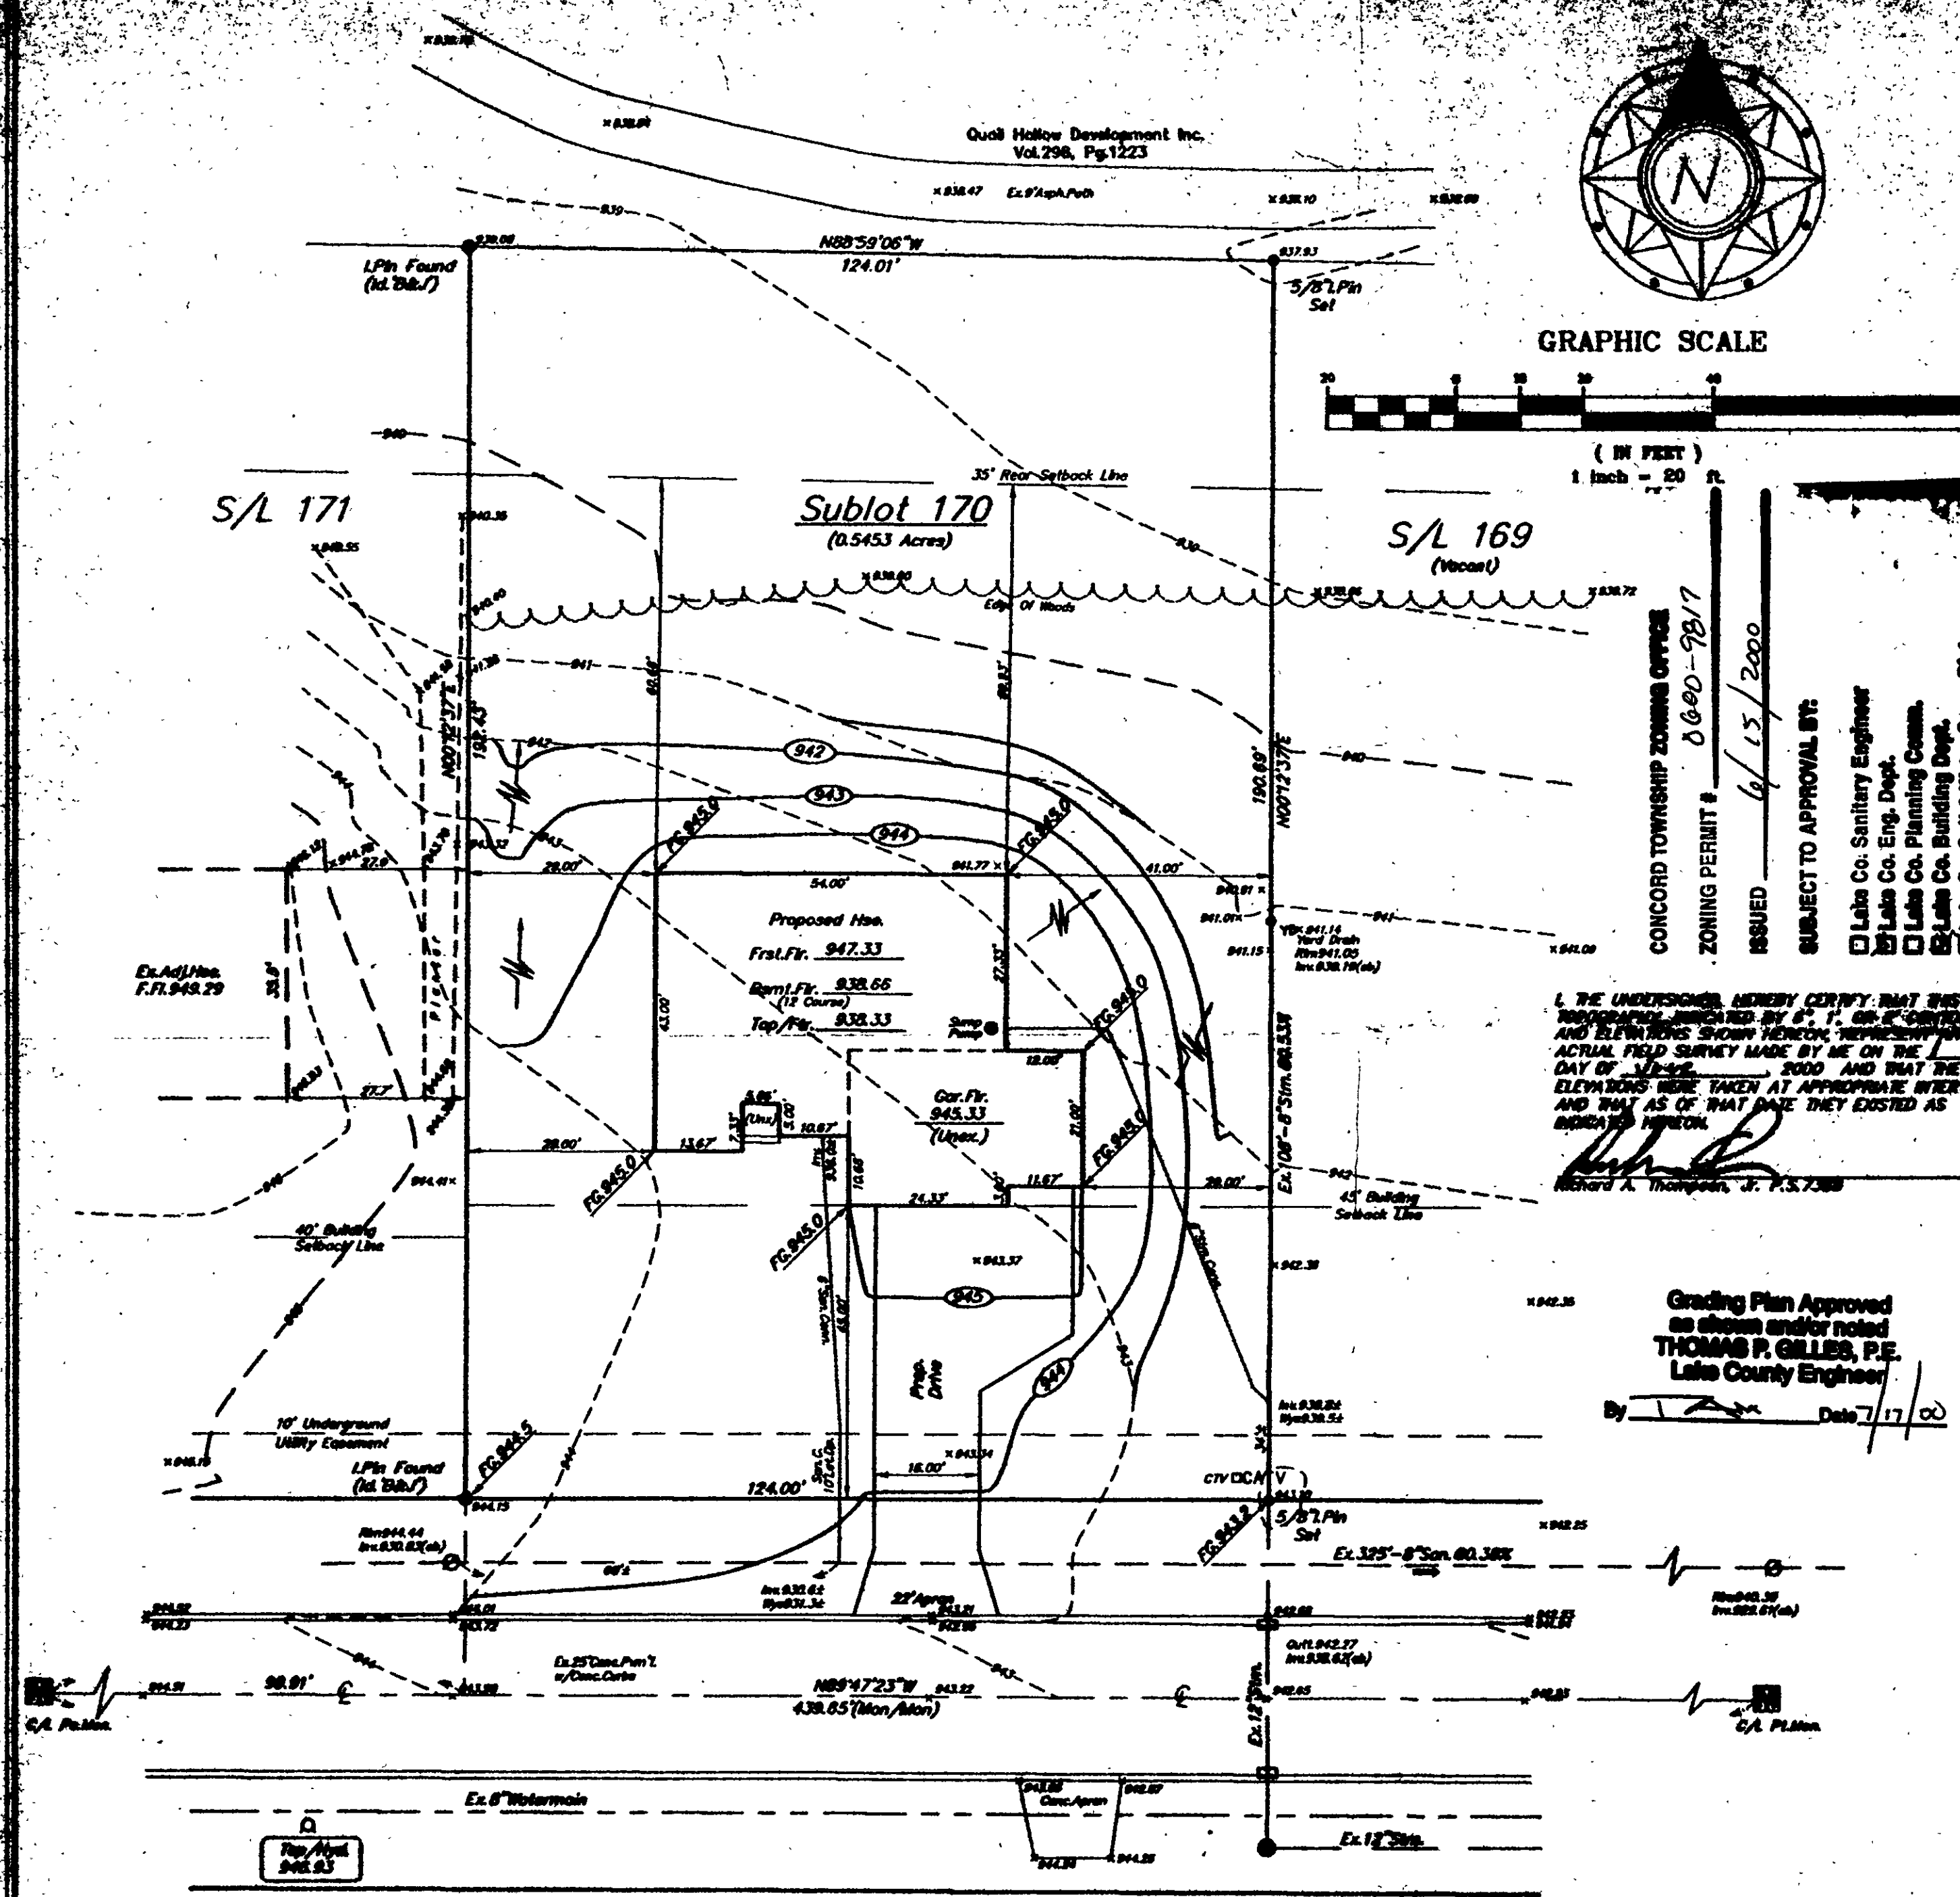

CONCORD TOWNSHIP ZONING OFFICE
 ZONING PERMIT # 060-7817
 ISSUED 6/15/2000
 SUBJECT TO APPROVAL BY:
☐ Lake Co. Sanitary Engineer
☐ Lake Co. Eng. Dept.
☐ Lake Co. Planning Comm.
☐ Lake Co. Building Dept.
☐ Lake Co. Soil & Water Cons. Div.

I, THE UNDERSIGNED, HEREBY CERTIFY THAT THE INFORMATION FURNISHED BY ME, IN CONNECTION WITH THIS ACTUAL FIELD SURVEY MADE BY ME ON THE DAY OF 12-22-2000 AND THAT THE ELEVATIONS WERE TAKEN AT APPROPRIATE INTERVALS AND THAT AS OF THAT DATE THEY EXISTED AS SHOWN HEREON.
 Richard A. Thompson, Jr. P.E. 7-988

Grading Plan Approved
 as shown and/or noted
 THOMAS P. GILLES, P.E.
 Lake County Engineer
 By Date 7/17/00

Saddlewood Lane 60'

2 WORKING DAYS
 BEFORE YOU DIG
 CALL TOLL FREE 800-362-2764
 Ohio Utilities Protection Service

EXISTING UNDERGROUND UTILITIES NOTE:
 THE USE OF CATALOG, BORE HOLE, AND SURFACE
 OF THE UNDERGROUND UTILITIES SHOWN HEREON HAVE BEEN
 OBTAINED BY A REVIEW OF AVAILABLE RECORDS.
 VERIFICATION BY FIELD INVESTIGATION AND/OR EXCAVATION
 SHOULD BE CONSIDERED PRIOR TO ANY CONSTRUCTION.
 CONSTRUCTION OF ANY UNDERGROUND UTILITY SHALL BE
 IN ACCORDANCE WITH THE OHIO PUBLIC UTILITIES CODE.

for : Quail Hollow Development Inc.
5900 S.O.M. CHURCH
 ADDRESS

SUBLOT No. 170 Quail Hollow
 LOT 3 TRACT 2 TOWNSHIP Concord

LAND DESIGN CONSULTANTS
 One Engineer and Surveyor
 200 West 1st St., Suite 200
 Concord, Ohio 43081-1200
 Phone: 740-362-2764 Fax: 740-362-2765

DESIGN CERTIFICATION
 THIS PLAN WAS PREPARED BY ME AND TO THE BEST OF MY KNOWLEDGE AND BELIEF
Richard A. Thompson, Jr.
 NAME

CHECK LIST
 I HAVE REVIEWED AND APPROVED THE FOLLOWING:
☐ THE PLAN AND SPECIFICATIONS
☐ THE SURVEY DATA
☐ THE CALCULATIONS
☐ THE LEGEND
☐ THE BENCHMARK
☐ THE ELEVATIONS
☐ THE SETBACKS
☐ THE EASEMENTS
☐ THE UTILITIES
☐ THE PROPOSED CONSTRUCTION
☐ THE EXISTING CONDITIONS
☐ THE ADJACENT PROPERTIES
☐ THE TOWNSHIP RECORDS
☐ THE STATE RECORDS
☐ THE FEDERAL RECORDS
☐ THE LOCAL RECORDS
☐ THE PRIVATE RECORDS
☐ THE PUBLIC RECORDS
☐ THE OTHER RECORDS

"AS BUILT" CERTIFICATION
 I HEREBY CERTIFY THAT THE CONCORD TOWNSHIP ZONING OFFICE HAS REVIEWED AND APPROVED THIS PLAN AND THAT THE SAME IS IN ACCORDANCE WITH THE ZONING ORDINANCES AND REGULATIONS OF THE TOWNSHIP OF CONCORD, OHIO, AND IS CORRECT TO THE BEST OF MY KNOWLEDGE AND BELIEF.
 NAME _____

LEGEND
 DASHED LINE WITH CIRCLES
 EXIST. ELEV. 100.0
 F.G. 100.0 - PROP. ELEV.
 DOTTED LINE
 DIRECTION OF SURFACE DRAINAGE
 ACCEPTED _____

BENCHMARK BM-1 R.M. 3rd Ch Top of Hill
 Located Opposite Ad. 1st St.
 Elev. 100.00