

for	M.M. BOGART HOMES	
862	STATION STREET	MENTHO
APR 1955	STREET	015
175	QUAIL HOLLOW	
SUBLOT NO.	SUBTRACTOR NAME	VOL. "Pa
	Concess	01510
LOT TRACT	CITY	

Civil Engineers and Surveyors
2257 E. Washington St. Tel (408) 545-0000
Chaparral Falls, Ohio 44025 Fax (408) 545-0000

[illegible]

THIS PLAT WAS PREPARED BY ME AND IS CORRECT TO THE BEST OF MY KNOWLEDGE.

AS-OBTAINED INFORMATION
I HEREBY CERTIFY THAT THE ABOVE INFORMATION IS TRUE AND
AS OBTAINED ON THE DATE 10 10 68
CORRECT TO THE BEST OF MY KNOWLEDGE AND BELIEF

STORM MANHOLE 0
SANITARY MANHOLE 28
EXISTING CONTOURS --- 108
PROPOSED CONTOURS --- 100
EXIST. ELEV. 100.0
100.0 PROP. ELEV.
DIRECTION OF SURFACE DRAINAGE -

BENCHMARK: "LL" 1st Milestone on Highway 4 E. 12. 1977
Elev: 746.20

SADDLEWOOD LANE (D.R.)


$\Delta = 50^{\circ}55'01''$
 $R = 60.00'$
 $T = 28.57'$
 $L = 53.32'$
 $C = 51.58'$
 $N 08^{\circ}48'07'' W$

* DRIVE APRON SHALL BE
6" THICK CONCRETE.

**2. WORKING DAYS BEFORE YOU DIG
CALL TOLL FREE 800-362-2764
OHIO UTILITIES PROTECTION SERVICE**

CONTRACTOR SHALL VERIFY ELEVATIONS
OF LATERAL INVERTS IN THE FIELD AT
THE TIME OF FOUNDATION EXCAVATION.

GRAPHIC SCALE

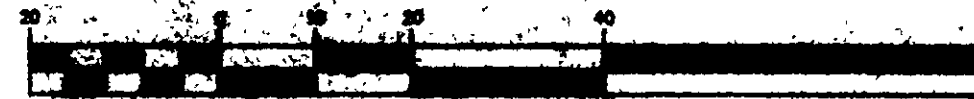

(IN FEET)
1 inch = 20 ft.

Grading Plan Approved
as shown and noted
THOMAS P. GILLES, P.E.
Los Angeles County Engineer

By TAM Date 7/25/00
Lower Flg. as noted

CONCORD TOWNSHIP ZONING OFFICE
0900-99

CONCORD TOWNSHIP ZONING OFFICE
ZONING PERMIT # 0900-9943
9/21/2000

ZONING PERMIT # 9/21/2000
ISSUED

SUBJECT TO APPROVAL BY:

- SUBJECT:
- ☐ Lake Co. Sanitary Engineer
 - ☒ Lake Co. Eng. Dept.
 - ☐ Lake Co. Planning Comm.
 - ☒ Lake Co. Building Dept.
 - ☒ Lake Co. Soil & Water Cons. Dist.

