

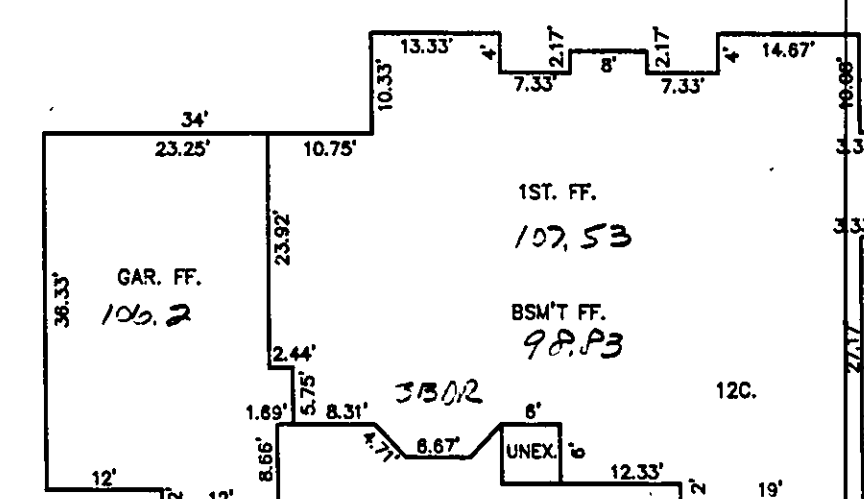
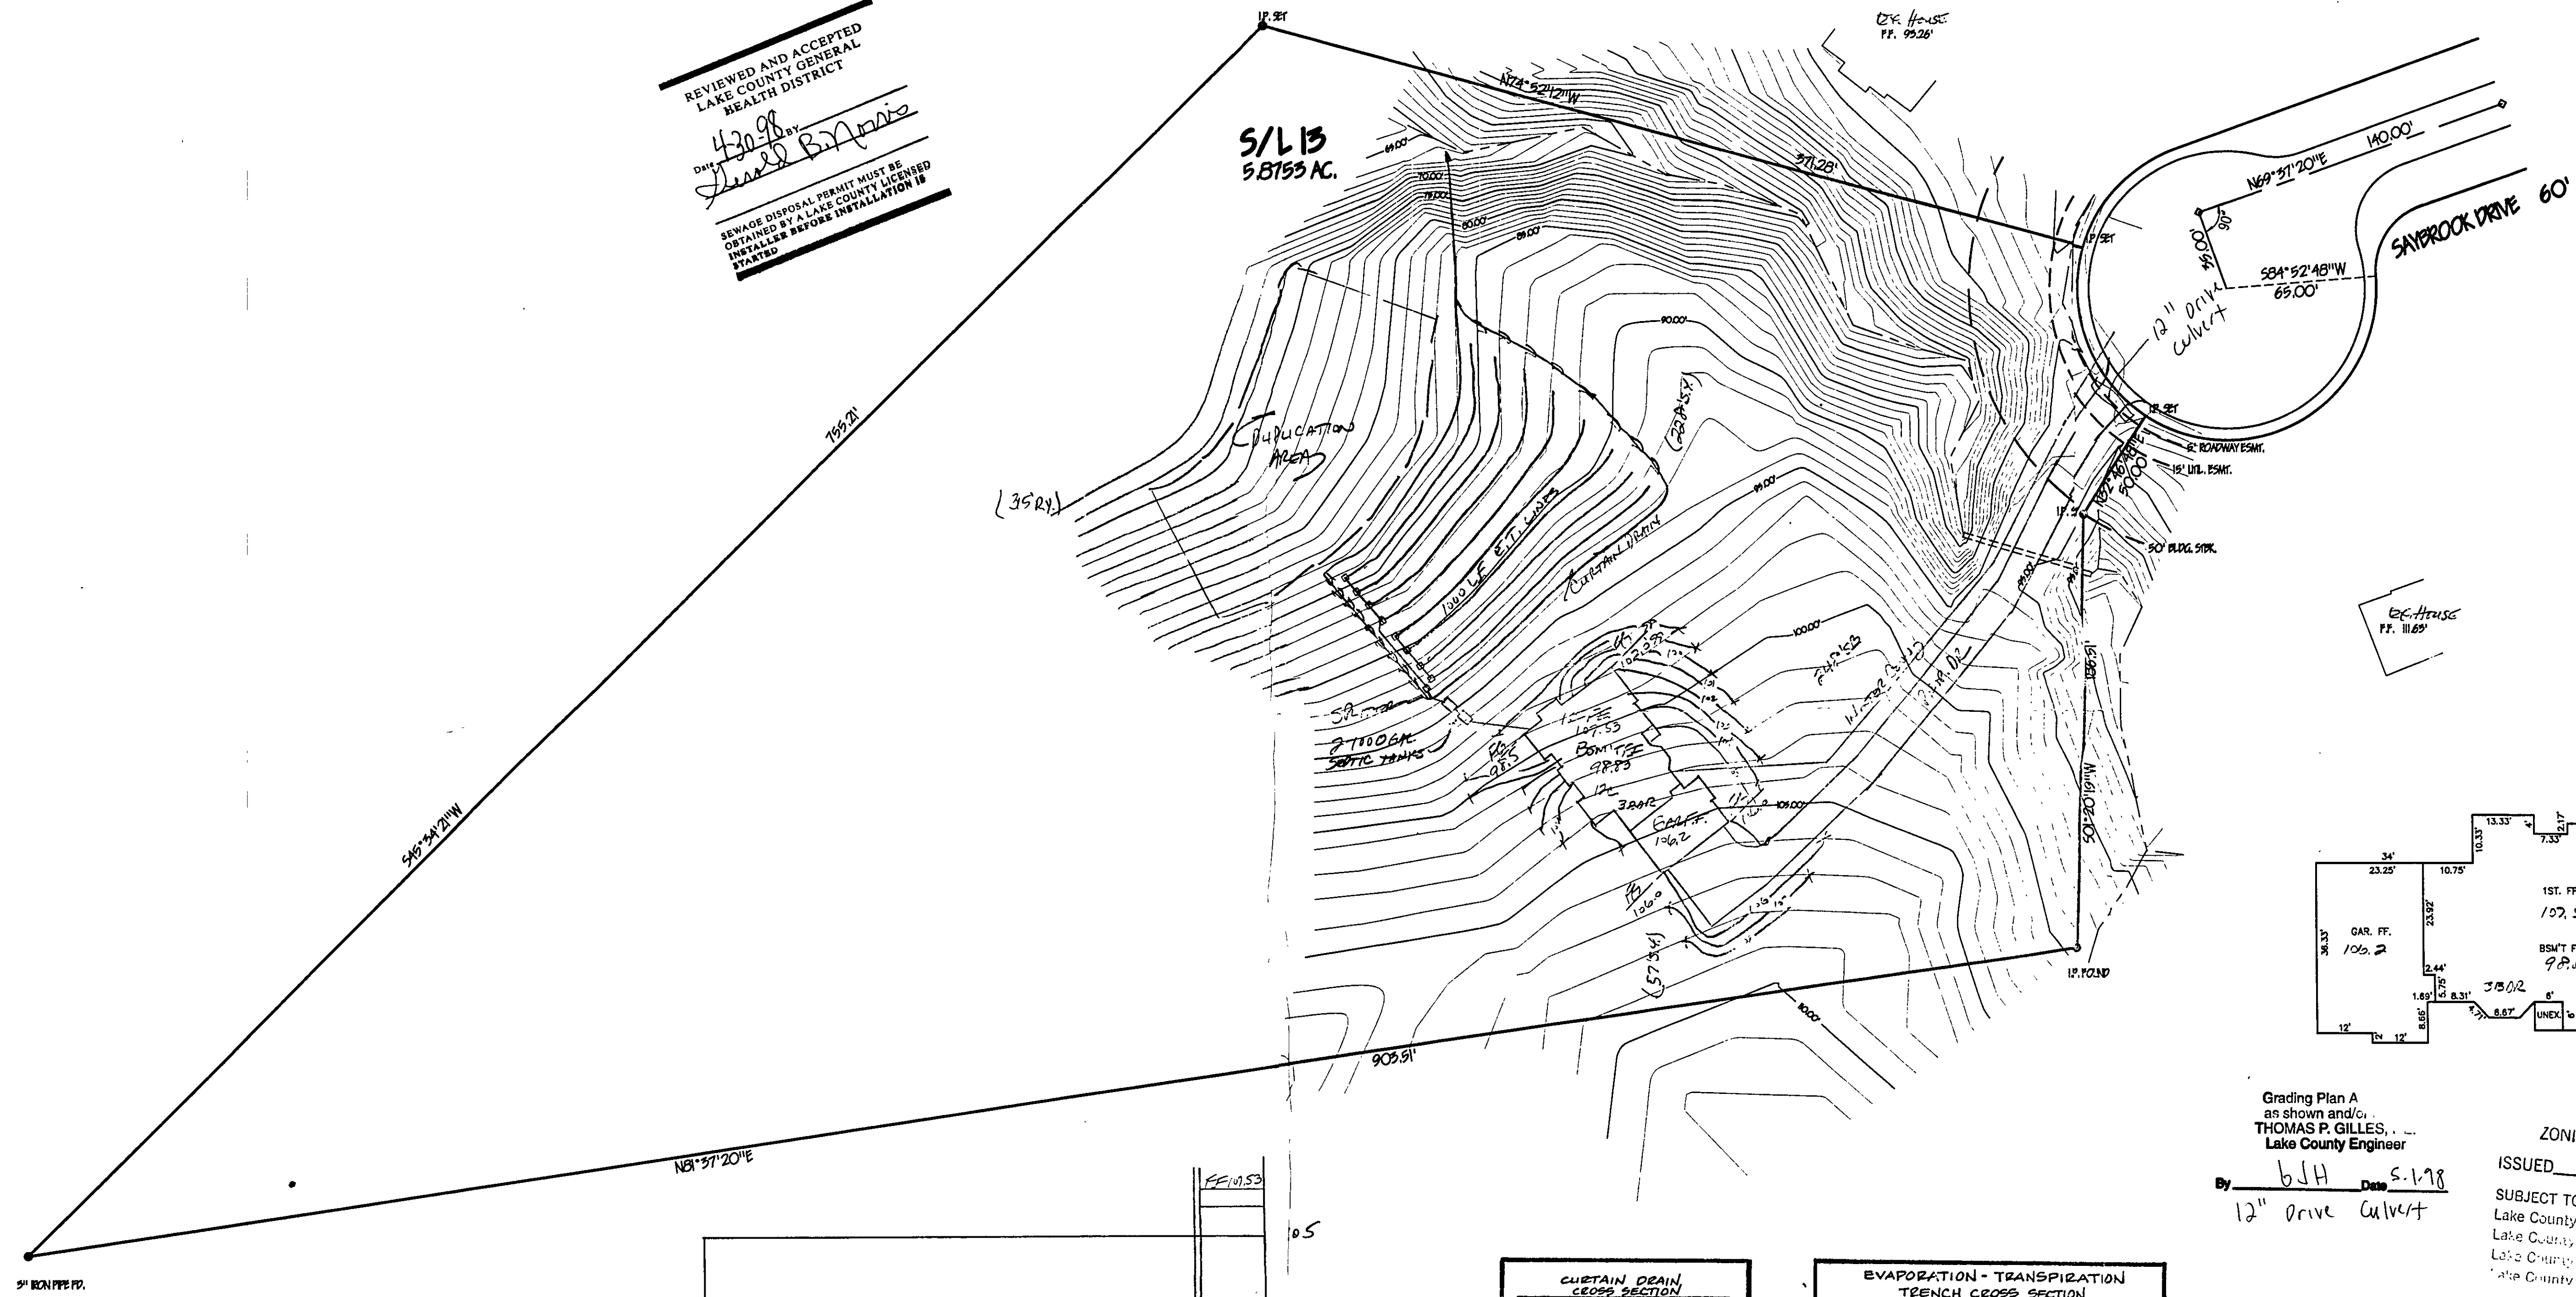
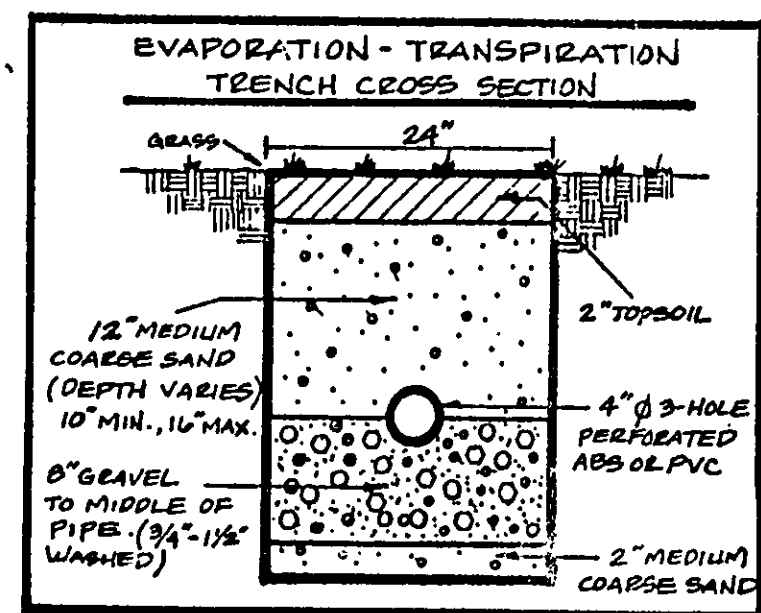


REVIEWED AND ACCEPTED
LAKE COUNTY GENERAL
HEALTH DISTRICT
DATE 4/20/98 BY David B. Jones
SEWAGE DISPOSAL PERMIT MUST BE
OBTAINED BY A LAKE COUNTY LICENSED
INSTALLER BEFORE INSTALLATION IS
STARTED


S/L 13
5.8153 AC.

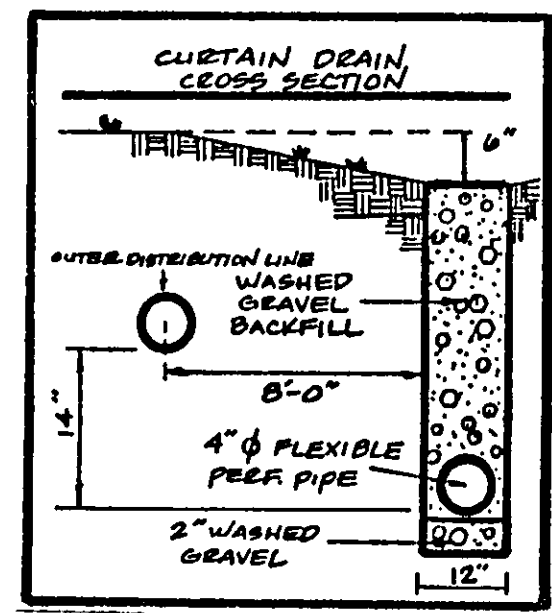

Grading Plan A
as shown and/or
THOMAS P. GILLES, P.E.
Lake County Engineer
By bjh Date 5-1-98
12" Drive Culvert
ZONING PERMIT #0448-1030
ISSUED 4/27/98
SUBJECT TO APPROVAL BY:
Lake County Sanitary Eng. ☐
Lake County Health Dept. ☒
Lake County Planning Comm. ☐
Lake County Public Works ☒

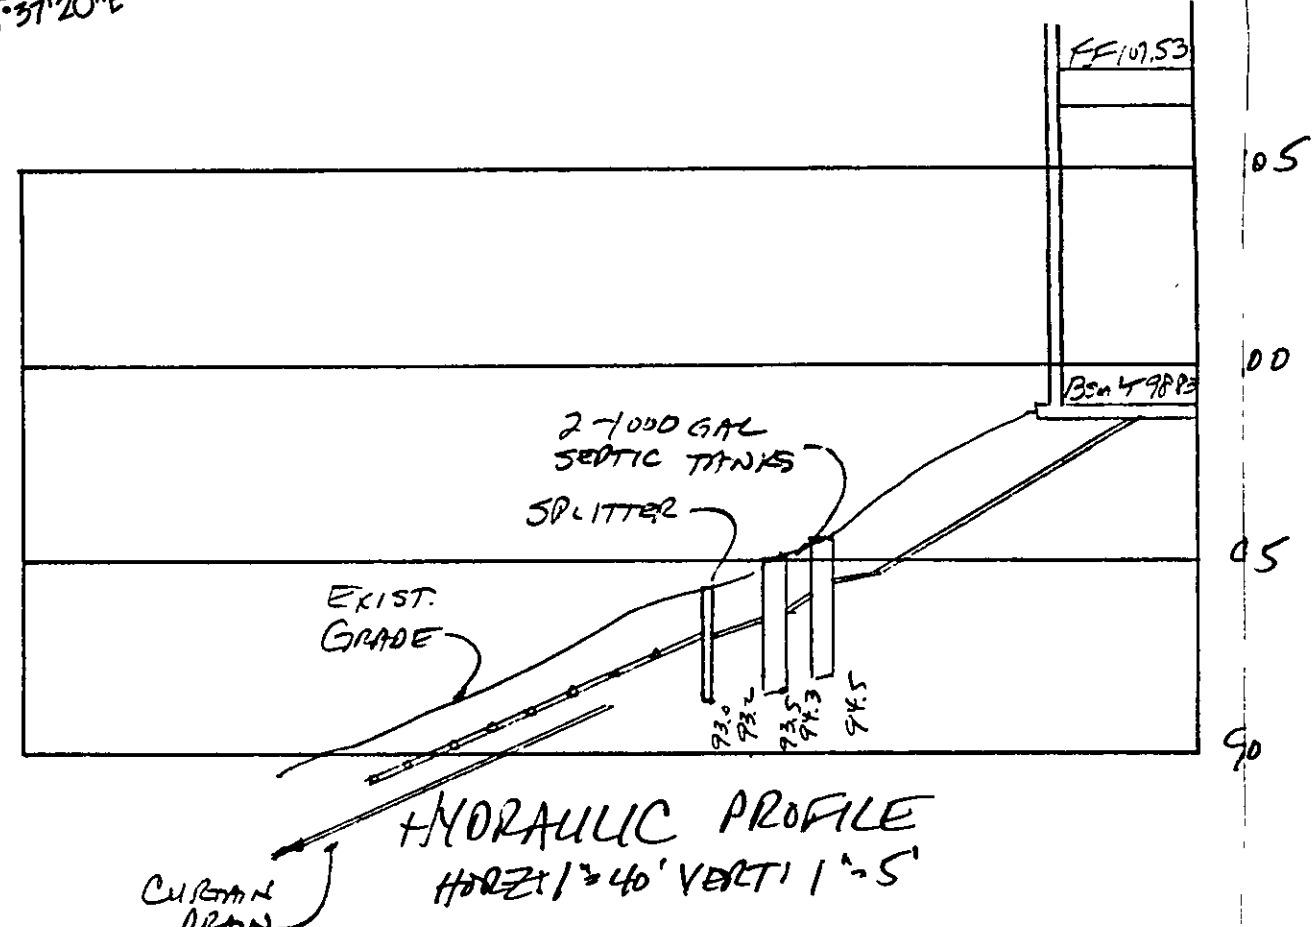

"I, the undersigned hereby certify that
this topography indicated by 6", 1" or 2"
contours, and elevations shown hereon
represent an actual field survey made by
me on the 24th day of March, 1997
and that the elevations were taken at
appropriate intervals and that as of that
date they existed as indicated hereon."
Name: Harry S. Jones, Jr. Reg. No. 6343

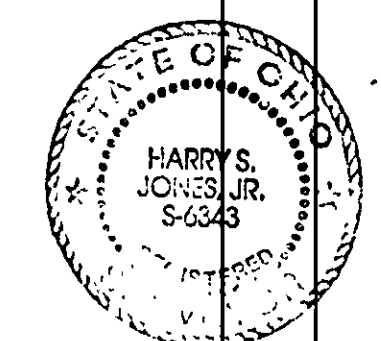

REV. NO.	DESCRIPTION	DATE	BY	CHK'D
1	Added House & Septic	4-22-98	bjh	1/5

bj BABCOCK, JONES AND ASSOCIATES, INC
CIVIL ENGINEERS - SURVEYORS - LAND PLANNERS
PAINESVILLE OHIO 44077

DATE 9/26/97
DESIGN BY AT
DRAWN BY M.S.
APPROVED BY CJS

SITE PLAN
for
SUBLOT 13
for
HENRY COVETTA
CONCORD TOWNSHIP
LAKE COUNTY, OHIO
SCALE 1"=40'
JOB NO. 97-199-13
SHEET 1 OF 1