

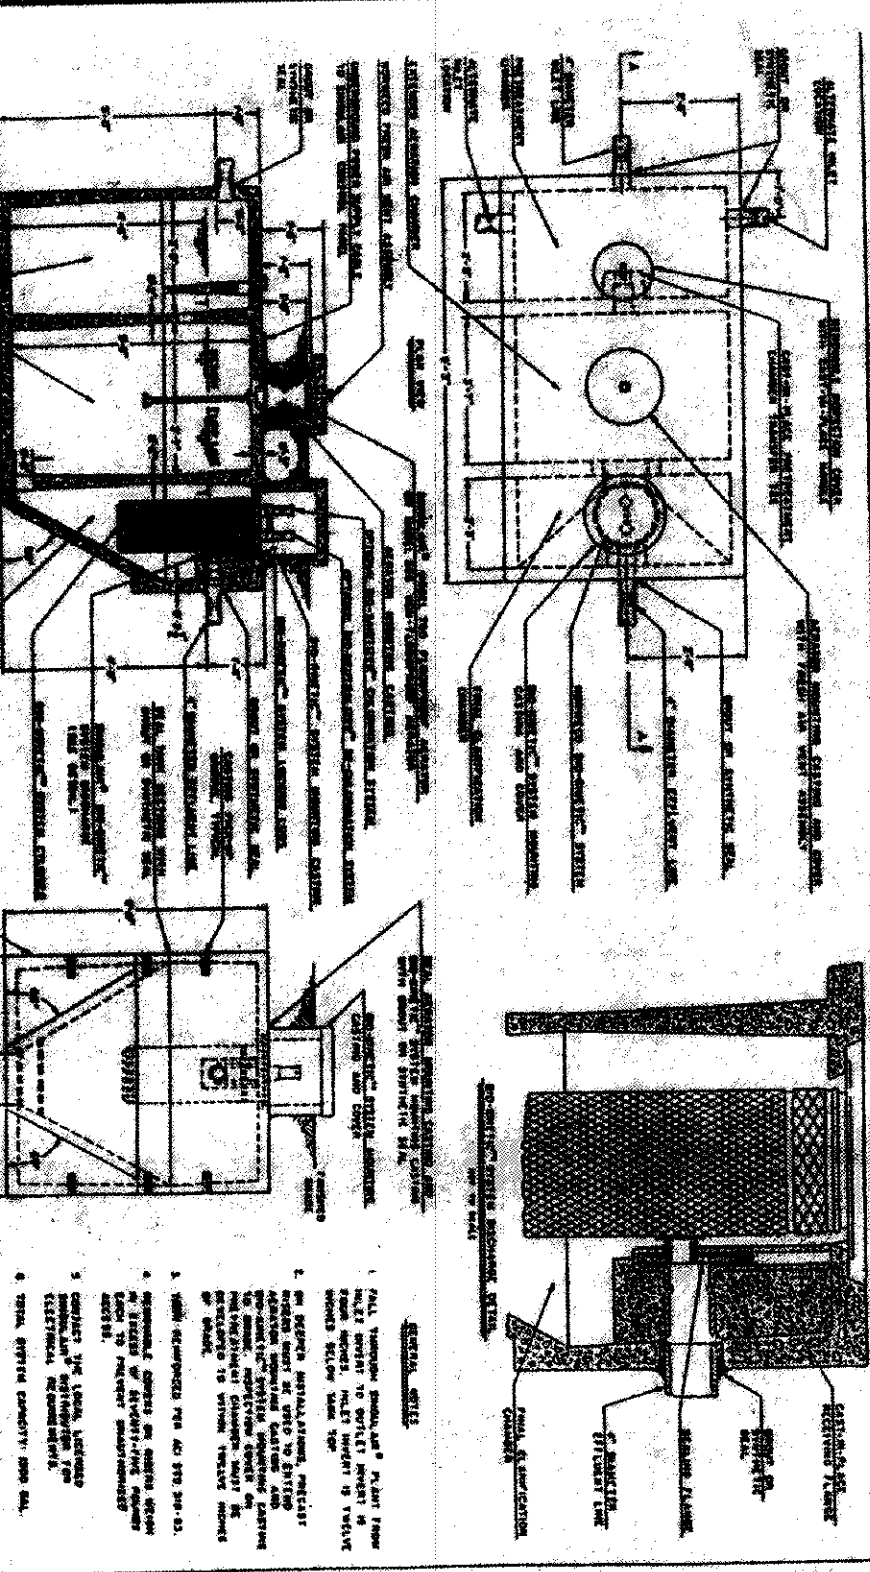
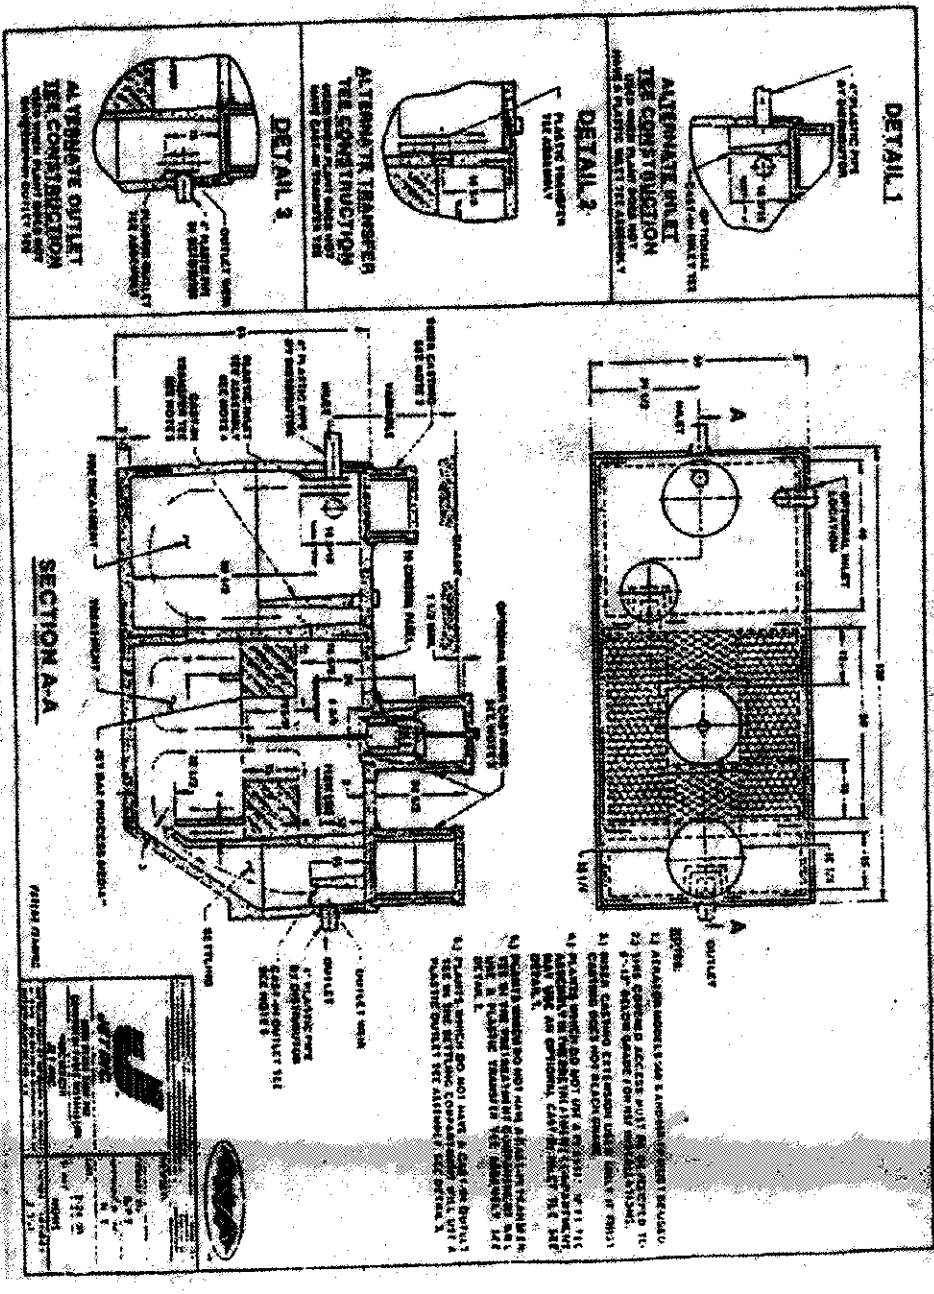


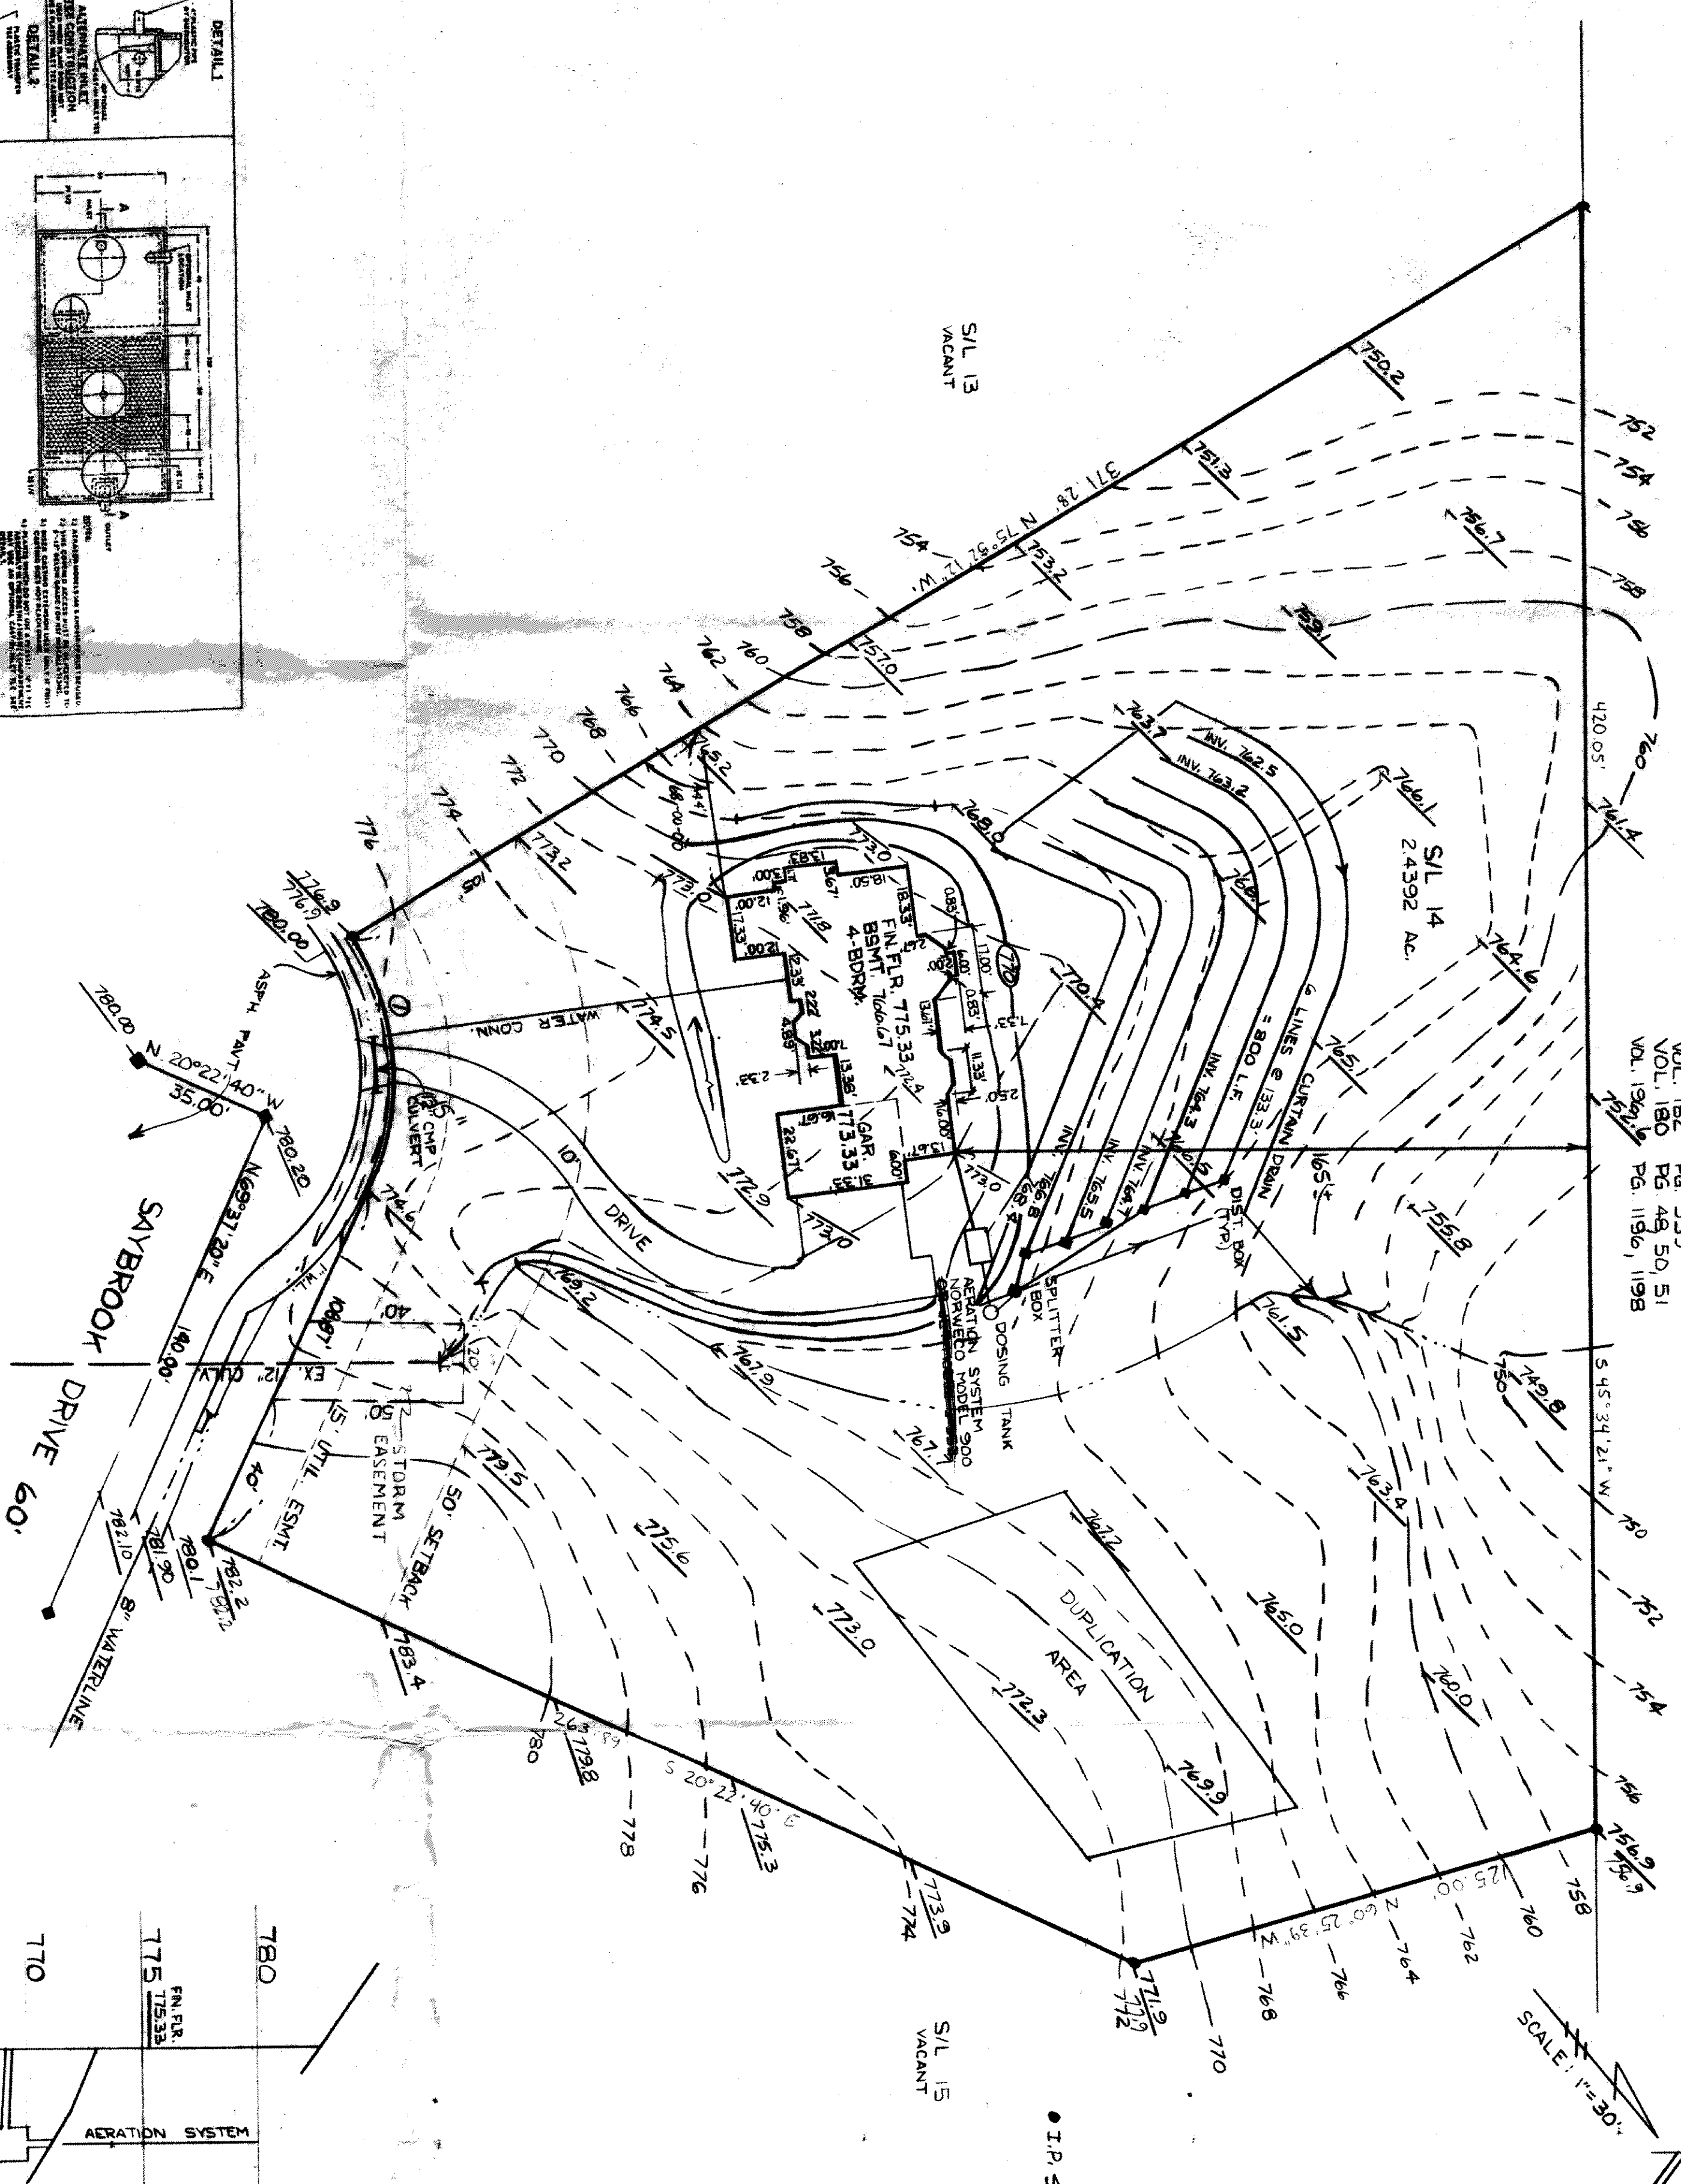

① E=105.00'
A=61.82'
C=59.52'
N=42°21'34\"/>

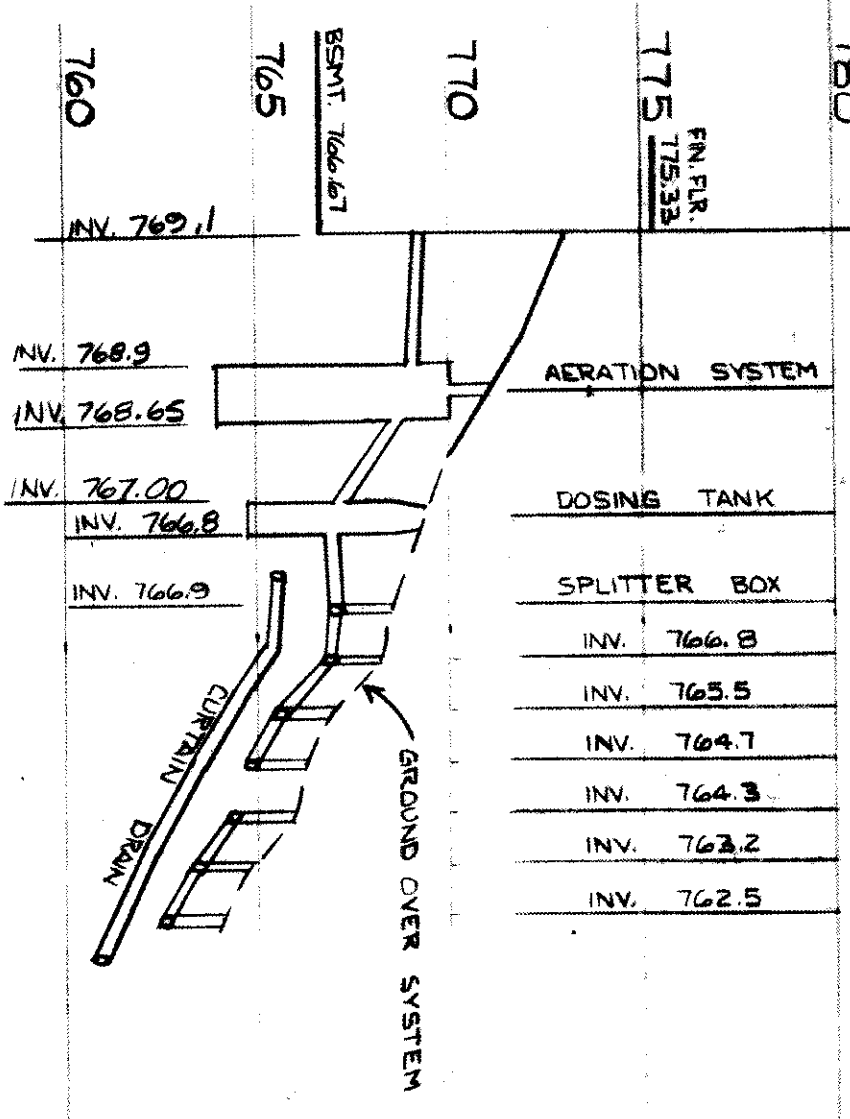

LOW YIELD WATER
FIXTURES REQUIRED
ON ALL
Shower Head
Toilet

- A. To be brought to finished grade
1. Slope with multiple covers
 2. Slope with one cover
 3. Distribution box cover
- B. No future drains or developments to be discharged into right-of-way
- C. All water meter to be discharged into right-of-way

Noted and Approved
LAKE COUNTY GENERAL HEALTH DEPARTMENT
Date: 5-11-94
JES. LUDWIG, R. S. E., R. S. E.
Health Commissioner
by: David B. Brown

NOTARIAL PUBLIC
GUTOSKEY & ASSOCIATES, INC.
CINCINNATI, OHIO 45202-1111

Grading Plan Approved
THOMAS P. GILLES, P.E.
Lake County Engineer
By: 15" CMP CULVERT
Date: 5-11-94
USE 15" CMP CULVERT

ZONING PERMIT #0394-7803
ISSUED 5-11-94
SUBJECT TO APPROVAL BY:
Lake County Sanitary Eng. ☐
Lake County Eng. Dept. ☐
Lake County Planning Comm. ☐
Lake County Bldg. Dept. ☒

John M. Malyre

S/L 14 DEVONSHIRE SUBD.
CONCORD TWP. - LAKE COUNTY - OHIO

GUTOSKEY & ASSOCIATES INC.
Civil Engineers and Surveyors
3311 Perkins Ave. Tel (216) 881-8100
Cleveland, Ohio 44114 Fax (216) 881-3111

SITE PLAN
for
ANDREWS BUILDERS
35475 VINE ST.
EASTLAKE, OHIO 44094

Date: APRIL 1994
Scale: Hor. 1"=30'
Vert. 1"=5'
Plotted by: _____
Checked by: _____
Sheet 1 of 1
CONTRACT NO. _____

I, THE UNDERSIGNED HEREBY DECLARES THAT THE TOPOGRAPHY SHOWN
HEREON IS A TRUE AND CORRECT REPRESENTATION OF THE
SURFACE OF THE LAND SHOWN AND THAT THE
ELEVATIONS WERE TAKEN AT APPROPRIATE INTERVALS AND THAT AS OF
THE DATE THEY WERE TAKEN AS INDICATED HEREON.
Date: 5-11-94
by: John M. Malyre

