


REV.	DESCRIPTION	DATE	BY	CHK'D
1				
2				
3				
4				
5				
6				
7				
8				
9				
10				

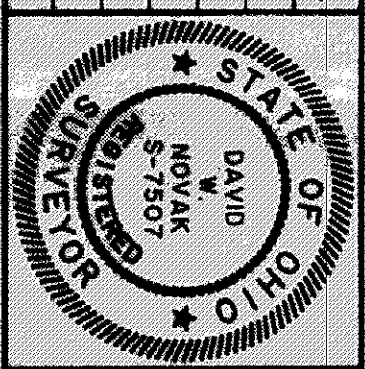

Himebaugh and Novak
 Surveyors and Site Consultants
 8663 Tyler Boulevard
 Mentor, Ohio 44060-4346
 (216) 974-7670, (216) 255-5900 FAX.


LITTLE MOUNTAIN HOMES, INC.
 1447 NORTH RIDGE ROAD, PAINESVILLE, OH 44077

DATE	DESCRIPTION
JUNE 20, 1995	ISSUED
D. W. NOVAK	DESIGNED BY
DWN	APPROVED BY

SUBLOT NO. 42, SKYLINEVIEW DRIVE 60', CONCORD, OH
 LITTLE MOUNTAIN PARK ESTATES NO. 5, VOL. P. 1, PG. 15

SCALE	DATE
HORIZ. 1" = 20'	94131
VERT. 1" = 10'	94131
CONTRACT NO.	94131
SHEET NO.	37


ZONING PERMIT #0695-8194
 ISSUED 6/21/95
 SUBJECT TO APPROVAL BY:
☐ Lake County Sanitary Eng.
☒ Lake County Eng. Dept.
☐ Lake County Planning Comm.
☒ Lake County Bldg. Dept.

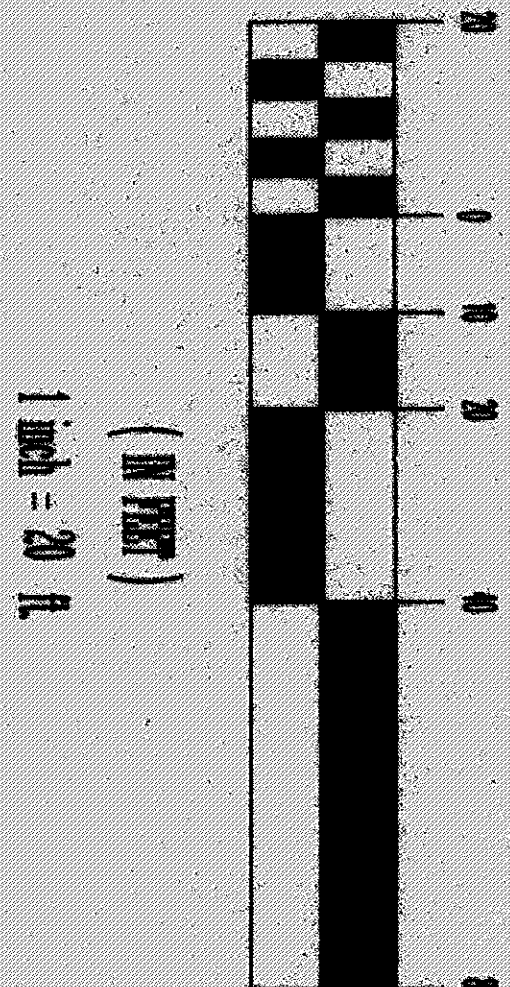

GRAPHIC SCALE
 - minimum 12" drive culvert
 - 20' drainage segment + required
 as shown.

Grading Plan Approved
 as shown and/or noted
 THOMAS P. GILLES, P.E.
 Lake County Engineer
 By: *THP* Date: 6/26/95

I HEREBY CERTIFY THAT THIS PLAN WAS PREPARED BY ME
 AND IS CORRECT TO THE BEST OF MY KNOWLEDGE.
David W. Novak
 DAVID W. NOVAK, P.E. NO. 1507

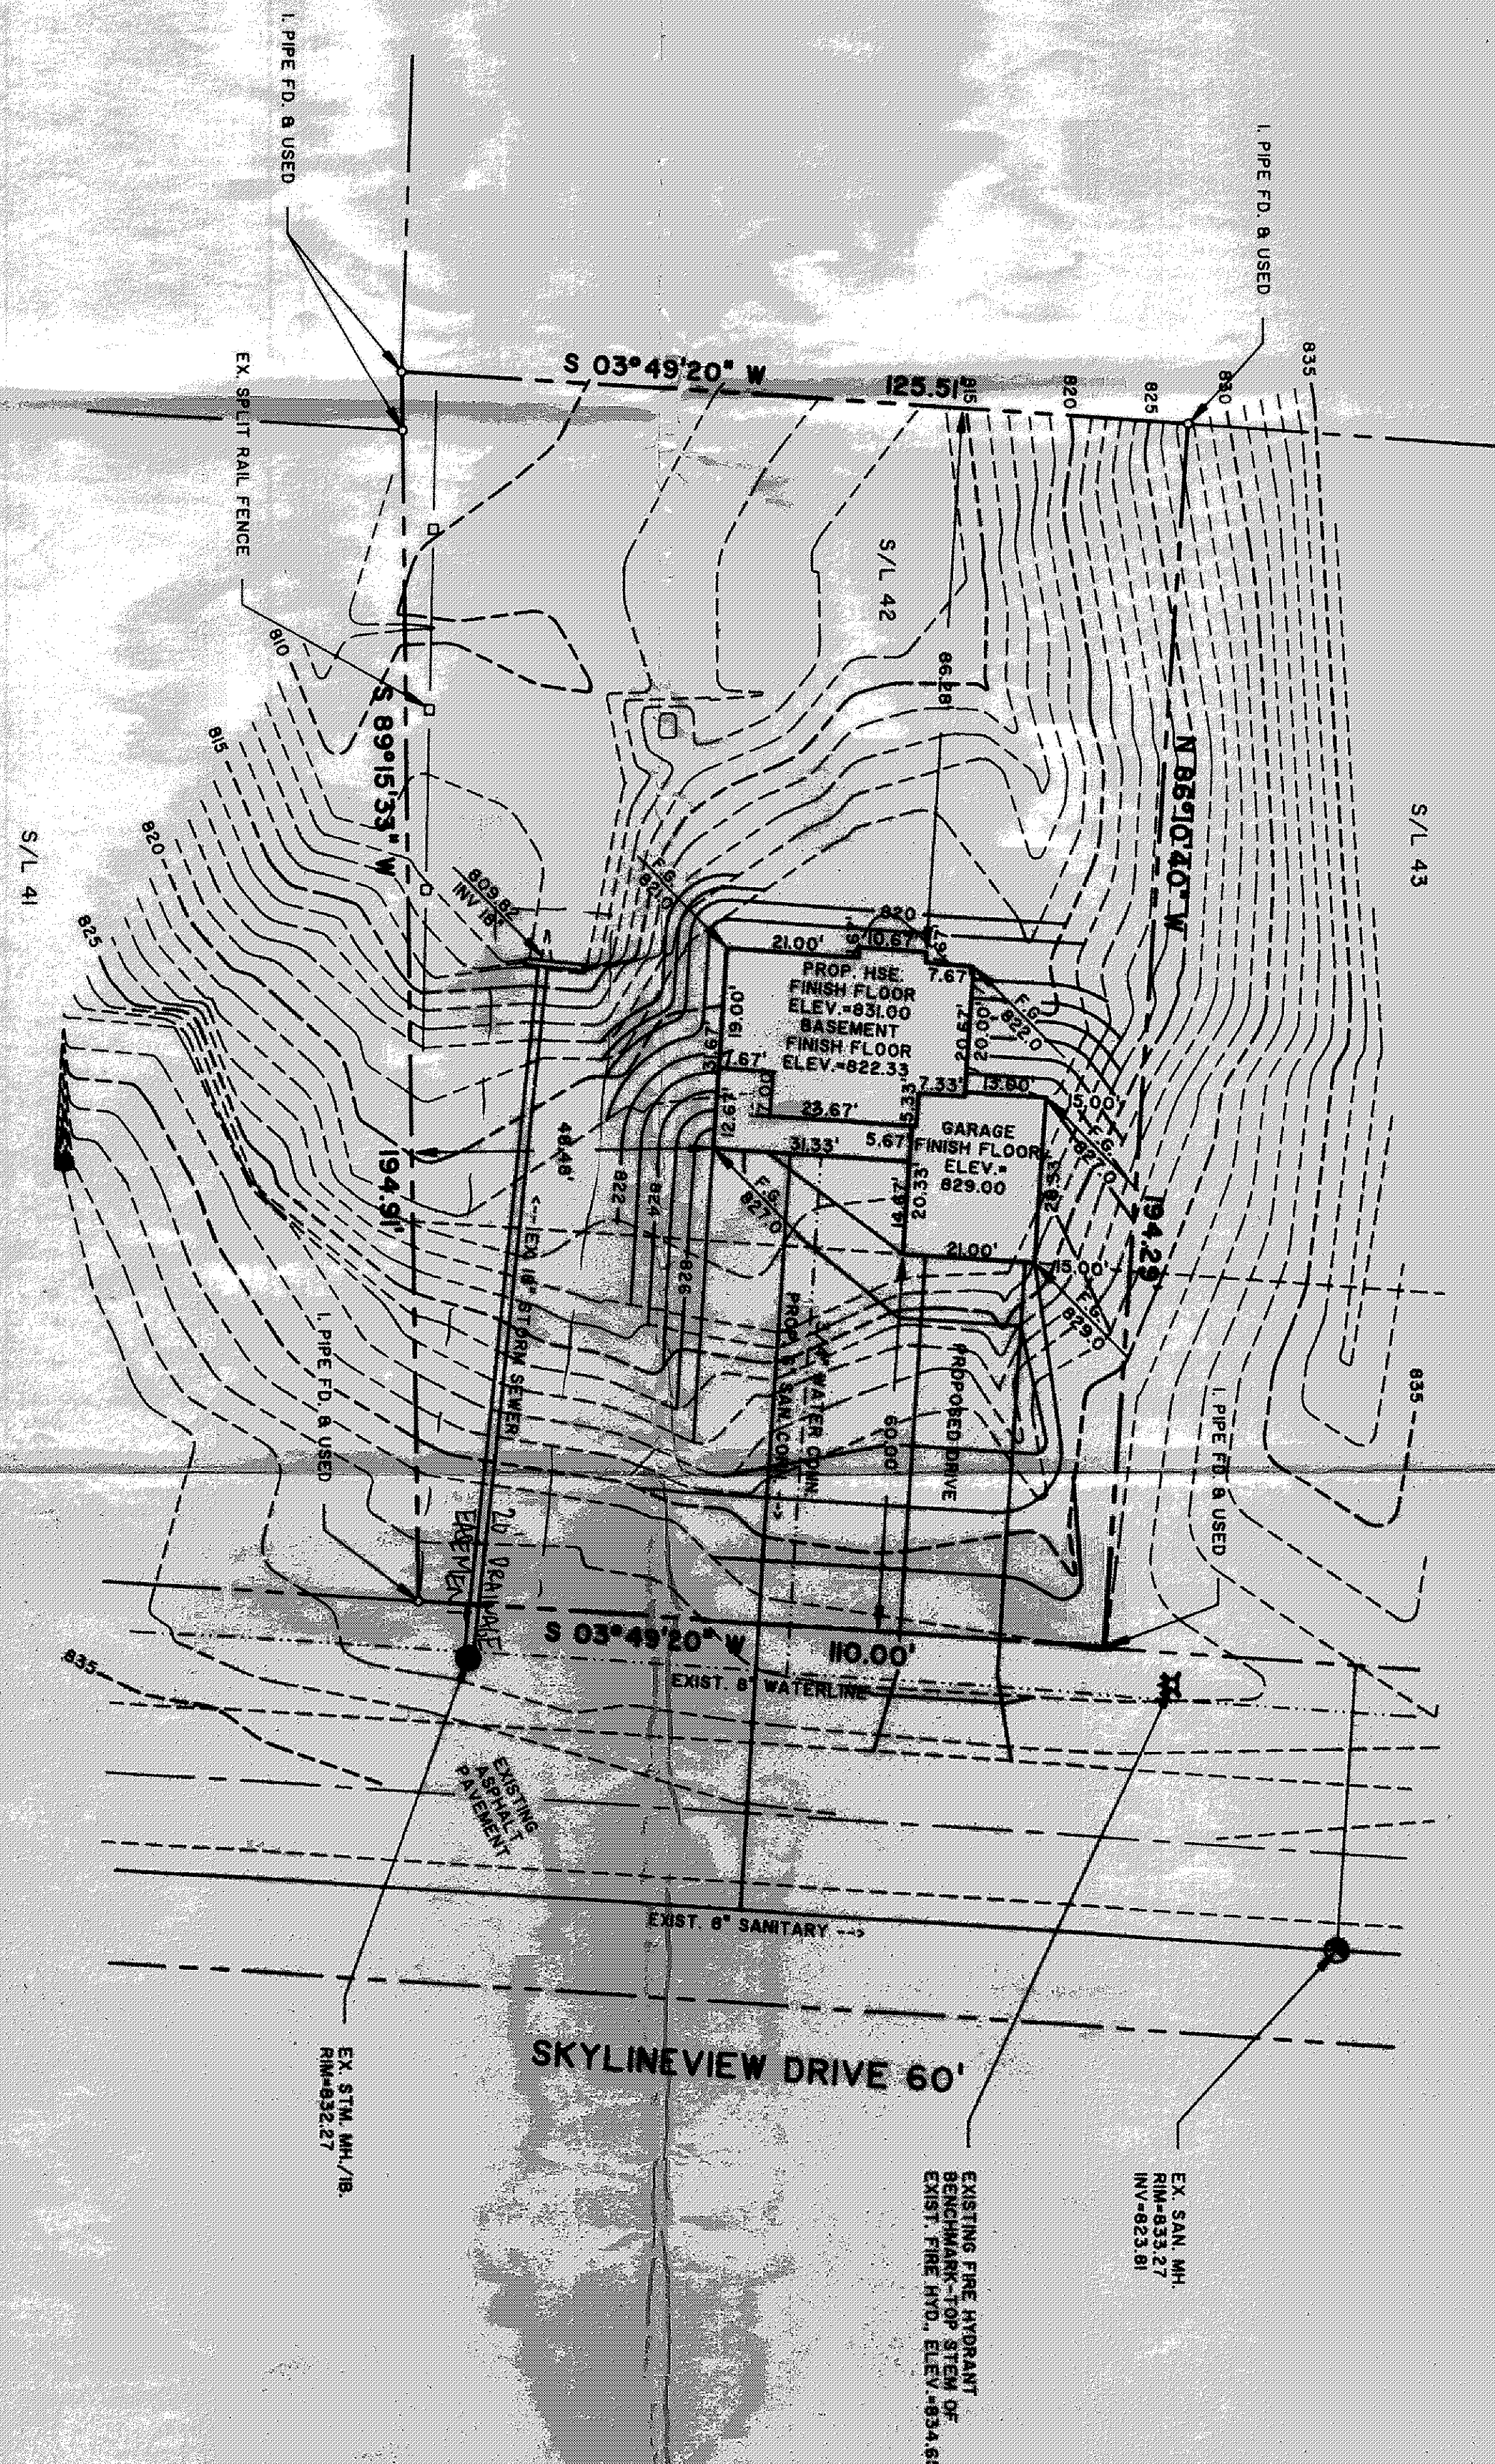

- GENERAL NOTES:**
1. DRIVEWAY APRON TO BE 6" THICK
 2. BENCHMARK - TOP STEM OF FIRE HYDRANT LOCATED IN FRONT OF SUBLOT NO. 43, ELEV. +834.65

LEGEND

- EXISTING CONTOUR
- PROPOSED CONTOUR
- EXISTING ELEVATION
- PROPOSED ELEVATION

CERTIFICATION

"I, THE UNDERSIGNED, HEREBY CERTIFY THAT THE TOPOGRAPHY INDICATED BY THE CONTOURS AND ELEVATIONS SHOWN HEREON REPRESENTS AN ACTUAL SURVEY MADE BY ME ON THE 16th DAY OF MARCH, 1995 AND THE ELEVATIONS WERE TAKEN AT APPROPRIATE INTERVALS AND AS OF THAT DAY THEY EXISTED AS INDICATED HEREON.