

DESIGN & SURVEYOR'S CERTIFICATION

I, the undersigned hereby certify that I have surveyed the platted property shown hereon containing .537 acres of land. Iron pin monuments were found or set at points indicated. All dimensions shown hereon are expressed in feet and decimal parts thereof. Bearings shown hereon are based upon an assumed meridian and are for the sole purpose of indicating the relative angle between lines.


I, the undersigned hereby certify that the topography shown hereon, indicated by one foot contours and elevations represents actual field topography as shown on as-built plans and verified by me on Aug 25, 1999 and that as of that date they existed as indicated hereon.

This Plat was prepared by me and is correct to the best of my knowledge and belief.

Surveyor's Signature *Edward L. Debevec* Date 8/25/99



Registration No: 4514

Seal:

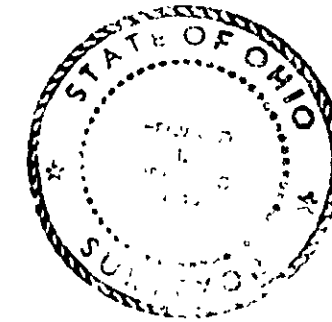

LEGEND
Existing Elevation: 800.00
Proposed Elevation: 800.00
As-Built Elevation: 800.00


Existing Contour: ---
Proposed Contour: - - -

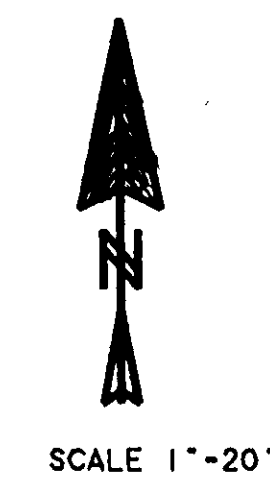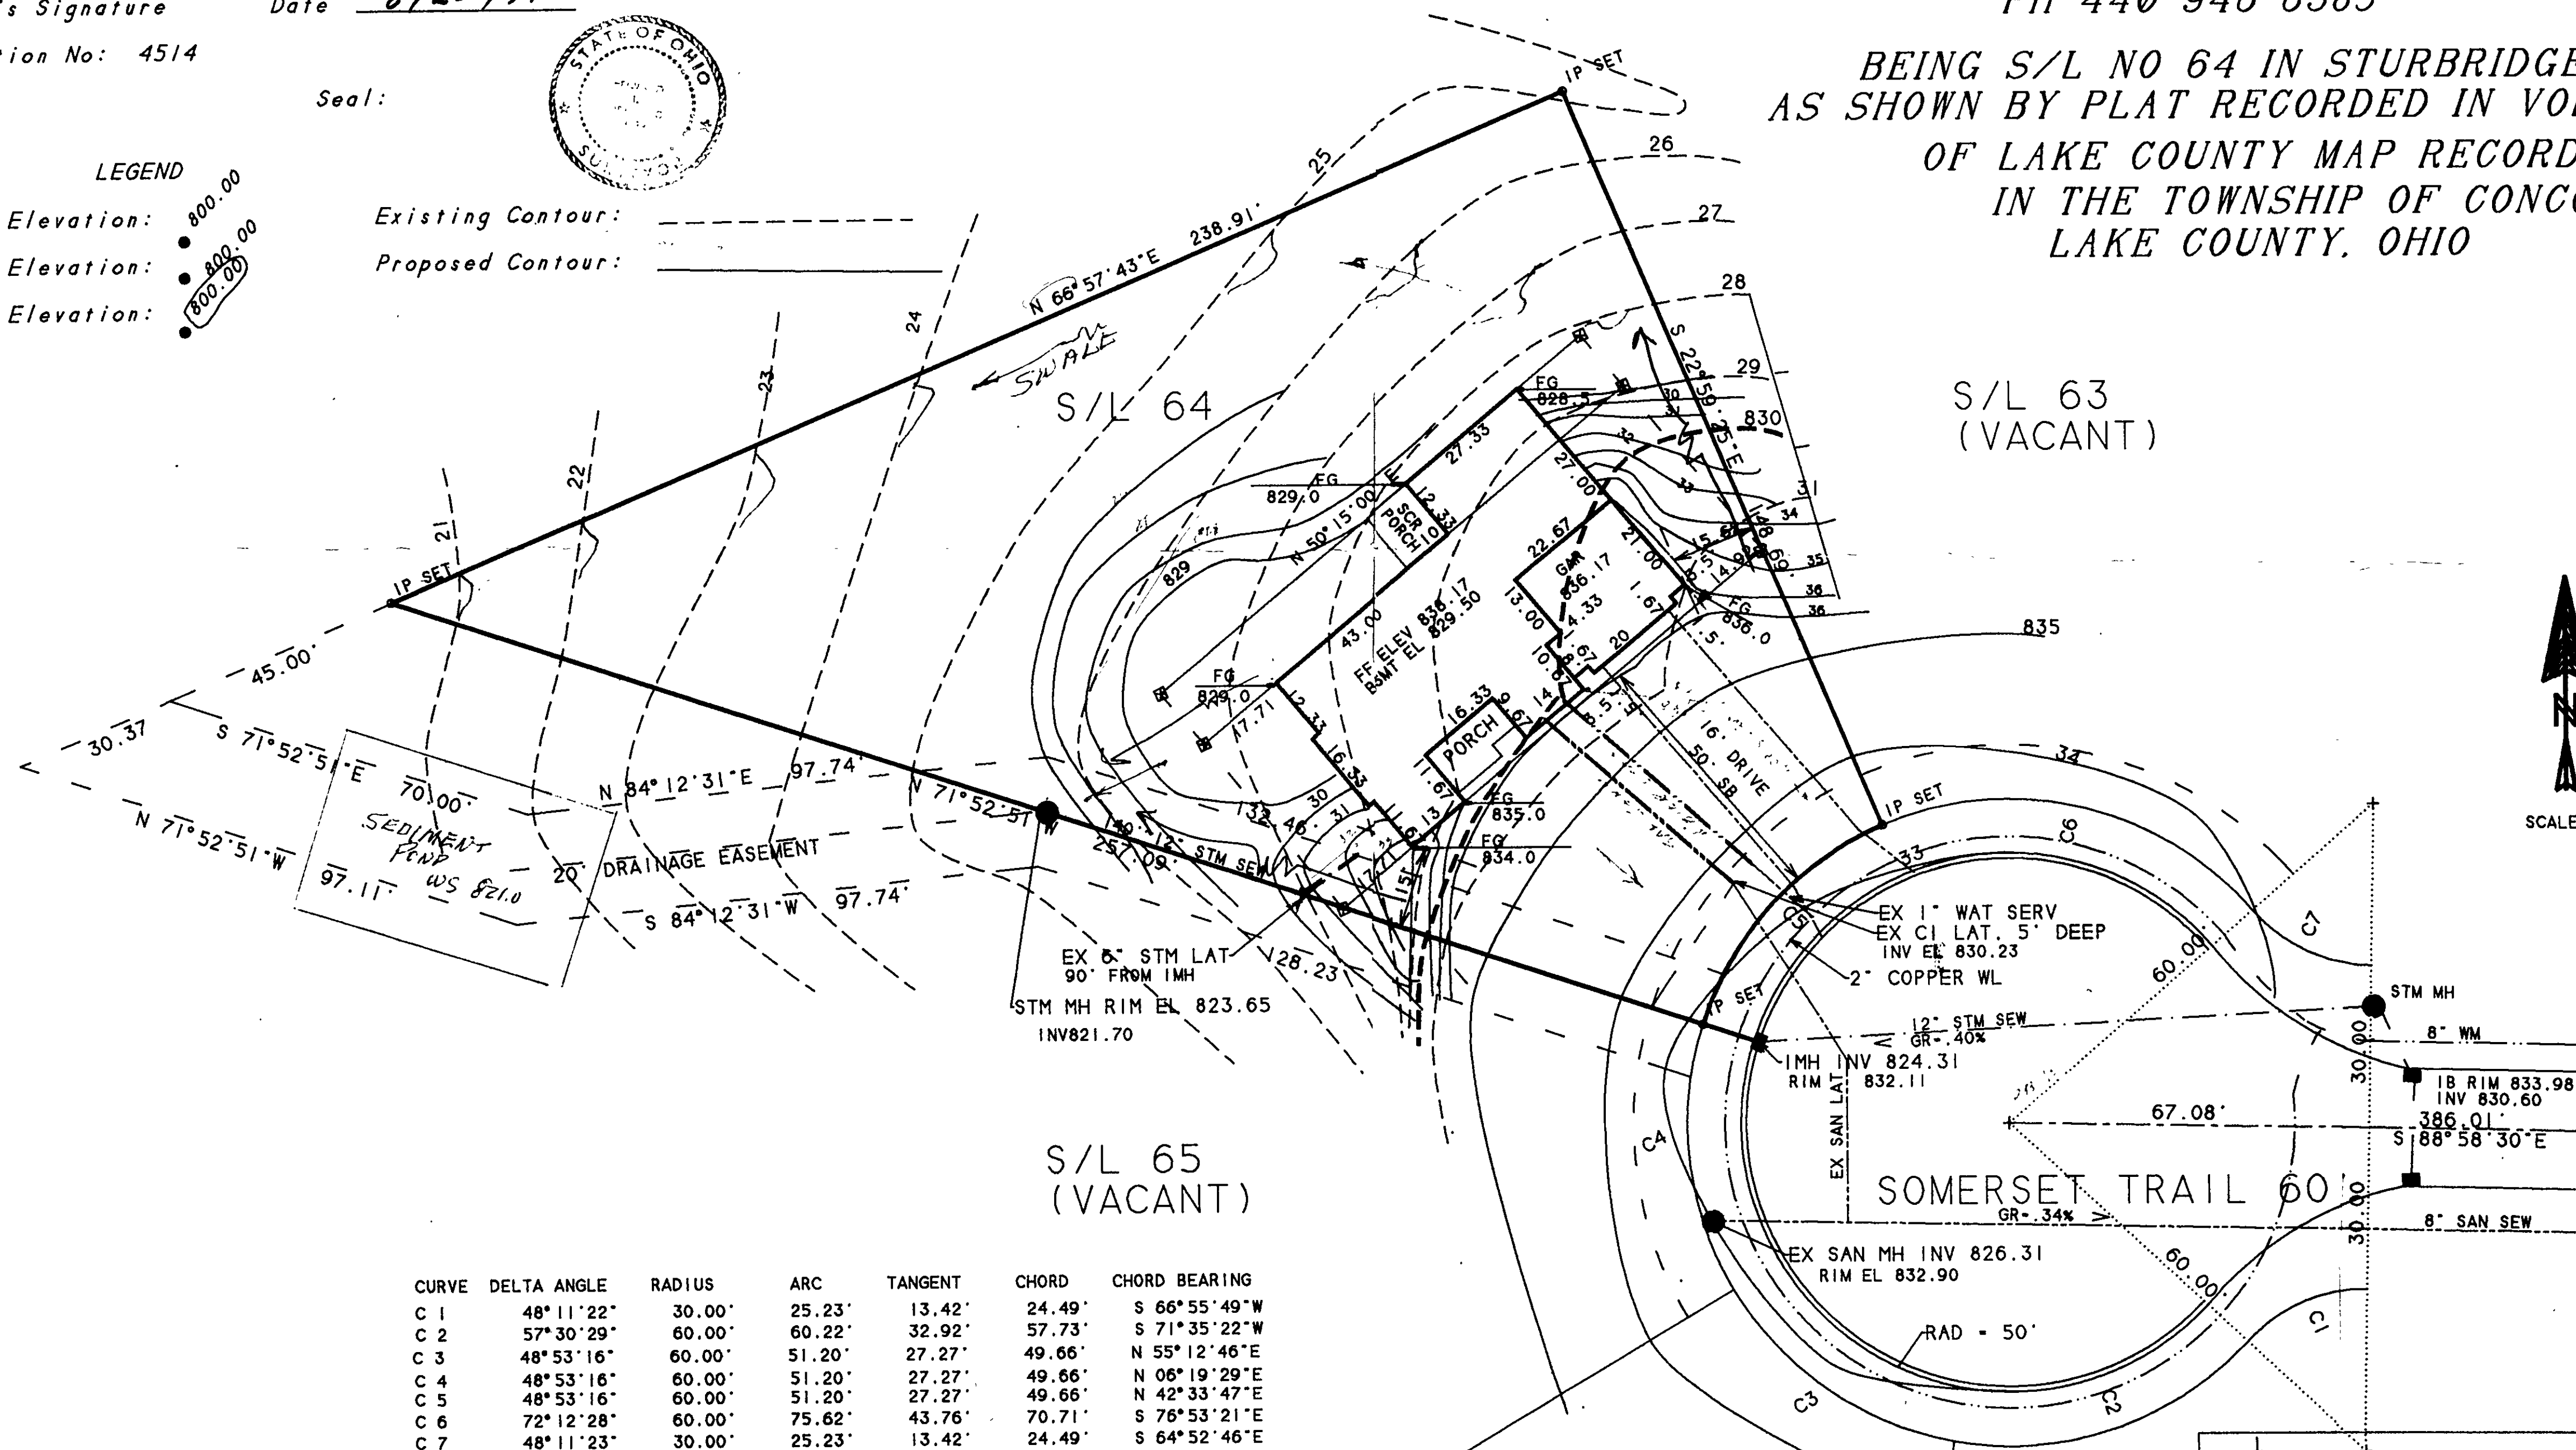

CURVE	DELTA ANGLE	RADIUS	ARC	TANGENT	CHORD	CHORD BEARING
C 1	48° 11' 22"	30.00'	25.23'	13.42'	24.49'	S 66° 55' 49" W
C 2	57° 30' 29"	60.00'	60.22'	32.92'	57.73'	S 71° 35' 22" W
C 3	48° 53' 16"	60.00'	51.20'	27.27'	49.66'	N 55° 12' 46" E
C 4	48° 53' 16"	60.00'	51.20'	27.27'	49.66'	N 06° 19' 29" E
C 5	48° 53' 16"	60.00'	51.20'	27.27'	49.66'	N 42° 33' 47" E
C 6	72° 12' 28"	60.00'	75.62'	43.76'	70.71'	S 76° 53' 21" E
C 7	48° 11' 23"	30.00'	25.23'	13.42'	24.49'	S 64° 52' 46" E

Grading Plan Approved
as shown and/or noted
THOMAS P. GILLES, P.E.
Lake County Engineer

By *Tom* Date 8/25/99
Scale as shown

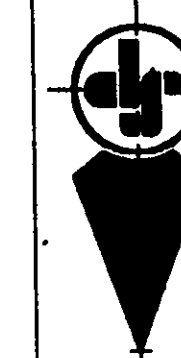

DEBEVEC-SALO & ASSOC., INC.
CIVIL ENGINEERS & SURVEYORS
29483 SAYLE DRIVE WILLOUGHBY HILLS, OHIO 44092
PHONE (216) 944-2589

S/L NO 64 STURBRIDGE 2
SITE & GRADING PLAN

8/25/99
SCALE 1"=20'
WO 6656

ISSUED 8/31/99

SUBJECT TO APPROVAL BY:
Lake County Sanitary Eng. ☐
Lake County Eng. Dept. ☒
Lake County Planning Comm. ☐
Lake County Bldg. Dept. ☒