

SILT BARRIERS TO BE INSTALLED PRIOR TO ANY EARTHWORK ACTIVITY. IN
WATERWAYS SUBJECT TO FLOODING, PER PERMITS.

STONE SHALL BE INSTALLED IN STREAMS/DRAINAGE AREA 20 FEET WIDE AND
30 FEET LONG TO PREVENT EROSION FROM SEDIMENT OFF OF THIS
AREA AND TO BE LIMITED TO THIS AREA ONLY.

SEDIMENT CONTROL MEASURES SHALL BE FUNCTIONAL THROUGHOUT ALL
PHASES OF EARTH DISTURBANCE ACTIVITY. SETTING FRACTURES,
PERMANENT CONTROLS, AND OTHER PRACTICES INTENDED TO TRAP SEDIMENT
IMMEDIATELY AFTER THE ACTIVITY OF EROSION AND WITHIN SEVEN
(7) DAYS FROM THE START OF GRUBBING. THEY SHALL CONTINUE TO
FUNCTION WITH THE DISTURBANCE AS PERMITTED BY THE DISTURBANCE.

UNDISTURBED AREAS SHALL HAVE SOIL STABILIZATION WITHIN NO MORE THAN
THIRTY (30) DAYS IF 15 DAYS IF SOIL IS NOT SIGNIFICANTLY UNDISTURBED FOR
THIRTY (30) DAYS. PERMANENT OR TEMPORARY SOIL
STABILIZATION SHALL BE INSTALLED WITHIN SEVEN (7) DAYS OF NO MORE
THIRTY (30) DAYS AFTER FINAL GRADE IS REACHED ON ANY PORTION OF
THE SITE, AND SHALL ALSO BE APPLIED WITHIN NO MORE THAN SEVEN (7)
DAYS OF THE DISTURBANCE BEING ESTIMATED TO BE THE LAST DAY OF
REMAINING DURATION FOR LONGER THAN THIRTY-FIVE (35) DAYS.

STABILIZATION OF CRITICAL AREAS WITHIN 50 FEET OF ANY STREAM OR WETLAND
OR OTHER SENSITIVE AREAS SHALL BE REQUIRED. SOIL STABILIZATION SHALL
APPLY WITHIN CRITICAL AREAS FOR FOURTEEN (14) DAYS OR LONGER. CONSTRUCTION
VEHICLES SHALL NOT STREAMS AND OTHER SENSITIVE AREAS IF ANY ACTIVE
CONSTRUCTION IS TAKEN PLACE. WHEN CONSTRUCTION IS COMPLETED,
DURING CONSTRUCTION, AN APPROVED TEMPORARY STREAM CROSSING SHALL BE
CONSTRUCTED.


SOIL HYDROLOGIES SHALL BE STABILIZED OR PROTECTED TO PREVENT SOIL LOSS
DURING CONSTRUCTION. ALL REQUIRED STABILIZATION ARE LOCATED WITHIN CRITICAL
AREAS NEAR STREAM OR WETLANDS, OR IF DETERMINED BY THE ADMINISTRATOR
THAT SENSITIVE AREAS ARE NEARBY.

SEDIMENT AND EROSION CONTROLS SHALL BE INSPECTED BY THE OWNER OR HIS/
HER AGENT EVERY SEVEN (7) DAYS AND WITHIN 24 HOURS OF A 0.5" OR GREATER
RAINFALL, AFTER A WRITTEN LOG OF THESE INSPECTIONS AND IMPROVEMENTS TO
THE SITE SHALL BE FILED WITH THE DISTRICT. THE LOG SHALL INCLUDE THE DATE OF
INSPECTION, NAME OF INSPECTOR, WEATHER CONDITIONS, THE ACTIONS TAKEN
TO CORRECT ANY PROBLEMS AND THE DATE ACTIONS WERE TAKEN.


WASHING SHALL BE TAKEN TO PREVENT SOIL TRANSPORT OUTSIDE SURFACES
WHERE RAINFALL IS NOT CHECKED BY SEDIMENT CONTROLS, OR ONTO PUBLIC
WATERWAYS. SOIL SHALL BE WASHED FROM THE SURFACES OF THE SITE. THE
WASHING SHALL BE CLEANED THOROUGHLY AT THE END OF EACH DAY, OR MORE
FREQUENTLY AS NECESSARY. WASHING SHALL BE STOPPED WHEN THE DATE OF
INSPECTION IS APPROXIMATELY 24 HOURS BEFORE STREET WASHING SHALL BE ALLOWED
ONLY AFTER MOST SEDIMENT HAS BEEN REMOVED BY SHOWELING OR SWEEPING.

THE ABOVE SPECIFIED EROSION CONTROL STANDARDS ARE GENERAL
GUIDELINES AND SHALL NOT BE THE EXHAUSTIVE LIST OF ALL EROSION CONTROL
MEASURES. THE DISTRICT MAY REQUIRE ADDITIONAL STANDARDS OR REQUIREMENTS THAT
STANDARDS LIMIT THE RIGHT OF THE COUNTY TO WAIVE, IN WRITING,
INDIVIDUAL REQUIREMENTS.

STABILIZATION SEEDING TO BE INSTALLED AFTER ALL CONSTRUCTION ACTIVITY
IS COMPLETE.

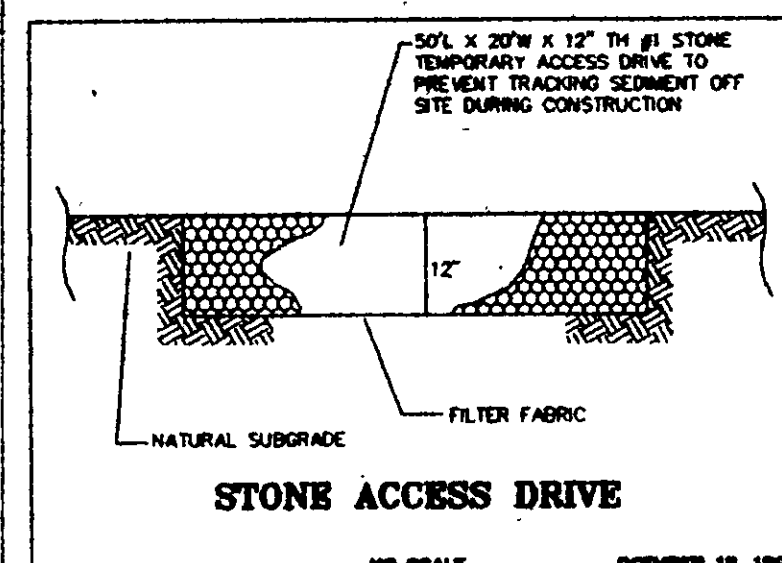


NO SCALE DECEMBER 18, 1967

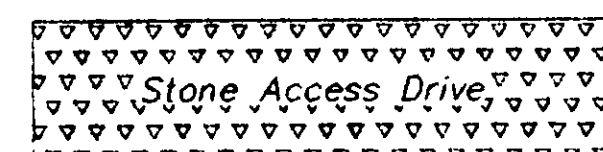

I, THE UNDERSIGNED, HEREBY CERTIFY THAT THIS TOPOGRAPHY, INDICATED BY 6", 1", OR 3" CONTOURS, AND ELEVATIONS SHOWN HEREON, REPRESENT AN ACTUAL FIELD SURVEY MADE BY ME ON THE 30th DAY OF January, 2002 AND THAT THE ELEVATIONS WERE TAKEN AT APPROPRIATE INTERVALS, AND ON THE DATE THEY EXISTED AS INDICATED HEREON.


Richard A. Thompson, Jr. P.5748

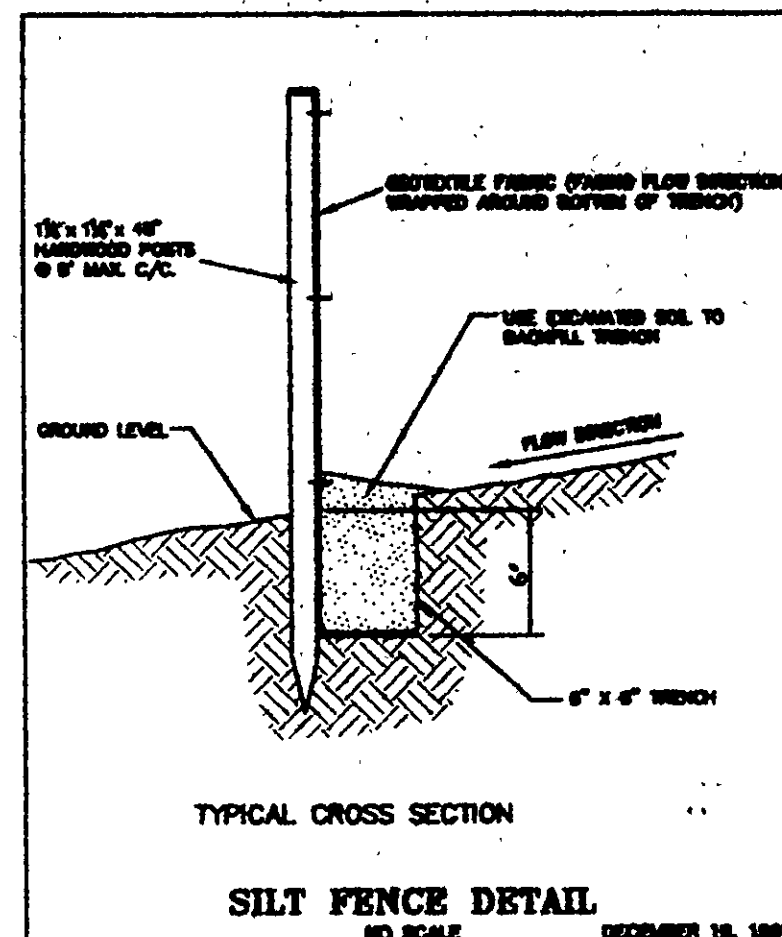

TYPICAL CROSS SECTION

SILT FENCE DETAIL

NO SCALE FEBRUARY 14, 1964

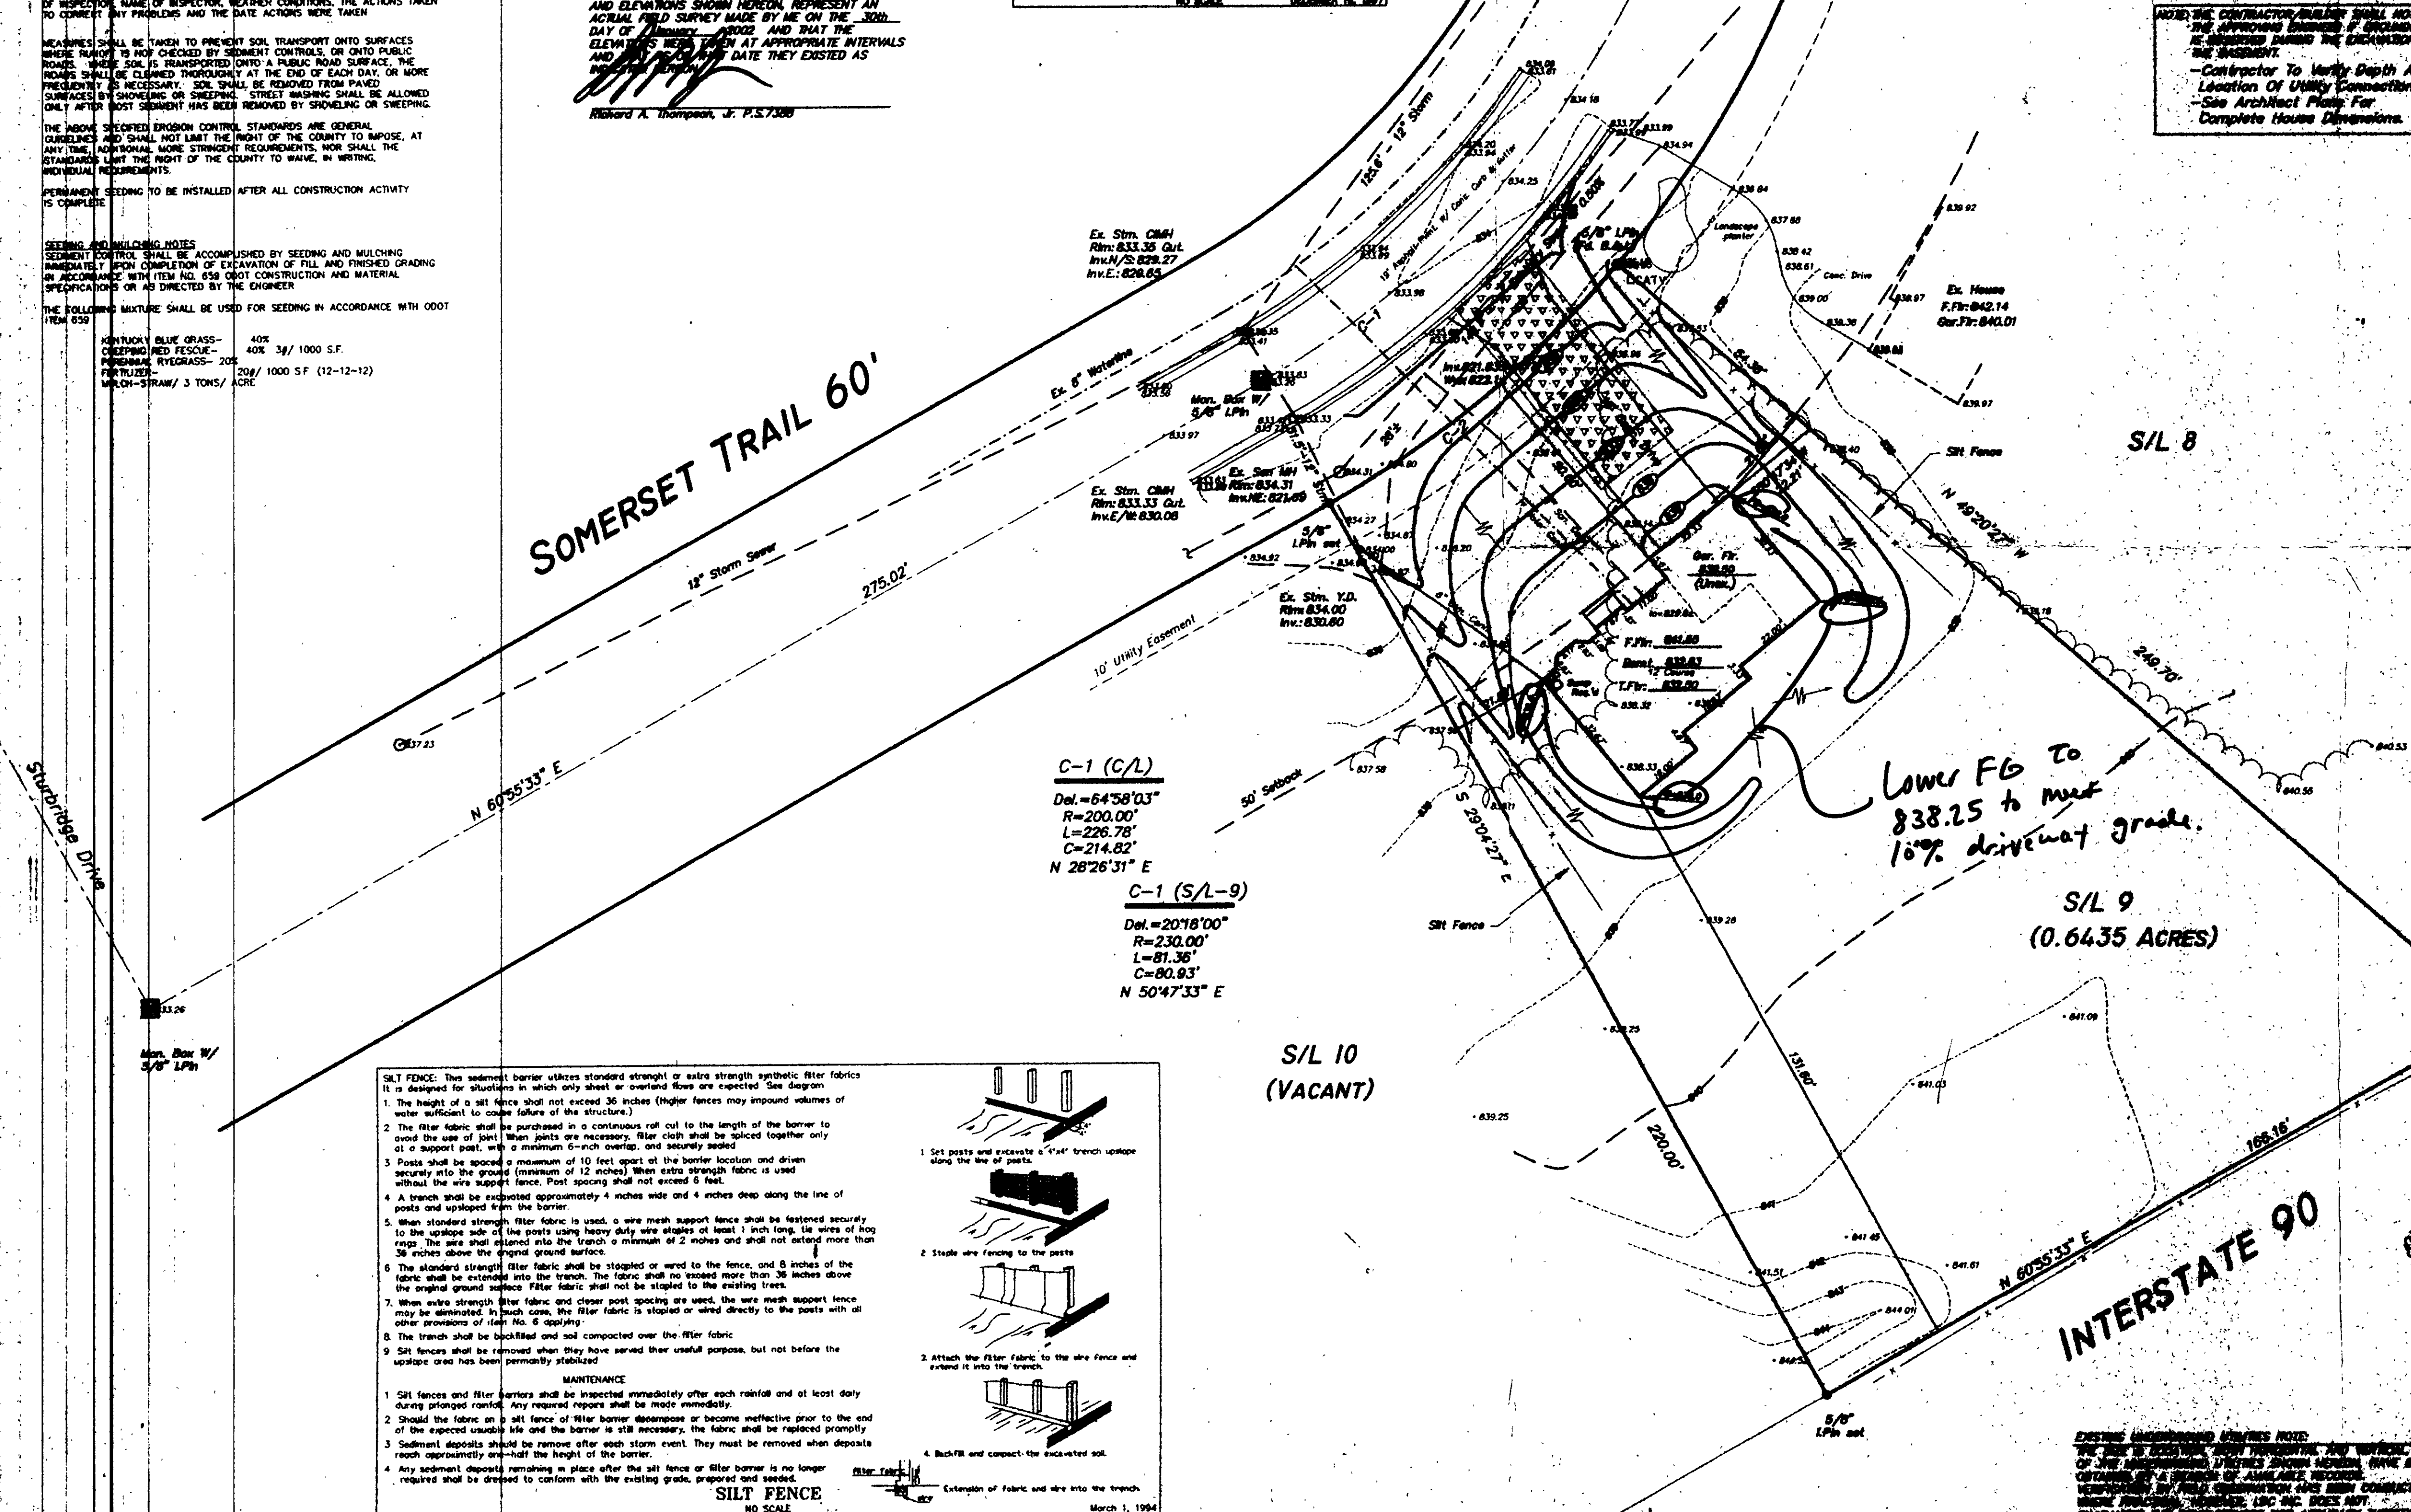

GRAPHIC SCALE



(1954)

NOTE: THE CONTRACTOR/BUILDER SHALL NOTIFY THE APPROVING AGENCIES IF ENCOUNTERED IS REQUIRED DURING THE EXECUTION OF THE EASEMENT.

- Contractor To Verify Depth And Location Of Utility Connections;
- See Architect Plans For Complete House Dimensions.

STIG PLAN

for: Livingstone

7436 Shopping List

9 ~~SECRET~~

4-2 Concordia



LAND DESIGN Consultants
Civil Engineers and Surveyors
10000 Highway 100, Suite 100, Houston, TX 77036
713/465-1100

DESIGN CERTIFICATION

THIS FLAT WAS PURCHASED BY ME, AND IS CURRENTLY IN THE
NAME OF MY FATHER AND MOTHER

Zigzag

CHECK LIST

NEW YORK, N.Y. (AP) — A federal grand jury on Tuesday indicted a man on charges of conspiring to defraud the federal government of \$1.5 million in the case of a failed attempt to buy a shipyard.



"XS BUILT" CREDIT

[illegible]

LEGEND

1. **DATE** _____
 2. **TIME** _____
 3. **LOCATION** _____
 4. **NAME** _____
 5. **ADDRESS** _____
 6. **CITY** _____
 7. **STATE** _____
 8. **ZIP** _____
 9. **PHONE** _____
 10. **FAX** _____
 11. **E-MAIL** _____
 12. **TELETYPE** _____
 13. **TELEFAX** _____
 14. **TELEVISION** _____
 15. **RADIO** _____
 16. **INTERNET** _____
 17. **OTHER** _____
 18. **REMARKS** _____
 19. **SIGNATURE** _____
 20. **DATE** _____
 21. **TIME** _____
 22. **LOCATION** _____
 23. **NAME** _____
 24. **ADDRESS** _____
 25. **CITY** _____
 26. **STATE** _____
 27. **ZIP** _____
 28. **PHONE** _____
 29. **FAX** _____
 30. **E-MAIL** _____
 31. **TELETYPE** _____
 32. **TELEFAX** _____
 33. **TELEVISION** _____
 34. **RADIO** _____
 35. **INTERNET** _____
 36. **OTHER** _____
 37. **REMARKS** _____
 38. **SIGNATURE** _____
 39. **DATE** _____
 40. **TIME** _____
 41. **LOCATION** _____
 42. **NAME** _____
 43. **ADDRESS** _____
 44. **CITY** _____
 45. **STATE** _____
 46. **ZIP** _____
 47. **PHONE** _____
 48. **FAX** _____
 49. **E-MAIL** _____
 50. **TELETYPE** _____
 51. **TELEFAX** _____
 52. **TELEVISION** _____
 53. **RADIO** _____
 54. **INTERNET** _____
 55. **OTHER** _____
 56. **REMARKS** _____
 57. **SIGNATURE** _____
 58. **DATE** _____
 59. **TIME** _____
 60. **LOCATION** _____
 61. **NAME** _____
 62. **ADDRESS** _____
 63. **CITY** _____
 64. **STATE** _____
 65. **ZIP** _____
 66. **PHONE** _____
 67. **FAX** _____
 68. **E-MAIL** _____
 69. **TELETYPE** _____
 70. **TELEFAX** _____
 71. **TELEVISION** _____
 72. **RADIO** _____
 73. **INTERNET** _____
 74. **OTHER** _____
 75. **REMARKS** _____
 76. **SIGNATURE** _____
 77. **DATE** _____
 78. **TIME** _____
 79. **LOCATION** _____
 80. **NAME** _____
 81. **ADDRESS** _____
 82. **CITY** _____
 83. **STATE** _____
 84. **ZIP** _____
 85. **PHONE** _____
 86. **FAX** _____
 87. **E-MAIL** _____
 88. **TELETYPE** _____
 89. **TELEFAX** _____
 90. **TELEVISION** _____
 91. **RADIO** _____
 92. **INTERNET** _____
 93. **OTHER** _____
 94. **REMARKS** _____
 95. **SIGNATURE** _____
 96. **DATE** _____
 97. **TIME** _____
 98. **LOCATION** _____
 99. **NAME** _____
 100. **ADDRESS** _____
 101. **CITY** _____
 102. **STATE** _____
 103. **ZIP** _____
 104. **PHONE** _____
 105. **FAX** _____
 106. **E-MAIL** _____
 107. **TELETYPE** _____
 108. **TELEFAX** _____
 109. **TELEVISION** _____
 110. **RADIO** _____
 111. **INTERNET** _____
 112. **OTHER** _____
 113. **REMARKS** _____
 114. **SIGNATURE** _____
 115. **DATE** _____
 116. **TIME** _____
 117. **LOCATION** _____
 118. **NAME** _____
 119. **ADDRESS** _____
 120. **CITY** _____
 121. **STATE** _____
 122. **ZIP** _____
 123. **PHONE** _____
 124. **FAX** _____
 125. **E-MAIL** _____
 126. **TELETYPE** _____
 127. **TELEFAX** _____
 128. **TELEVISION** _____
 129. **RADIO** _____
 130. **INTERNET** _____
 131. **OTHER** _____
 132. **REMARKS** _____
 133. **SIGNATURE** _____
 134. **DATE** _____
 135. **TIME** _____
 136. **LOCATION** _____
 137. **NAME** _____
 138. **ADDRESS** _____
 139. **CITY** _____
 140. **STATE** _____
 141. **ZIP** _____
 142. **PHONE** _____
 143. **FAX** _____
 144. **E-MAIL** _____
 145. **TELETYPE** _____
 146. **TELEFAX** _____
 147. **TELEVISION** _____
 148. **RADIO** _____
 149. **INTERNET** _____
 150. **OTHER** _____
 151. **REMARKS** _____
 152. **SIGNATURE** _____
 153. **DATE** _____
 154. **TIME** _____
 155. **LOCATION** _____
 156. **NAME** _____
 157. **ADDRESS** _____
 158. **CITY** _____
 159. **STATE** _____
 160. **ZIP** _____
 161. **PHONE** _____
 162. **FAX** _____
 163. **E-MAIL** _____
 164. **TELETYPE** _____
 165. **TELEFAX** _____
 166. **TELEVISION** _____
 167. **RADIO** _____
 168. **INTERNET** _____
 169. **OTHER** _____
 170. **REMARKS** _____
 171. **SIGNATURE** _____
 172. **DATE** _____
 173. **TIME** _____
 174. **LOCATION** _____
 175. **NAME** _____
 176. **ADDRESS** _____
 177. **CITY** _____
 178. **STATE** _____
 179. **ZIP** _____
 180. **PHONE** _____
 181. **FAX** _____
 182. **E-MAIL** _____
 183. **TELETYPE** _____
 184. **TELEFAX** _____
 185. **TELEVISION** _____
 186. **RADIO** _____
 187. **INTERNET** _____
 188. **OTHER** _____
 189. **REMARKS** _____
 190. **SIGNATURE** _____
 191. **DATE** _____
 192. **TIME** _____
 193. **LOCATION** _____
 194. **NAME** _____
 195. **ADDRESS** _____
 196. **CITY** _____
 197. **STATE** _____
 198. **ZIP** _____
 199. **PHONE** _____
 200. **FAX** _____
 201. **E-MAIL** _____
 202. **TELETYPE** _____
 203. **TELEFAX** _____
 204. **TELEVISION** _____
 205. **RADIO** _____
 206. **INTERNET** _____
 207. **OTHER** _____
 208. **REMARKS** _____
 209. **SIGNATURE** _____
 210. **DATE** _____
 211. **TIME** _____
 212. **LOCATION** _____
 213. **NAME** _____
 214. **ADDRESS** _____
 215. **CITY** _____
 216. **STATE** _____
 217. **ZIP** _____
 218. **PHONE** _____
 219. **FAX** _____
 220. **E-MAIL** _____
 221. **TELETYPE** _____
 222. **TELEFAX** _____
 223. **TELEVISION** _____
 224. **RADIO** _____
 225. **INTERNET** _____
 226. **OTHER**

BENCHMARK

CONCORD TOWNSHIP ZONING OFFICE

0202 - 1045

2-5-62

SUBJECT TO APPROVAL BY:

~~W.D. Co. Sanitary Engineer~~

D. Lake Co. Eng. Dept.

☐ Loko Co. Planning Comm.
☒ Loko Co. Building Dept.

✓ Lake Co. Soil & Water Cons. Dist.

**2 WORKING DAYS
BEFORE YOU DIG**

CALL TOLL FREE 800-362-2764

Grading Plan Approved
as shown and/or noted
JAMES R. GILLS, P.E.
Lake County Engineer

By GH Date 2-26-01

See note.

ROOF DRAINS
SHALL BE DISCHARGED

SHALL DISCHARGE
TO SPLASH BLOCKS

DESTROY UNCLASSIFIED COPIES NOTE:
 THE U.S. GOVERNMENT HAS DETERMINED THAT COPIES OF THIS DOCUMENT ARE NOT NECESSARY FOR THE PROTECTION OF NATIONAL DEFENSE. IT IS THEREFORE AUTHORIZED TO BE DESTROYED. COPIES OF THIS DOCUMENT ARE BEING DESTROYED IN ACCORDANCE WITH THE ABOVE. NO OTHER ACTION IS REQUIRED.