

SITE PLAN

FOR THE


M.M. BOGART DEVELOPMENT CORP.
CONCORD TOWNSHIP
LAKE COUNTY, OHIO

"I, the undersigned hereby certify that this topography, indicated by 5', 1' or 2' contours, and elevations shown hereon represent an actual field survey made by me on the 9 day of May, 1990 and that the elevations were taken at appropriate intervals and that as of that date they existed as indicated hereon."

David K. Mostoller
DAVID K. MOSTOLLER R.S.#6949



KNIGHTSBRIDGE SUBDIVISION NO. 1
VOL. 1 "Y" PAGE 52

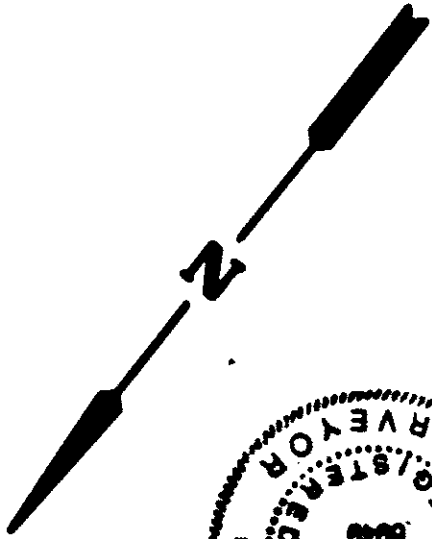


- LEGEND
- SANITARY MANHOLE
 - STORM MANHOLE
 - INLET OR CATCH BASIN
 - HYDRANT
 - EXISTING CONTOUR
 - PROPOSED CONTOUR
 - EXIST. ELEV. 100.0
 - PROP. ELEV. 100.0
 - AS BUILT ELEVATION
 - DIRECTION OF DRAINAGE

* SEE ATTACHED NOTE.

Grading Plan Approved
as shown and/or noted
THOMAS P. GILL
Lake County Engineer
By *TPG*
Date: 5/29/90
SCALE: 1"=30'
DATE: MAY, 1990

PREPARED BY:
FISHER & ASSOCIATES, INC.
ENGINEERS AND CONSULTANTS

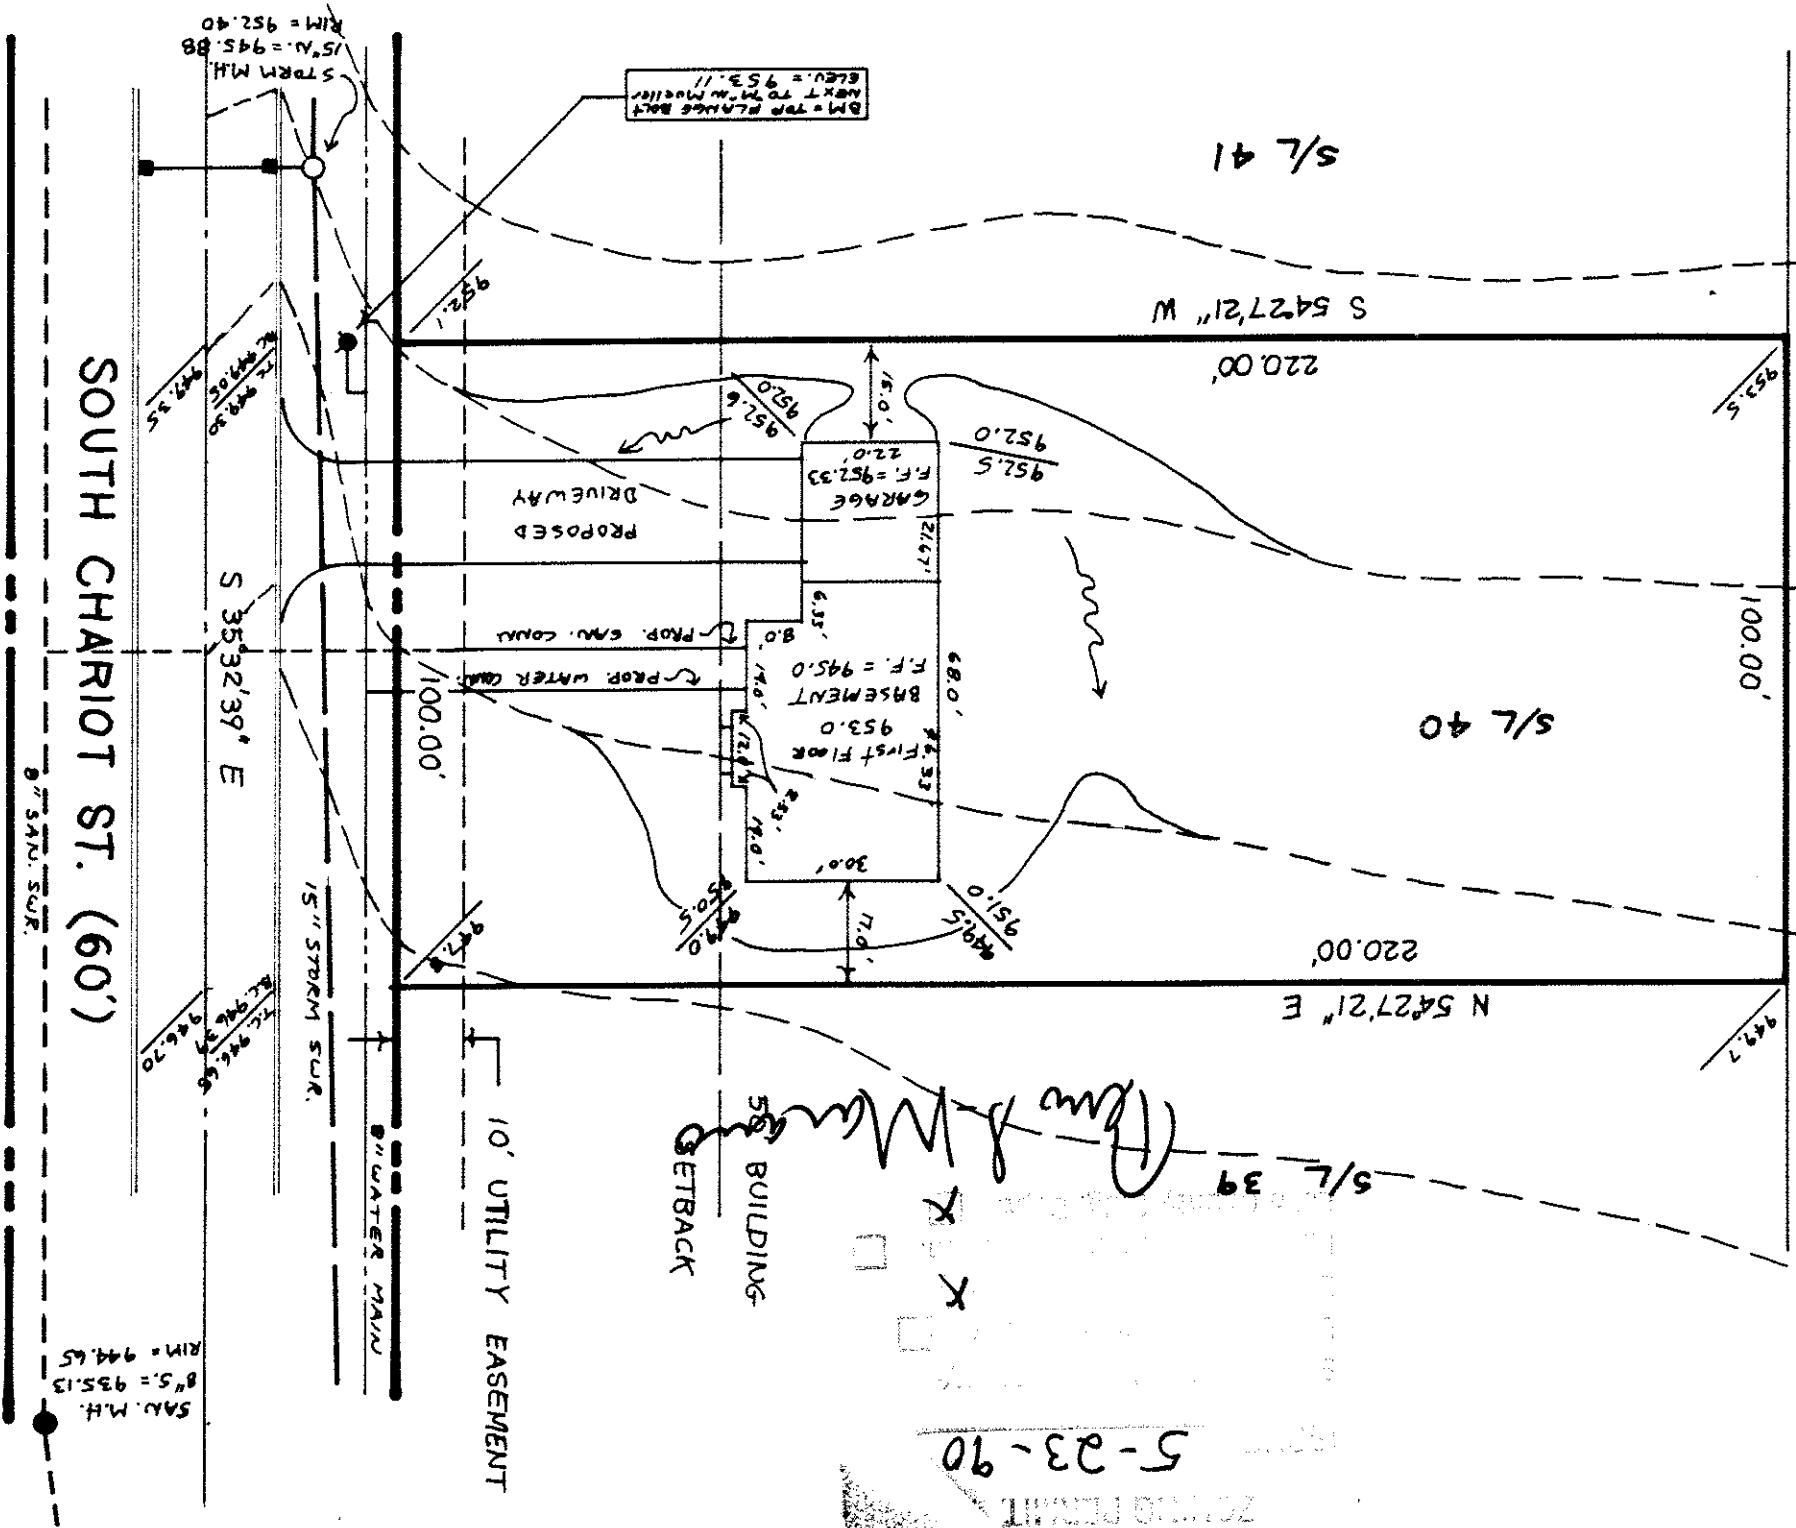

5-23-90

#6473

X-9004