

SITE PLAN

COLUMBIA TOWNSHIP, LANE COUNTY, OHIO

for: 20th CENTURY CONSTRUCTION
853 JONNYCATE ROAD, MEDINA, OHIO

OWNER: 20th CENTURY CONSTRUCTION
CLIENT: 853 JONNYCATE ROAD, MEDINA, OHIO
ADDRESS: STREET CITY ZIP

SUBDIVISION: 1
SUBLOT NO.:
VOL. PG. 1
NAME: 20th CENTURY CONSTRUCTION
STREET: STREET
LOT: TRACT
VOLUME: PAGE
PERM. PARCEL NO.: STREET

LEGEND
SANITARY MANHOLE
STORM MANHOLE
INLET OR CATCH BASIN
HYDRANT
EXISTING CONTOURS
PROPOSED CONTOURS
EXIST. ELEV. 100.0
PROP. ELEV. 100.0
WATER VALVE (GAS)
WATER METER (GAS)
AS BUILT ELEVATION
INDICATES DIRECTION OF SURFACE DRAINAGE

REMARKS
ALL BOUNDARY DATA SHOWN WAS OBTAINED FROM (DEEDS, RECORDED SUBDIVISION PLAT OR OTHER PUBLIC RECORDS)
LOCATIONS AS SHOWN OF ADJACENT WELLS AND SEPTIC TANKS OBTAINED FROM LAKE COUNTY HEALTH DEPARTMENT


DESIGN CERTIFICATION
THIS PLAT WAS PREPARED BY ME, AND IS CORRECT TO THE BEST OF MY KNOWLEDGE AND BELIEF.

CHECK LIST
NO. OF BEDROOMS
DIMENSIONS
BEARINGS
SITE TO NEAREST STREET
SUBLOT NO. PARCEL NO.
SURROUNDING OWNERS
BLDG. DIMENSIONS FIN. GR.
BLDG. TIES FLR. GRADES
CONCRETE FLOOR THICKNESS
SIDEWALK TYPE AND THICKNESS
CULVERT TYPE, DIA. LENGTH
ROCK OUTCROPPINGS
WATER MAIN SIZE, LOCATION
SAN. SEWER SIZE % GR. LOC.
SAN. MH. CAST. ELEV. INV. ELEV.
SAN. CONN. SIZE, LOC. DEPTH
STORM SEWER SIZE % GR. LOC.
STORM MH. CAST. ELEV. INV. ELEV.
PAV'T TYPE GRADE CURBS
GAS LINE LOC. SIZE PRESSURE
SEPTIC TANK LOCATION & DUPLICATION AREA
WELL LOCATION
ISOLATION RADIUS FROM WELL

PLAN PREPARED BY:
BABCOCK • JONES & ASSOCIATES, INC.
PAINESVILLE OHIO
DRAWN BY: 1/11/87
CHK'D: 1/11/87
CREW CHIEF: 1/11/87
SCALE: 1" = 20'
DATE: 1/11/87
PHONE NO.: 357-1811
DRAWING NO.: 87-247-11

"AS BUILT" CERTIFICATION
I, HEREBY CERTIFY THAT THE CIRCLED GRADES ARE EXISTING FINISH GRADES CHECKED IN THE FIELD ON 1/11/87, AND ARE CORRECT TO THE BEST OF MY KNOWLEDGE AND BELIEF.

REGISTERED SURVEYOR
REG. NO.

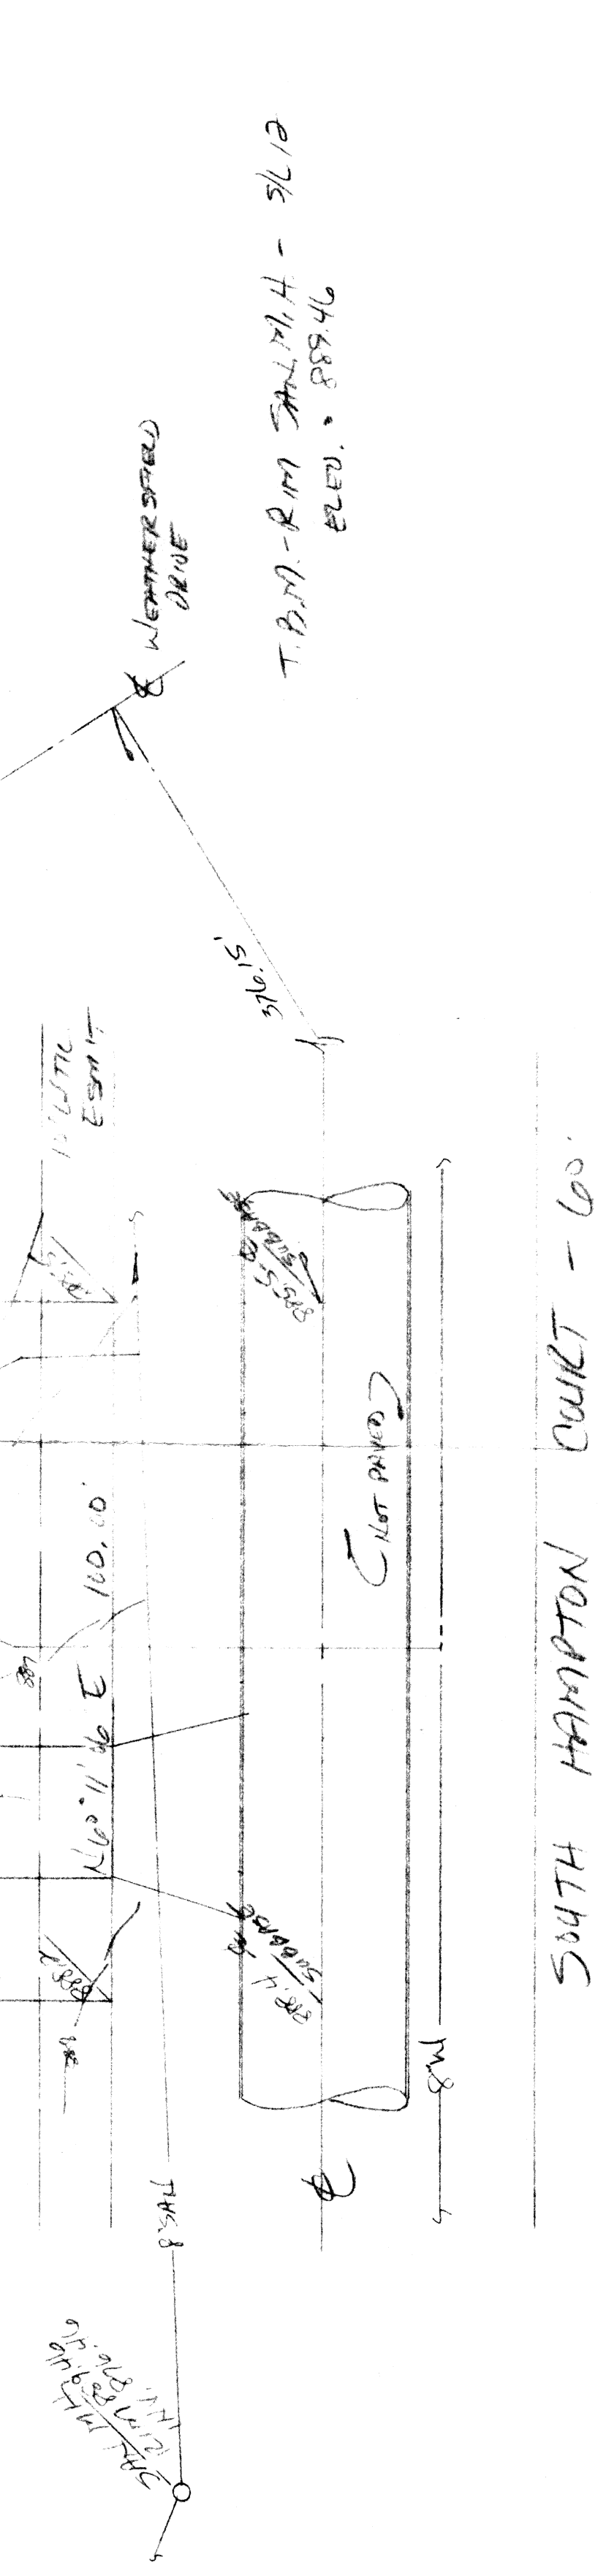

T.B.M. - R.M. S.M. 11.4 - 5/12
ELEV. - 889.46

SOUTH HAMPTON COURT - 60'