
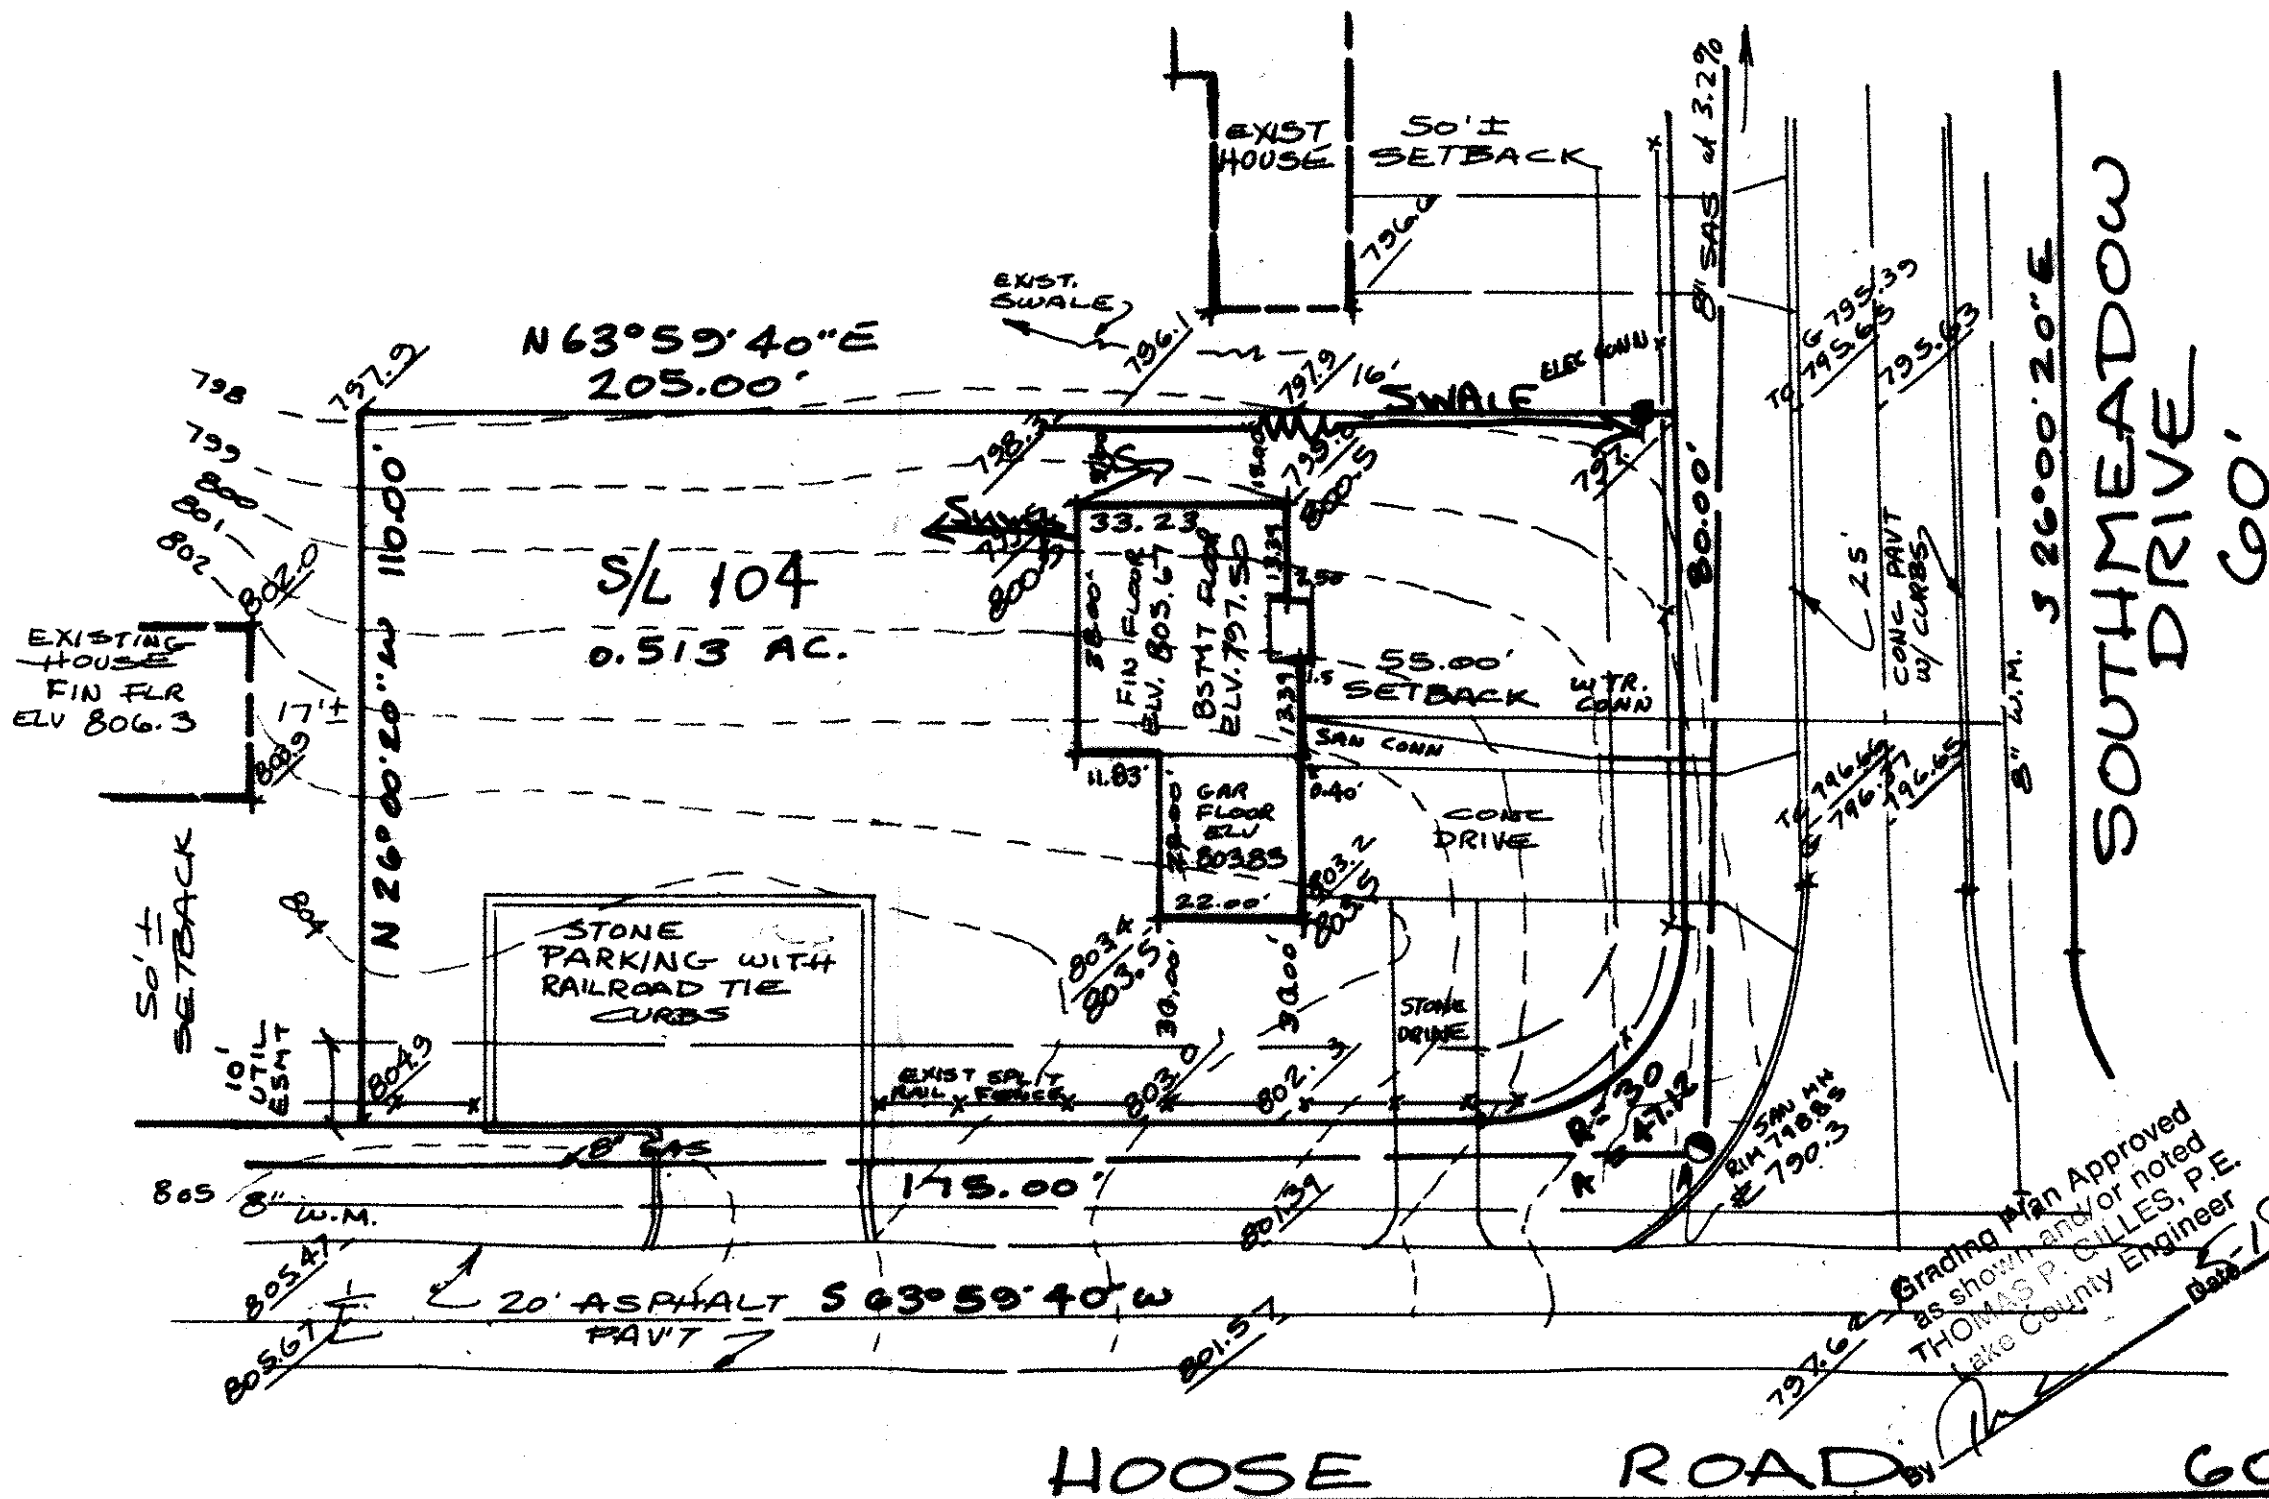


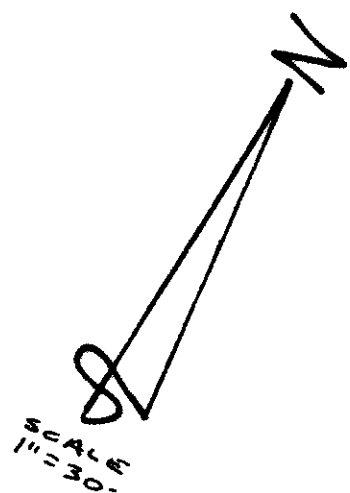

ZONING PERMIT #4483
 ISSUED 5-14-82
 SUBJECT TO APPROVAL BY:
 Lake County Sanitary Eng. ☐
 Lake County Eng. Dept. ☒
 Lake County Planning Comm. ☐
 Lake County Bldg. Dept. ☒
Teno S Marano

DESIGN CERTIFICATION
 THIS PLAT WAS PREPARED BY ME,
 AND IS CORRECT TO THE BEST OF
 MY KNOWLEDGE AND BELIEF.
PS# 5244
 REG. SURVEYOR NO.

AS BUILT CERTIFICATION
 I HEREBY CERTIFY THAT THE CIRCLED GRADES
 ARE EXISTING FINISH GRADES CHECKED IN THE
 FIELD ON _____ AND THAT
 SURVEY IS CORRECT TO THE BEST OF MY
 KNOWLEDGE AND BELIEF.
 REG. SURVEYOR NO.

COLPETZER · WOODS
 CONSULTANTS, INC.
 9470 MENTOR AVENUE • MENTOR, OHIO 44066 • (216) 357-7569

DATE 5.3.82
 SCALE 1"=30'
 DRAWN BY PJB
 CHKD BY PJB
 JOB NO 82-
 FS PG

SITE PLAN
 for WM. C. KAY, BLDGS., INC. of
 S/L 104 IN CONCORD HILLS SUBD# 2
 VOL X - PG 11
 CONCORD TWP - LAKE COUNTY - OHIO