


CONCORD TOWNSHIP ZONING OFFICE  
LAND PERMIT # 1203-11419  
ISSUED 12/25/03  
SUBJECT TO APPROVAL BY:  
☒ Lake County Engineer  
☒ Lake County Eng. Dept.  
☒ Lake Co. Planning Comm.  
☒ Lake Co. Building Dept.  
☒ Lake Co. Soil & Water Cons. Dist.

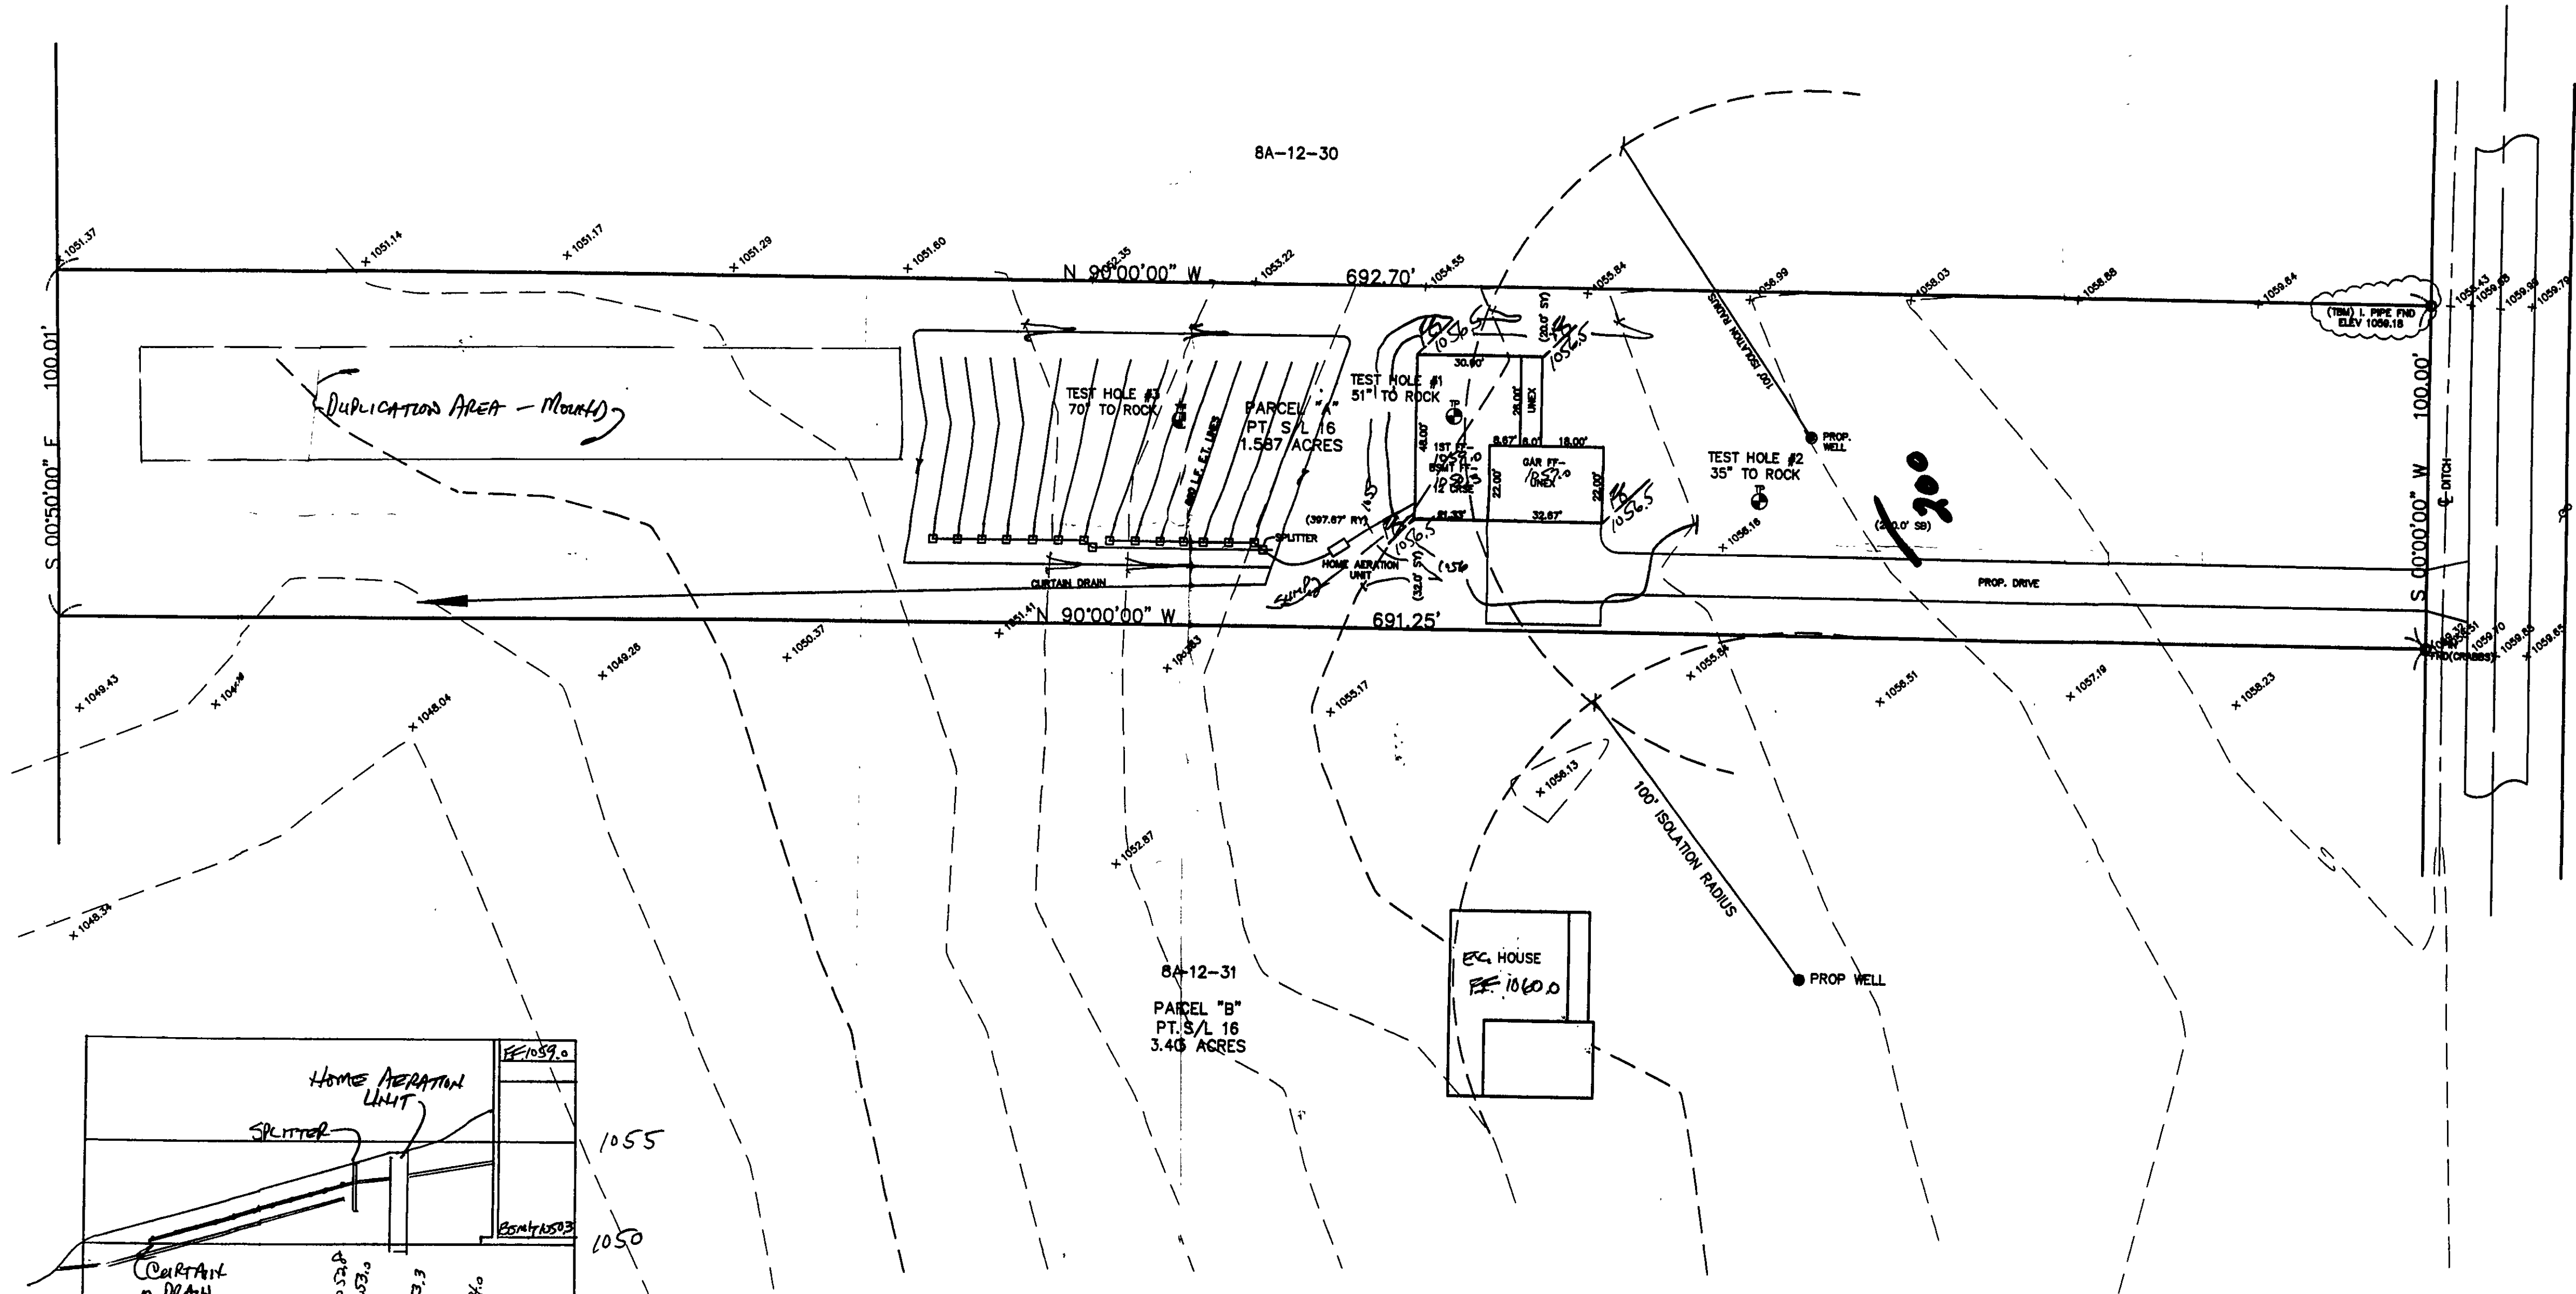


SOUTH ORCHARD ROAD - 40'

REVIEWED AND ACCEPTED  
LAKE COUNTY GENERAL  
HEALTH DISTRICT  
Date 12-18-03 By: [Signature]

SEWAGE DISPOSAL PERMIT MUST BE  
OBTAINED BY A LAKE COUNTY LICENSED  
INSTALLER BEFORE INSTALLATION IS  
STARTED  
"I, the undersigned hereby certify that  
this topography indicated by 6", 1', or 2'  
contours, and elevations shown hereon  
represent an actual field survey made by  
me on the 18th day of April, 2003  
and that the elevations were taken at  
appropriate intervals and that as of that  
date they existed as indicated hereon."

Name [Signature] #6343  
Reg. No.

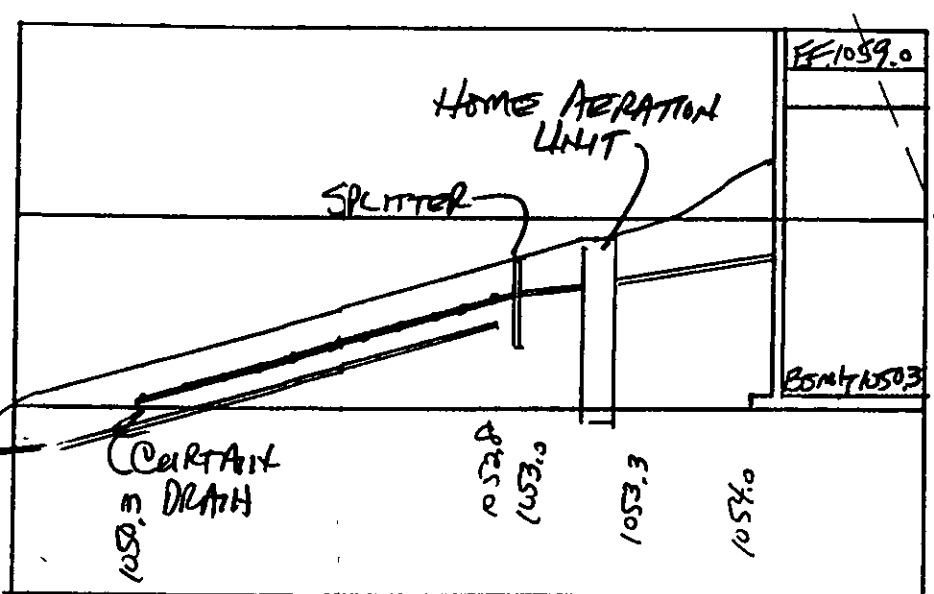

HYDRAULIC PROFILE  
HORIZ. 1" = 30' VERT. 1" = 5'

TBM - 2" IRON PIPE  
ELEV - 1059.18

EXISTING UTILITIES NOTE:  
THE SIZE AND LOCATION, BOTH HORIZONTAL AND VERTICAL  
OF THE UNDERGROUND UTILITIES SHOWN HEREON, HAVE BEEN  
OBTAINED BY A SEARCH OF AVAILABLE RECORDS.  
VERIFICATION BY FIELD OBSERVATION HAS BEEN CONDUCTED  
WHERE PRACTICAL, HOWEVER, BABCOCK, JONES AND ASSOCIATES  
INC. DOES NOT GUARANTEE THE COMPLETENESS NOR ACCURACY  
THEREOF.



REV. NO.	DESCRIPTION	DATE	BY	CHK'D
1	ADDED TEST HOLES	4/24/03	H.J.	H.J.
2	REVISED CONTOURS	4/24/03	B.P.	H.J.
3	REVISED NEW HOUSE	12/16/03	N.S.	H.J.
4	REVISIONS FOR L.C. HEALTH DEPT	12/18/03	HJ	HJ

**BABCOCK, JONES AND ASSOCIATES, INC**  
CIVIL ENGINEERS - SURVEYORS - LAND PLANNERS  
PAINESVILLE OHIO 44077

DATE 4/21/03  
DESIGN BY HJ  
DRAWN BY NS  
APPROVED BY HJ

SITE PLAN  
FOR  
**SHAMROCK CONSTRUCTION**  
CONCORD TOWNSHIP LAKE COUNTY STATE OF OHIO

SCALE 1" = 30'  
JOB NO 03-058-6  
SHEET 1 OF 1